

CERTIFIED LAND CORNER RESTORATION

Index No. N11

State of Wisconsin }
County of Forest } ss.

History of original corner establishment:

Original subdivision by James L. Nowlin Sept. 11 - Sept. 21, 1865

Cedar 7 S71 1/2 W 3 Lks.
Cedar 12 N20E 20 Lks.

I Thomas R. Arnott, do hereby certify that on the 16th day of September, 1975, I found evidence of the 1/4 corner of sections 16 & 21 Township 35, North, Range 13 E, Fourth Principal Meridian, as described hereon; and that from this evidence I established a new monument and accessories as described hereon to perpetuate the original location of this corner.

Description of corner evidence found:

2" iron pipe 5' long with brass cap offset 33 feet south of corner set by C.E. Walker in 1940

Resident witnesses:


Herbert Wagoner

Description of monument and accessories I established to perpetuate the original location of this corner.


Left monument set by Walker set RR spike at location of corner

Ties:

Cedar 10" S58 1/2 W 65.70 feet
Walker monument S1E 33.00 feet

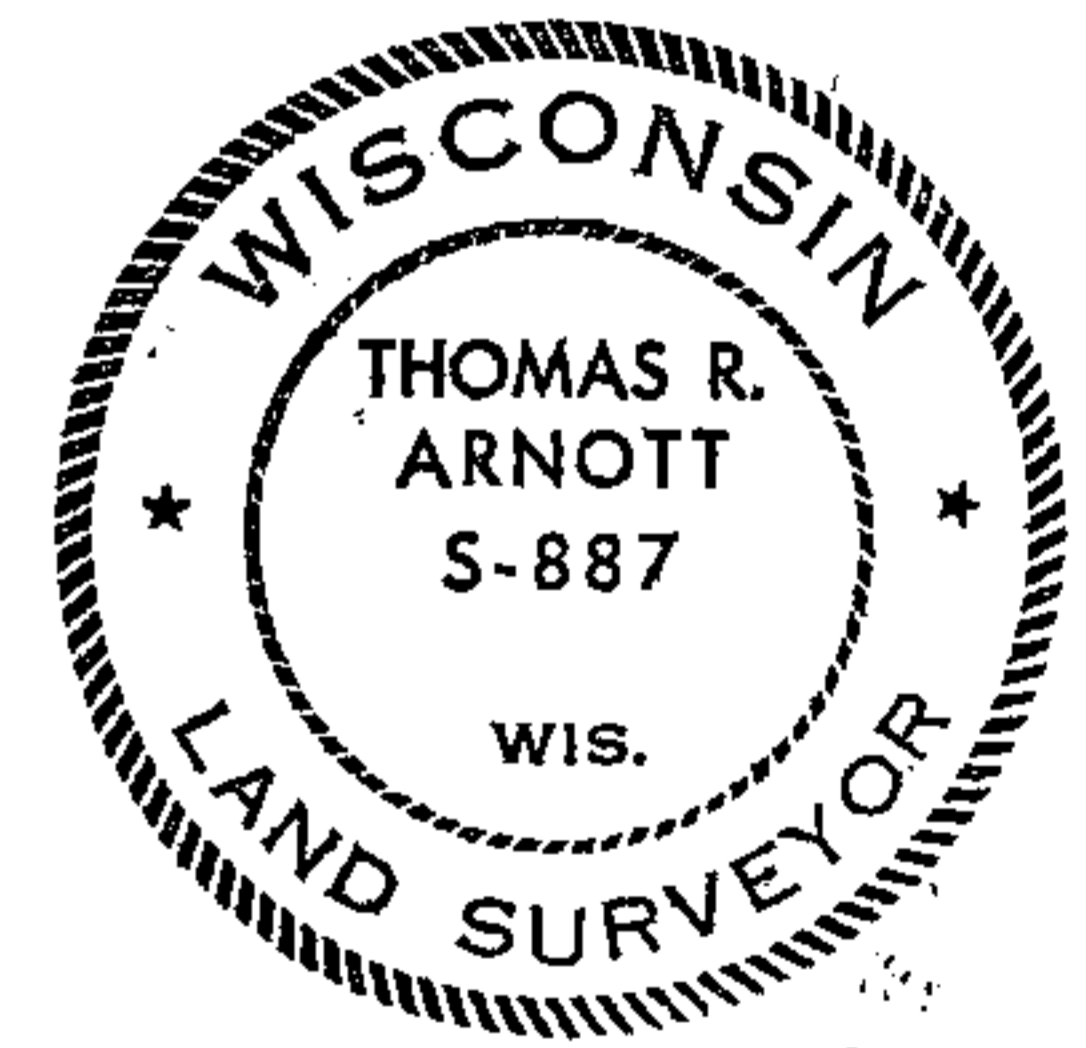

FORM 985 K. C. MILLER CO., MILWAUKEE

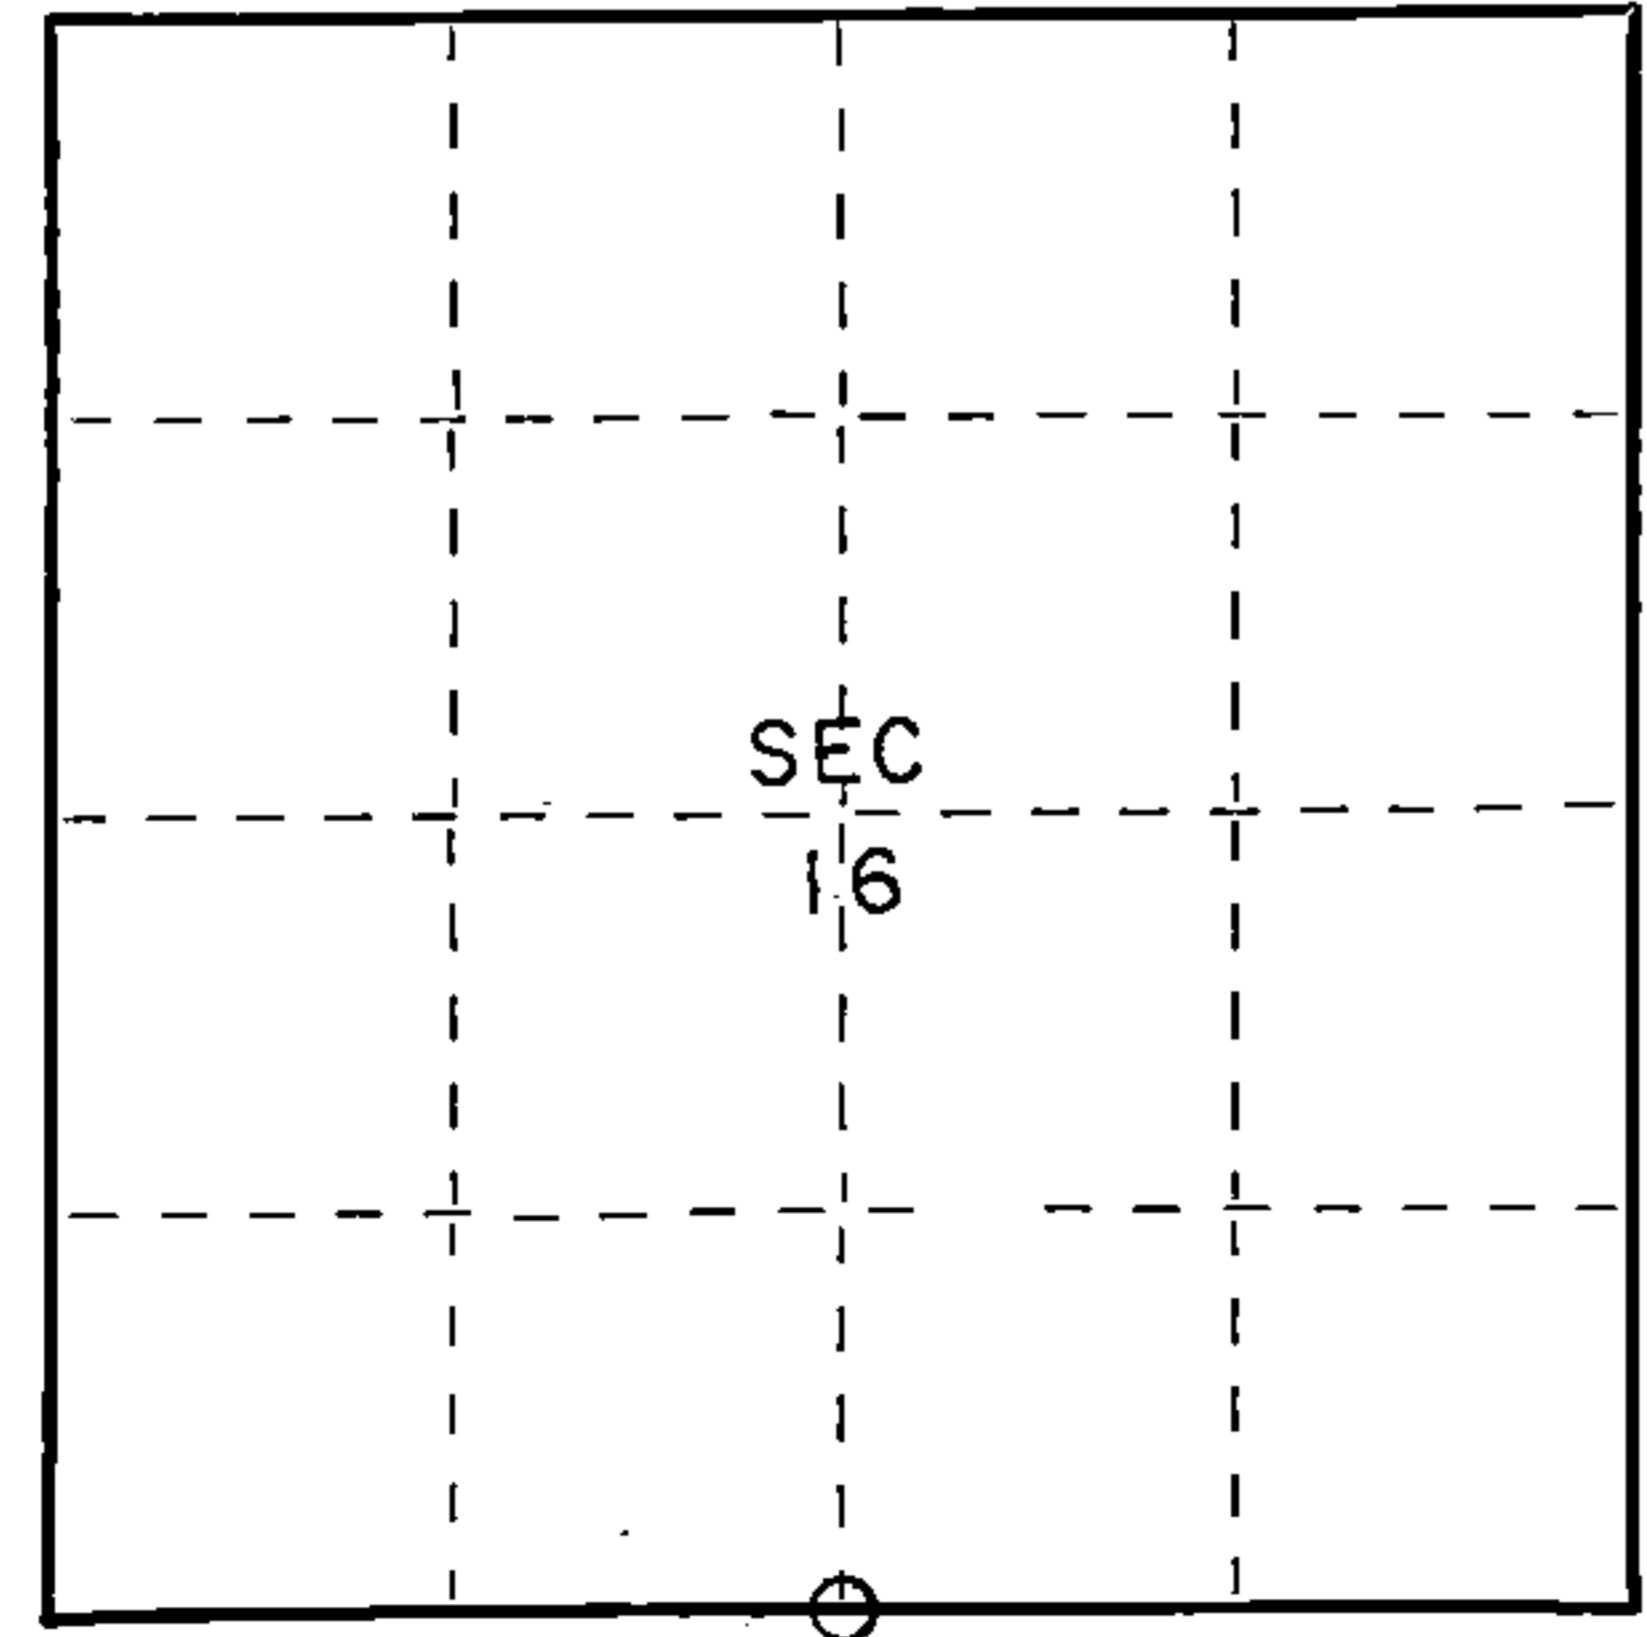

○ = Corner monument restored.

Dated at Grandon, Wis., this 30th day of October, 1975.

Signature Thomas R. Arnott Title Land Surveyor Registration No. S-887
(County Surveyor, Registered Land Surveyor, or other duly authorized official)

Office of Register of Deeds, County of Forest, I hereby certify that the within instrument was filed in this office for record on the 30th day of October, 1975 at 1 o'clock P.M.

Engine Stutzman (Register of Deeds) Document Number 108107

By _____ Deputy

43513160020