


CERTIFIED LAND CORNER RESTORATION

Index No. 43513170000

State of Wisconsin }
County of Forest } ss:

I Thomas R. Arnott, do hereby certify that on the 16 th day of September, 1975, I found evidence of the section corner of sections 16, 17, 20 & 21 Township 35, North, Range 13 E, Fourth Principal Meridian, as described hereon; and that from this evidence I established a new monument and accessories as described hereon to perpetuate the original location of this corner.

Resident witnesses:
Herbert Wagoner

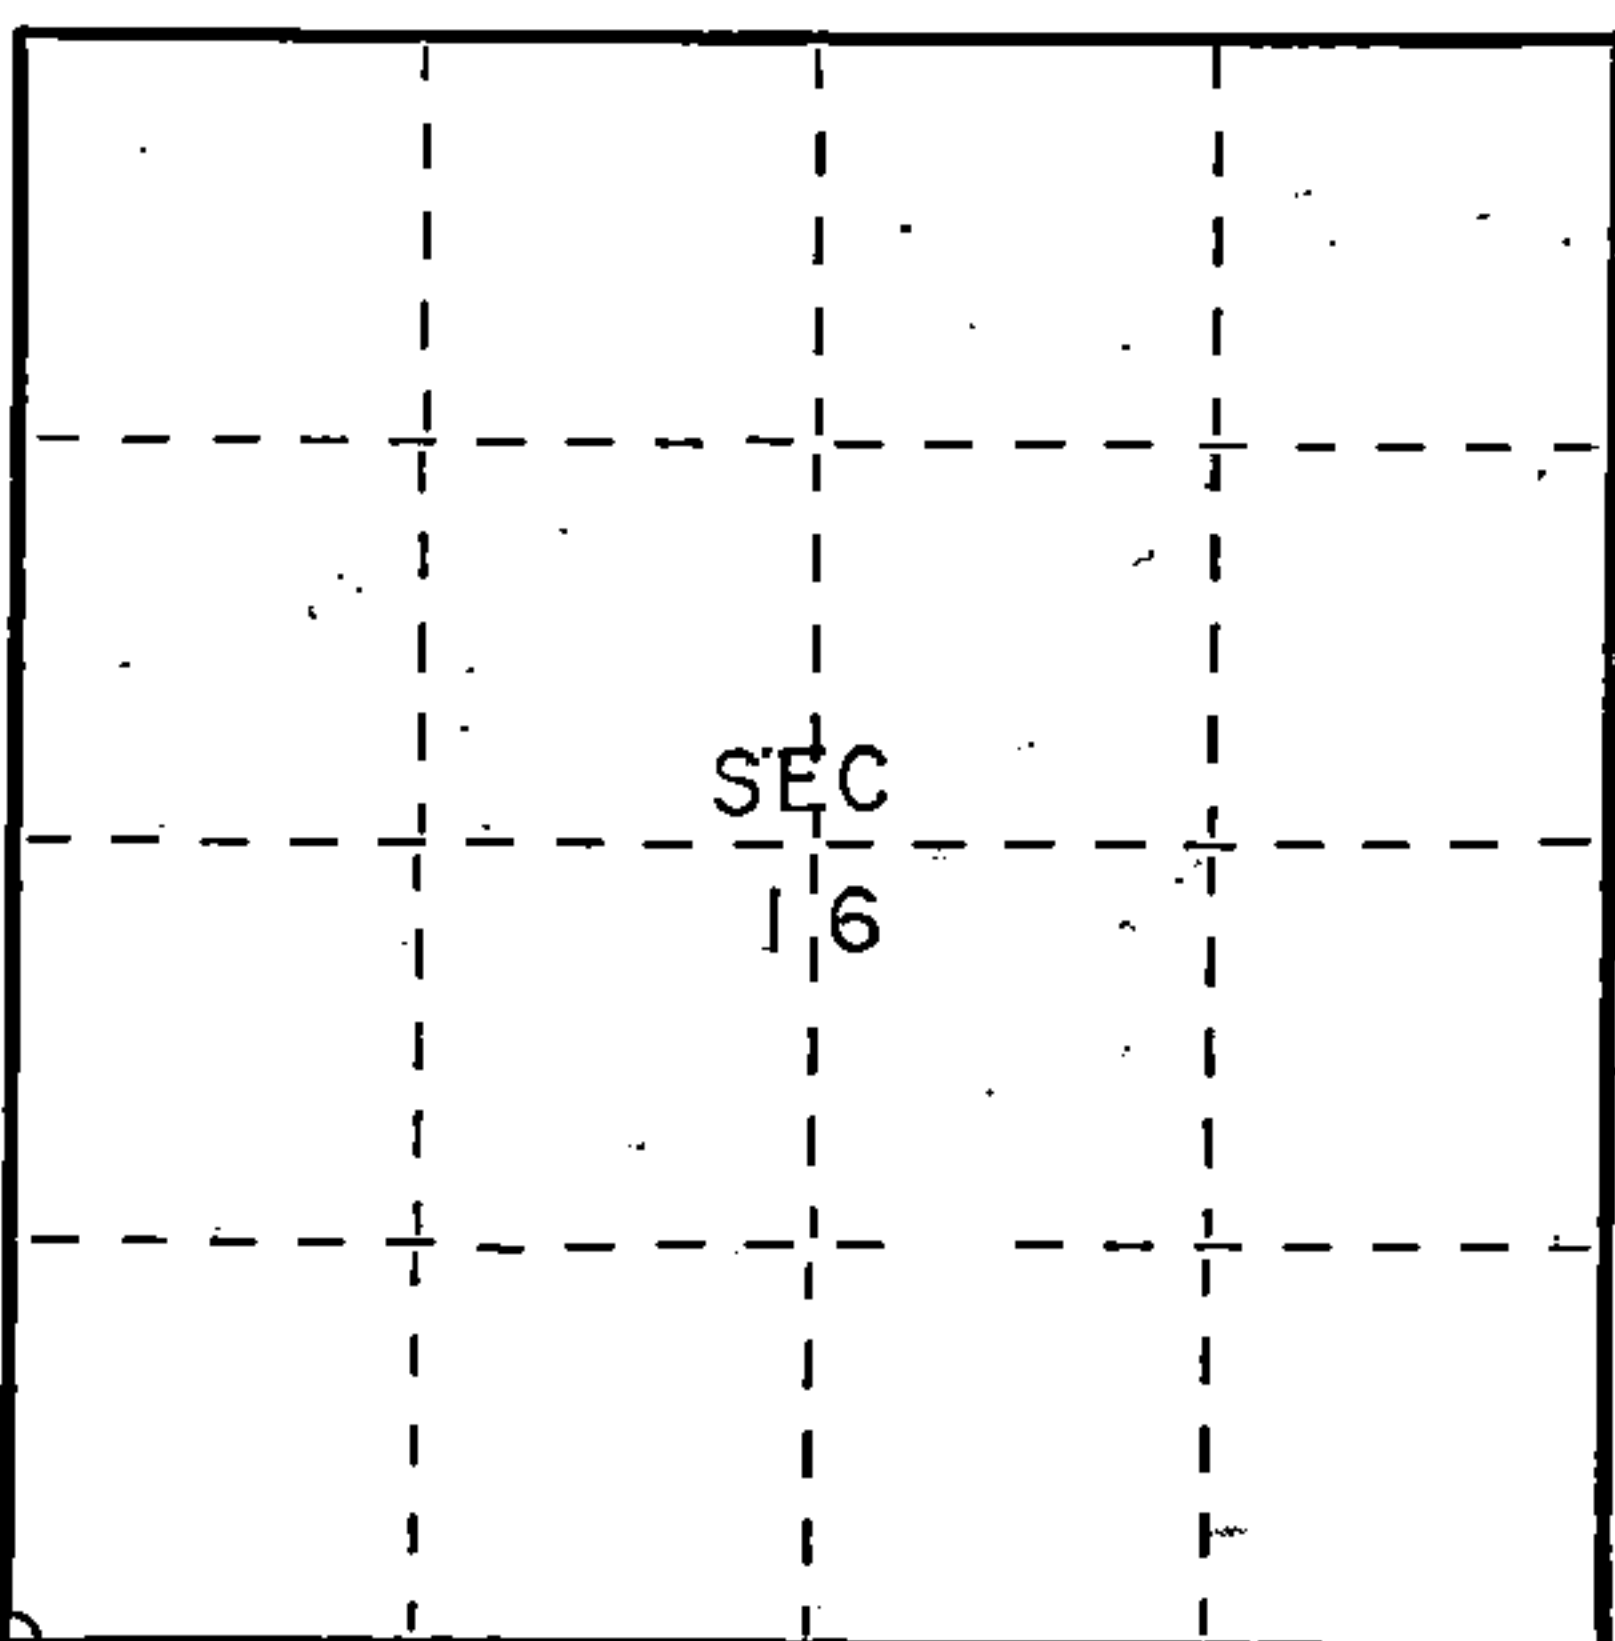

○ = Corner monument restored.

History of original corner establishment:

Original subdivision by James L. Nowlin Sept. 11 - Sept. 22, 1865

Birch 10 N84E 8 Lks.
Hemlock 36 N6W 35 Lks.


Description of corner evidence found:

- 2" iron pipe 5' long with brass cap offset 25.10 feet south set by C.E. Walker in 1940
- 1" iron pin 5" below road grade at location of corner

Description of monument and accessories I established to perpetuate the original location of this corner.

Left monument set by Walker
left 1" iron pin

Ties:
Walker monument S2E 25.10 feet
power pole S60W 50.54 feet

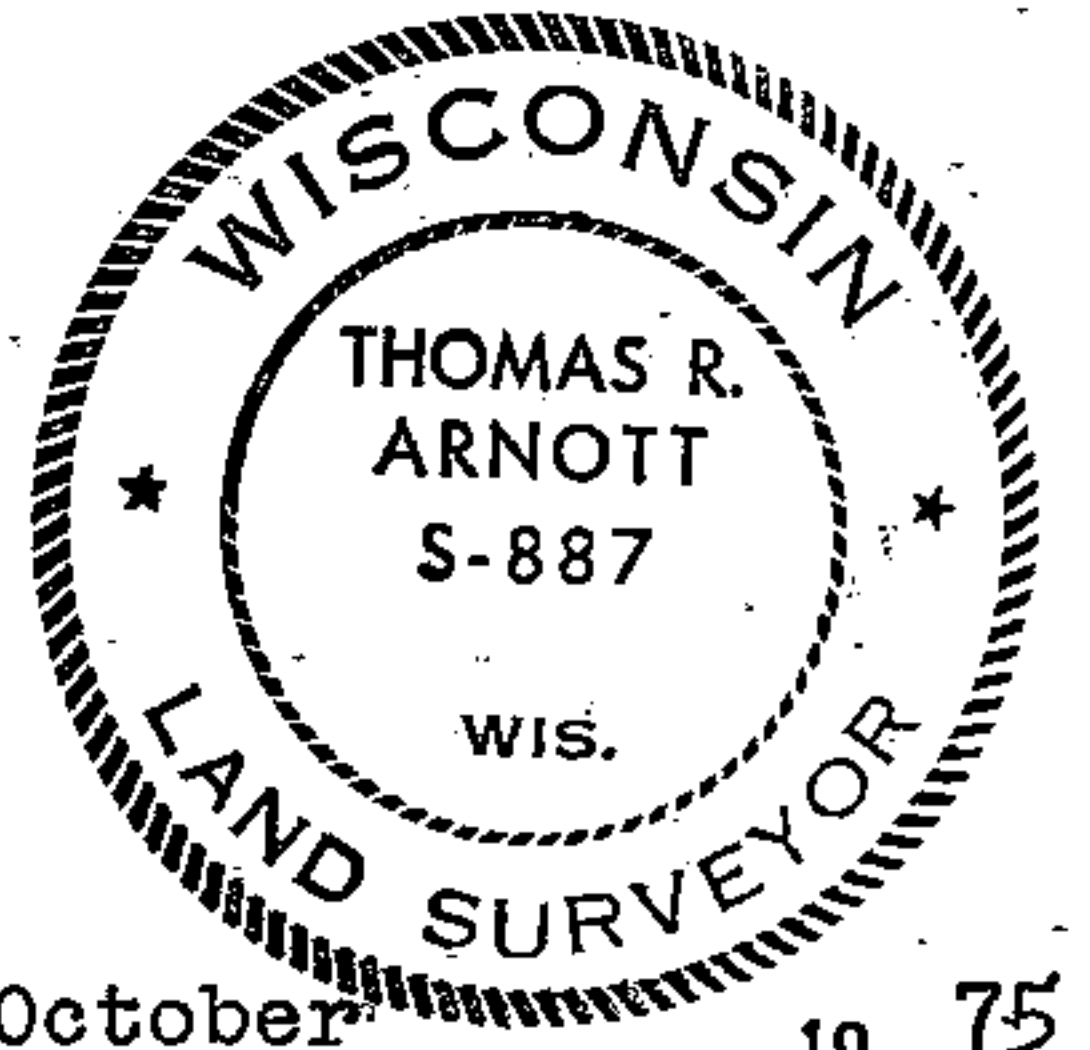

Dated at Crandon, Wis., this 29th day of October, 1975

Signature Thomas R. Arnott Title Land Surveyor Registration No. S-887
(County Surveyor, Registered Land Surveyor, or other duly authorized official)

Office of Register of Deeds, County of Forest, I hereby certify that the within instrument was filed in this office for record on the 29th day of October, 1975 at 1 o'clock P. M.

Eugene Staszny
(Register of Deeds)
By _____ Deputy

Document Number 108092

FORM 985 M. C. MILLER CO., MILWAUKEE