

CERTIFIED LAND CORNER RESTORATION


Index No. R-77

State of Wisconsin }  
County of Forest } ss.

I Thomas R. Arnott, do hereby certify that on the 15 day of Nov., 1976, I found evidence of the 1/4 corner of sec. 20 & 29 Township 35, North, Range 13 E, Fourth Principal Meridian, as described hereon; and that from this evidence I established a new monument and accessories as described hereon to perpetuate the original location of this corner.

Resident witnesses:  
\_\_\_\_\_  
\_\_\_\_\_  
\_\_\_\_\_

FORM 985 H. C. MILLER CO., MILWAUKEE

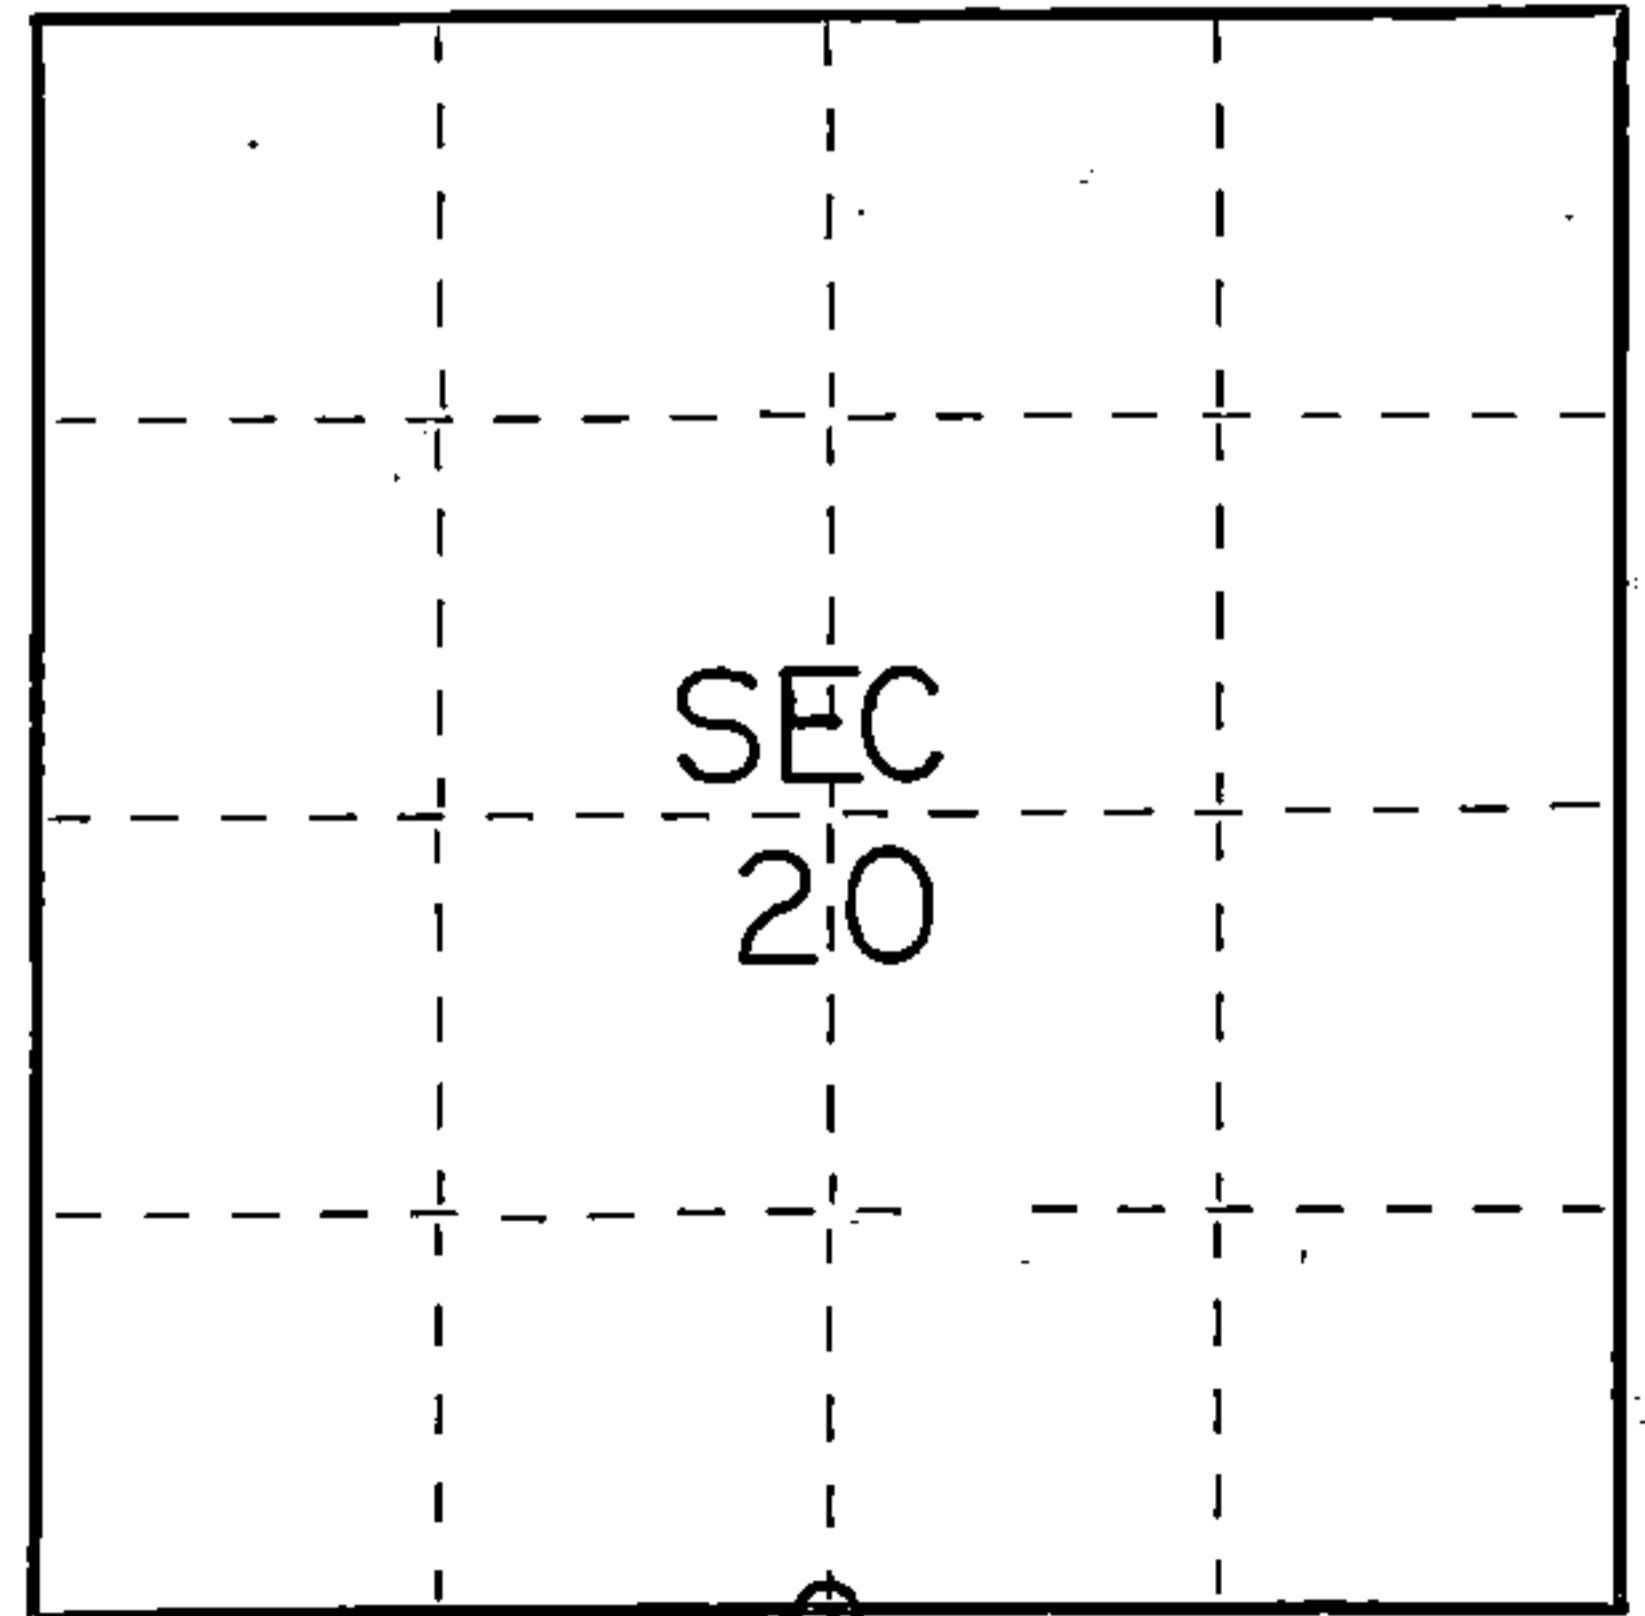

○ = Corner monument restored.

History of original corner establishment:

Original survey by James L. Nowlin - Sept. 11 - Sept. 21, 1865.

Hemlock 12 S26E 13 Lks.  
Fir. 10 N15W 23 Lks.

Description of corner evidence found:

2" iron pipe 5' long with brass cap set by C.E. Walker in 1940.

Description of monument and accessories I established to perpetuate the original location of this corner.

Left monument set by Walker.

Ties:

Maple 8 S47E 11.16 feet  
Maple 10 S73W 32.35 feet.



Dated at Crandon, Wis., this 26 day of Nov., 1976.

Signature Thomas Arnott Title Surveyor Registration No. S-887  
(County Surveyor, Registered Land Surveyor, or other duly authorized official)

Office of Register of Deeds, County of Forest, I hereby certify that the within instrument was filed in this office for record on the 26 day of Nov., 1976 at 3:30 o'clock P. M.

EUGENE STATEZNY Document Number 110620  
(Register of Deeds)

By Eileen Schmidt Deputy

43513209020