

State of Wisconsin

County of FOREST

ss. RESTORATION OF LOST ORIGINAL GOVERNMENT SURVEY CORNER.

I NEAL SPERHAKE, do hereby certify that on the TWENTY-NINTH day of SEPTEMBER 19 64, I ~~established~~ located the NORTHWEST SECTION CORNER OF SECTION 27, TOWNSHIP 35 NORTH, RANGE 13 EAST, Fourth Principal Meridian, as described hereon.

History: This corner was established during the original survey of this township, as noted in the original field notes for the original survey of T35N-R13E, 4th. p.m. and apparently was relocated by C. E. Walker, Forest County Surveyor, in 1940. However, no record of Walker's survey was obtainable.


Description of monument and accessories I established to perpetuate the location of this corner:

At the point determined for the location of the corner I emplaced a:
GALVANIZED IRON PIPE, FIVE FEET LONG, TWO INS. IN DIAMETER, WITH BRASS CAP DENOTED AS, "FOREST CO. FOREST CROP SURVEY T35N-R13E 21, 22, 28, 27 C.E. WALKER 7/25/1940."


The pipe is witnessed by:

- Maple 6 N 54°W 48 links. (SCRIBED S21 NBT).
- W. Ash 7 N 36°E 11 links. (SCRIBED S22 NBT).
- Maple 5 S 87°E 10 links. (SCRIBED S27 NBT).
- Elm 12 S 47°W 62 links. (SCRIBED S28 NBT).

Description as to how corner was located: The corner has not been questioned by any of the adjoining landowners since it was set 24 years ago, and its position appears to be not in conflict with any of the survey work I have done in the immediate vicinity of this corner. Walker has set the quarter corner between 21 and 28, and the section corner is 39.88 chains east of this quarter corner. The original distance was 39.60 chains, so there isn't too great a conflict here. To the east I have established the corner of 22, 23, 26, 27, and it is 82.36 chains away. The original length of this line was 80.70 chains and this does appear to be a conflict. However, my survey work in this area convinces me that this section line is much longer than what was originally claimed, and the 1.66 chain difference between the original length and the present length is compatible with my observations. Walker has established the corner of 27, 28, 33, 34. North of this at 40.07 chains, he located the original bearing trees for the quarter corner between 27 and 28. Projecting a straight line between his corner of 27, 28, 33, 34 and the quarter corner between 27 and 28, a distance of 80.22 chains, we hit on his corner of 21, 22, 27, 28, and I feel that he probably established this corner by this projection method. Though this doesn't agree with accepted methods of setting section corners by double proportionate measurements, I am willing to accept the fact that this corner has been established at a point probably as close to where the original corner was as any retracement survey can be expected to locate it, and have scribed and noted new bearing trees, and am recording its position with the register of deeds of Forest County.

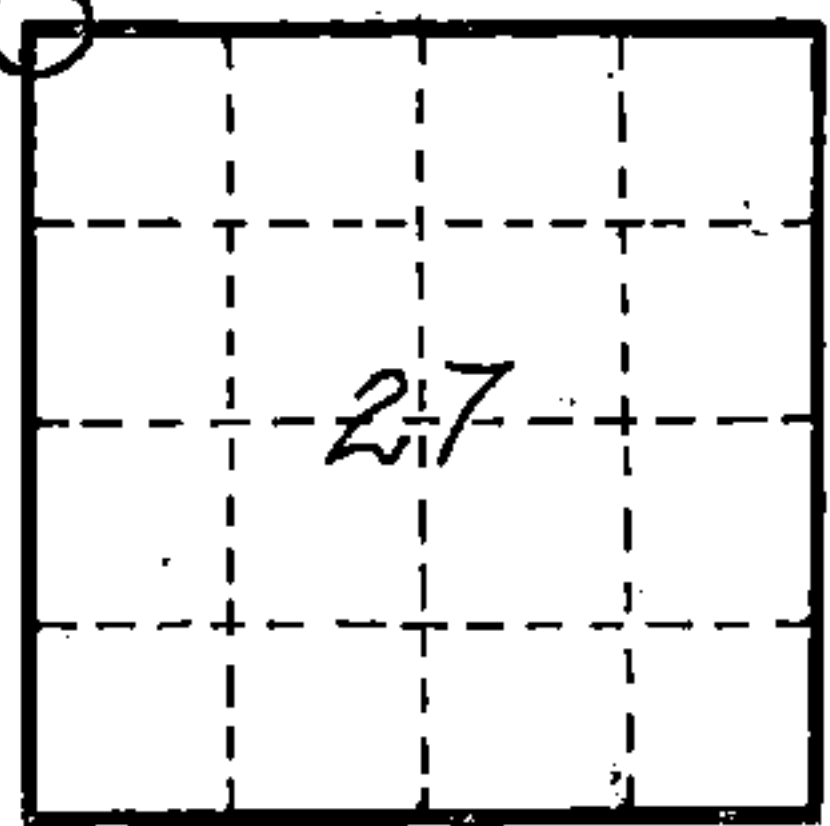

O = Corner monument restored

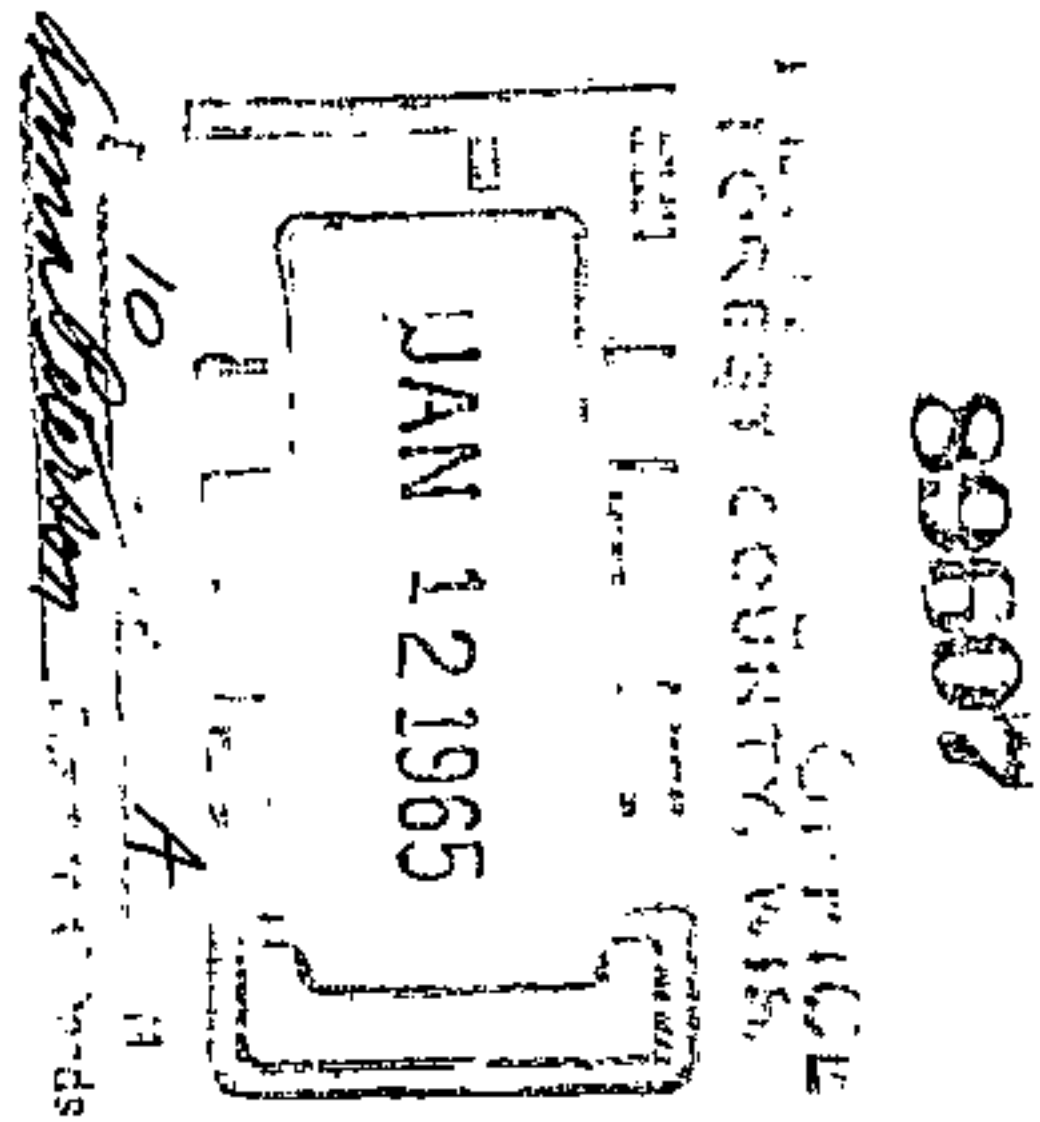

Resident witnesses

Dated at Crandon, Wisconsin, this 12th day of January, 19 65

Signature *Neal Sperhake*

Title Registered Land Surveyor Registration No. 463

~~Office of~~ Forest County ~~of~~ Wisconsin, I hereby certify that the within instrument was ~~filed on this~~ ~~office for record~~ on the 12th day of January 1965, and was ~~filed in book No.~~ signed and ~~page No.~~ sworn to ~~of County Records~~ before me.

Surveyor's Seal

Signature *Anna Peterson* Title Notary Public

43513210000

Index No. R13