

State of Wisconsin }
County of FOREST } ss. ESTABLISHMENT OF QUARTER - QUARTER SECTION CORNER BETWEEN
ORIGINAL GOVERNMENT SURVEY CORNERS.


I NEAL SPERHAKE, do hereby certify that on the TWENTY-NINTH day of SEPTEMBER, 1964, I established the EAST ONE SIXTEENTH CORNER BETWEEN SECTIONS 21 AND 28, TOWNSHIP 35 NORTH, RANGE 13 EAST, Fourth Principal Meridian, as described hereon.

History: There is no record of this corner having ever been previously established.

Description of monument and accessories I established to perpetuate the location of this corner:

At the point determined for the location of the corner I emplaced a:
GALVANIZED IRON PIPE, THREE FEET LONG, ONE INCH IN DIAMETER, WITH ALUMINUM CAP DENOTED AS,
"KIMBERLY CLARK CORP. T35N E 1/16 BTWN. 21 & 28 R13E SPERHAKE RLS 463 9/29/64."
The pipe is witnessed by:
Aspen 7 N 53°W 92 links. (SCRIBED S21 NBT).
Bass 5 S 47°E 83½ links. (SCRIBED S28 BT).

Description as to how corner was located: Since both the quarter section corner ¼ mile west and the section corner ¼ mile east have been previously established with a distance between them of 39.88 chains, the E 1/16th. corner was set 19.94 chains from either corner and on a straight line between them.

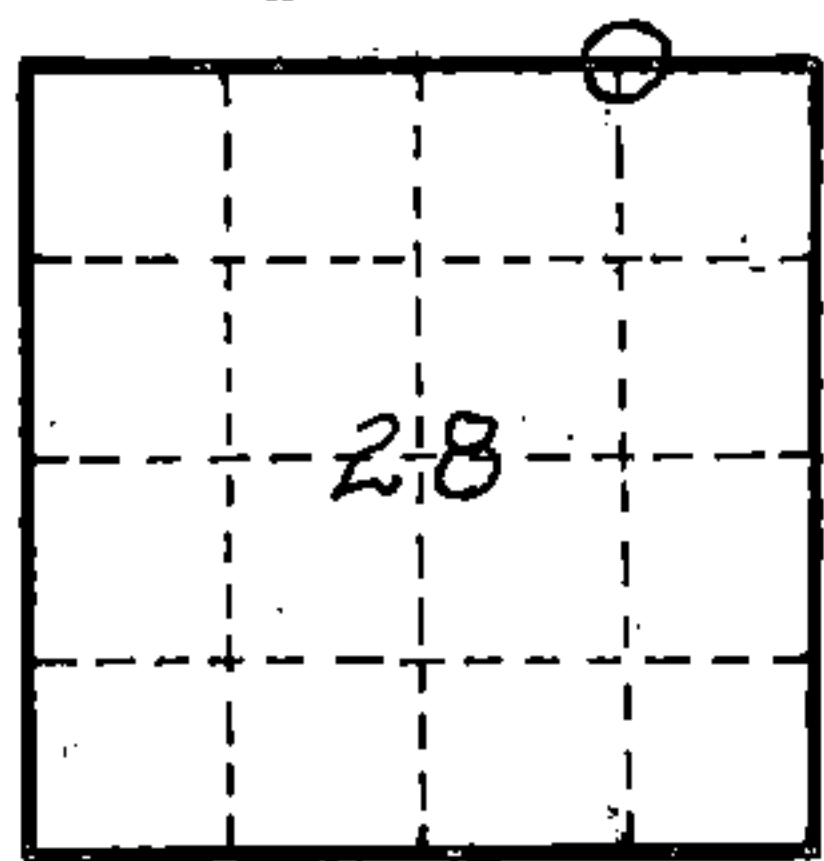

O = Corner monument restored

89611
REGISTERED OFFICE
FOREST COUNTY, WIS.
JAN 12 1965
Anna Peterson, Registrar of Deeds

Resident witnesses _____

Dated at Crandon, Wisconsin, this 12th day of January, 1965.

Signature Neal Sperhake
Title Registered Land Surveyor Registration No. 463

Office of Forest County of Wisconsin
I hereby certify that the within instrument was filed in this office for record on the 12th day of January 1965, and was filed in Book No. signed and page No. sworn to of County Records before me.

Surveyor's Seal

Signature Anna Peterson Title Notary Public

43513210010

Index No. R12