

State of Wisconsin

County of FOREST

ss. RESTORATION OF LOST ORIGINAL GOVERNMENT SURVEY CORNER.

I NEAL SPERHAKE, do hereby certify that on the TWENTY-NINTH day of SEPTEMBER, 19 64, I ~~established~~ ^{found} located the NORTH QUARTER SECTION CORNER OF SECTION 28, TOWNSHIP 35 NORTH, RANGE 13 EAST, Fourth Principal Meridian, as described hereon.

History: This corner was established during the original survey of this township, as noted in the original field notes for the original survey of T35N-R13E, 4th. p.m. and apparently was relocated by C. E. Walker, Forest County Surveyor, in 1940. However, no record of Walker's survey was obtainable.

Description of monument and accessories I established to perpetuate the location of this corner:


At the point determined for the location of the corner I ^{found} replaced a:

GALVANIZED IRON PIPE, FIVE FEET LONG, TWO INS. IN DIAMETER, WITH BRASS CAP DENOTED AS, "FOREST CO. FOREST CROP SURVEY T35N-R13E 1/4 BTWN. 21 & 28 C. E. Walker 7/25/1940."

The pipe is witnessed by:

- Cedar 6 N 19°W 38 links. (SCRIBED 1/4 S 21 NBT).
- Balsam 5 S 15°W 32 links. (SCRIBED 1/4 S 28 NBT).


Description as to how corner was located: The measured distance between the established corner of 21, 22, 27, 28, and Walker's pipe and cap noted above, is 39.88 chains. The original distance was 39.60 chains. Since this distance corresponds fairly well with other retracement work I've done in this vicinity, I have accepted Walker's pipe and cap as marking the site of the original quarter corner, and have witnessed it as noted above.

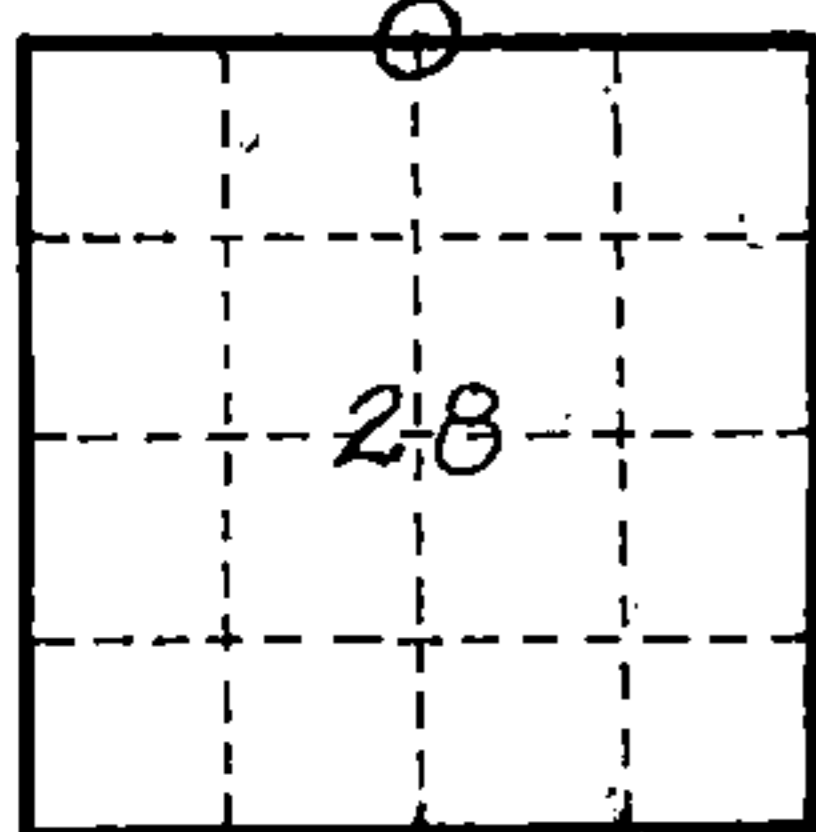

O = Corner monument restored

89610

REGISTRARS OFFICE
FOREST COUNTY, WIS.

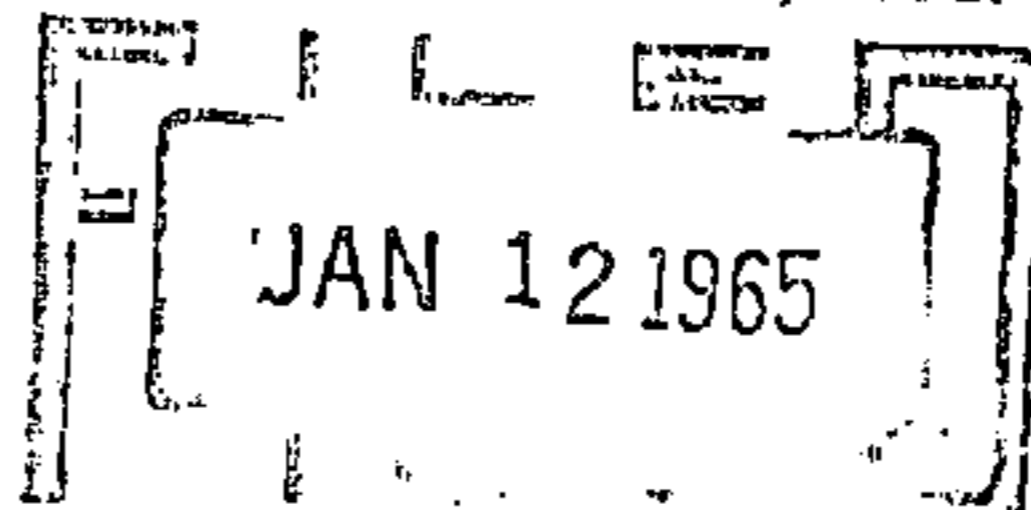

Resident witnesses _____

Dated at Crandon, Wisconsin, this 12th day of January, 1965.

Signature Neal Sperhake

Title Registered Land Surveyor Registration No. 463

Office of Forest County of Wisconsin

I hereby certify that the within instrument was ~~filed in this~~ ^{filed in this} office for record on the 12th day of January 1965, and was ~~filed in Book No.~~ ^{filed in Book No.} signed and ~~Page No.~~ ^{Page No.} sworn to of County Records before me.

Surveyor's Seal

Signature Anna Peterson Title Notary Public

43513210920

Index No. **R11**