

State of Wisconsin

County of FOREST

ss. RESTORATION OF LOST ORIGINAL GOVERNMENT SURVEY CORNER.

I NEAL SPERHAKE, do hereby certify that on the TWENTY-NINTH day of SEPTEMBER, 19 64, I established the NORTH QUARTER SECTION CORNER OF SECTION 27, TOWNSHIP 35 NORTH, RANGE 13 EAST, Fourth Principal Meridian, as described hereon.

History: This corner was established during the original survey of this township, as noted in the original field notes for the original survey of T35N-R13E, 4th. p.m.

Description of monument and accessories I established to perpetuate the location of this corner:


At the point determined for the location of the corner I emplaced a:

GALVANIZED IRON PIPE, THREE FEET LONG, ONE INCH IN DIAMETER, WITH ALUMINUM CAP DENOTED AS, "KIMBERLY CLARK CORP. T35N 1/4 BTWN. 22 & 27 R13E SPERHAKE RLS 463 9/29/64."

The pipe is witnessed by:

Bass 5 N 50°W 110 links (SCRIBED 1/4 S 22 NBT).
B. Cherry 8 S 45°W 54 1/2 links (SCRIBED 1/4 S 27 NBT).

Description as to how corner was located: No evidence of original corner present. Since both the section corners 1/2 mile east and west, respectively, have been previously established with a distance between them of 82.36 chains, the quarter corner was set 41.18 chains from either section corner and on a straight line between them.

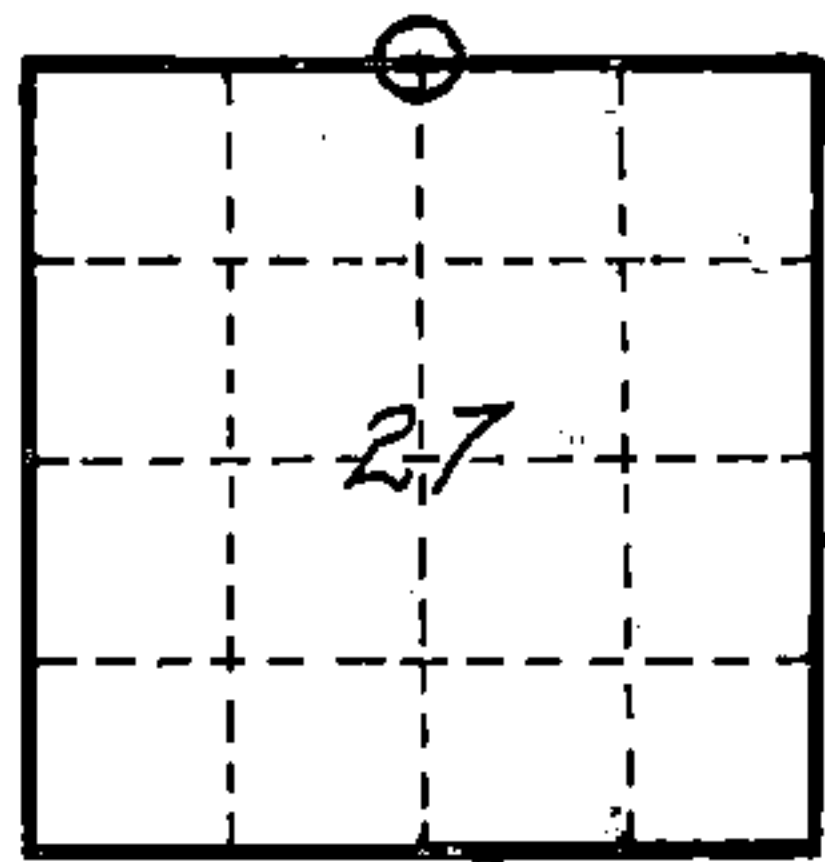

O = Corner monument restored

89608

REGISTERED OFFICE
FOREST COUNTY, WIS.
JAN 12 1965
Anna Peterson A M

Resident witnesses _____

Dated at Crandon, Wisconsin, this 12th day of January, 1965.

Signature Neal Sperhake

Title Registered Land Surveyor Registration No. 463

~~Office~~ Forest County ~~of~~ Wisconsin

I hereby certify that the within instrument was ~~filed in the~~ filed in the ~~office for record~~ on the 12th day of January 1965, and was ~~filed in Book No.~~ signed and ~~Page No.~~ sworn to ~~of County Records.~~ before me.

Surveyor's Seal

Signature Anna Peterson Title Notary Public

43513220020

Index No. R15