

State of Wisconsin  
County of FOREST

ss. RESTORATION OF LOST ORIGINAL GOVERNMENT SURVEY CORNER.

I NEAL SPERHAKE, do hereby certify that on the EIGHTEENTH day of SEPTEMBER 19 64, I established the NORTH QUARTER SECTION CORNER OF SECTION 26, TOWNSHIP 35 NORTH, RANGE 13 EAST, Fourth Principal Meridian, as described hereon.

**History:** This corner was established during the original survey of this township, as noted in the original field notes for the original survey of T35N-R13E, 4th. p.m.

**Description of monument and accessories I established to perpetuate the location of this corner:**


At the point determined for the location of the corner I emplaced a:

GALVANIZED IRON PIPE, THREE FEET LONG, ONE INCH IN DIAMETER, WITH ALUMINUM CAP DENOTED AS, "KIMBERLY CLARK CORP. T35N 1/4 BTWN. 23 & 26 R13E SPERHAKE RLS 463 9/18/64."

The pipe is witnessed by:

- B. Cherry 6 S 12°E 28 links. (SCRIBED 1/4S 26 NBT).
- Maple 15 N 33°W 40 links. (SCRIBED 1/4S 23 NBT).

**Description as to how corner was located:** No evidence of the original corner present. Thus, set by proportionate measurement. The section corners 1/2 mile east and west have been previously established with a distance between them of 79.72 chains. Thus, the quarter corner was set 39.86 chains from either corner and on a straight line between them.

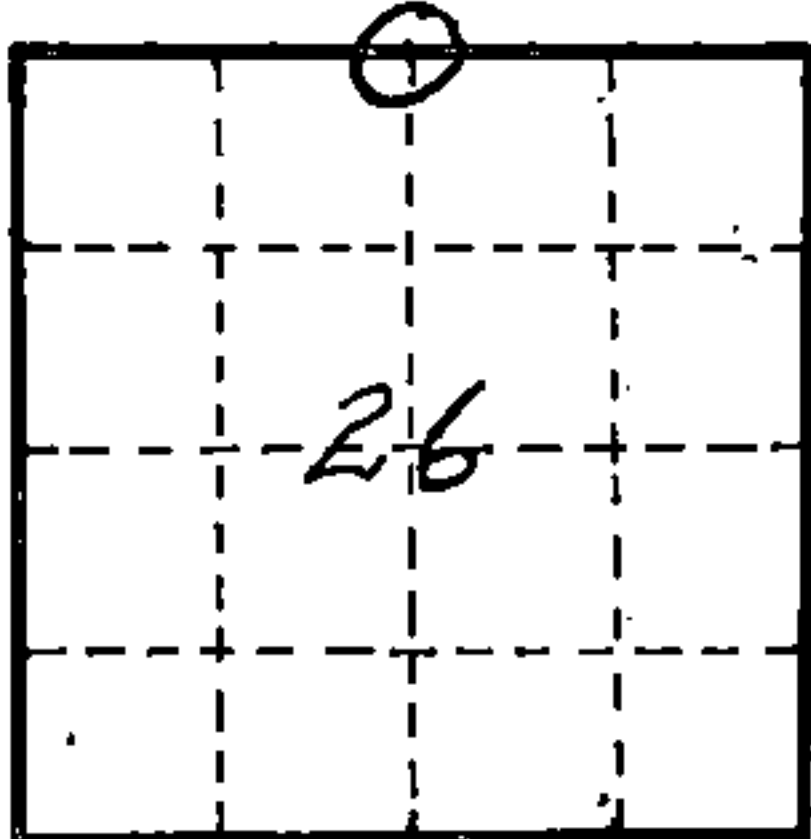

O = Corner monument restored

89603

OFFICE  
FOREST COUNTY, WIS.  
JAN 12 1965

*Anna Peterson* A

Resident witnesses \_\_\_\_\_

Dated at Crandon, Wisconsin, this 12<sup>th</sup> day of January, 19 65.

Signature *Neal Sperhake*

Title Registered Land Surveyor Registration No. 463

~~Office of~~ Forest County of Wisconsin, I hereby certify that the within instrument was ~~filed in this~~ ~~office for record~~ on the 12<sup>th</sup> day of January 19 65, and was ~~filed in Book No.~~ signed and ~~Page No.~~ sworn to ~~of County Records~~ before me.

Surveyor's Seal

Signature *Anna Peterson* Title Notary Public

43513 230020

Index No. **R19**