

State of Wisconsin
County of FOREST

ss. ESTABLISHMENT OF QUARTER - QUARTER SECTION CORNER BETWEEN ORIGINAL GOVERNMENT SURVEY CORNERS.

I NEAL SPERHAKE, do hereby certify that on the FOURTEENTH day of SEPTEMBER, 1964, I established the WEST ONE SIXTEENTH CORNER BETWEEN SECTIONS 23 AND 26, TOWNSHIP 35 NORTH, RANGE 13 EAST, Fourth Principal Meridian, as described hereon.

History: There is no record of this corner having ever been previously established.

Description of monument and accessories I established to perpetuate the location of this corner:


At the point determined for the location of the corner I emplaced a:

GALVANIZED IRON PIPE, THREE FEET LONG, ONE INCH IN DIAMETER, WITH ALUMINUM CAP DENOTED AS, "KIMBERLY CLARK CORP. T35N W 1/16 BTWN. 23 & 26 R13E SPERHAKE RLS 463 9/14/64."

The pipe is witnessed by:

- Elm 12 N 7°E 89 links. (SCRIBED S23 BT).
- Maple 14 S 31°E 61½ links. (SCRIBED S26 BT).

Description as to how corner was located: Since both the quarter section corner ¼ mile east and the section corner ¼ mile west have been previously established with a distance between them of 39.86 chains, the W 1/16th. corner was set 19.93 chains from either corner and on a straight line between them.

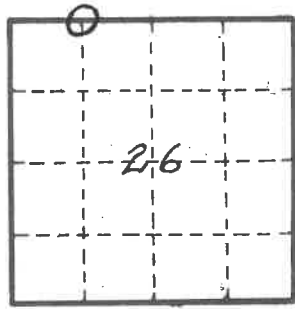

O = Corner monument restored

89605

NOTARY PUBLIC
FOREST COUNTY, WIS.
JAN 12 1965
Anna Peterson A

Resident witnesses _____

Dated at Crandon, Wisconsin, this 12th day of January, 1965.

Signature Neal Sperhake

Title Registered Land Surveyor Registration No. 463

~~of~~ Forest County ~~of~~ Wisconsin, I hereby certify that the within instrument was ~~filed in this~~ filed for record on the 12th day of January 1965, and was ~~filed in Book No.~~ signed and ~~Page No.~~ sworn to ~~at County Records.~~ before me.

Surveyor's Seal

Signature Anna Peterson Title Notary Public

43513230030

Index No. **R18**