


# CERTIFIED LAND CORNER RESTORATION

Index No. **N21 22**

State of Wisconsin }  
County of FOREST } ss.

I NEAL SPERHAKE, do hereby  
certify that on the TWENTY-NINTH day  
of JULY, 19 64, I found  
evidence of the WITNESS CORNER TO THE NORTHWEST SECTION  
corner of SECTION 24  
Township 35, North, Range  
13 EAST, Fourth, Principal Meridian,  
as described hereon; and that from this evidence  
I established a new monument and accessories  
as described hereon to perpetuate the original  
location of this corner.

Resident witnesses:

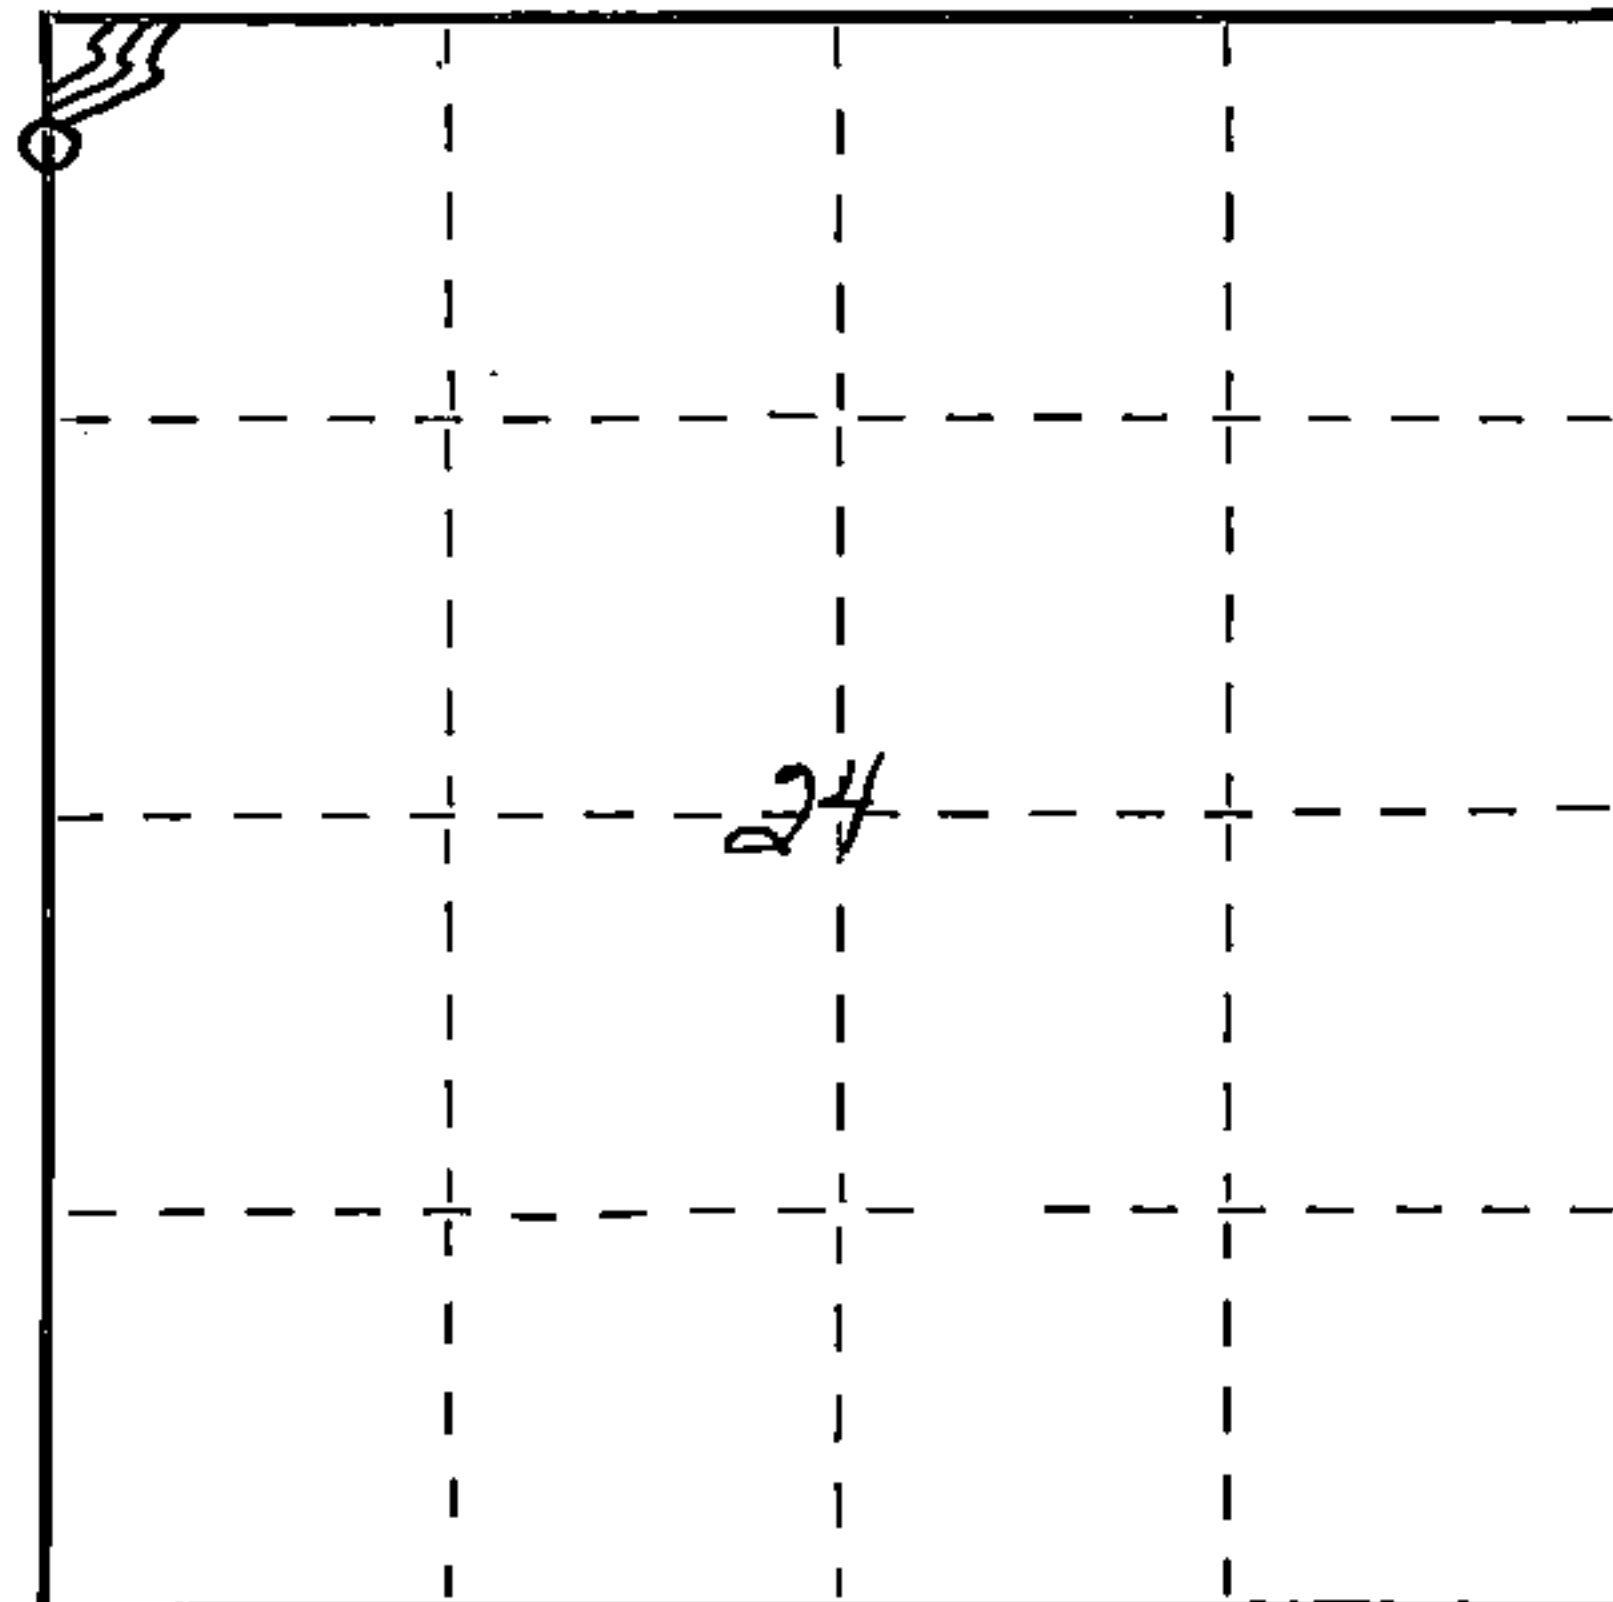

○ = Corner monument restored.

History of original corner establishment: This corner can also be described as: "THE WITNESS CORNER  
TO THE SECTION CORNER COMMON TO SECTIONS 13, 14, 23, 24,  
T35N-R13E, 4th. p.m."

This corner was established during the original survey of this  
township, as noted in the Original Field Notes for the Original  
Survey of T35N-R13E, 4th. p.m.

## Description of corner evidence found:

The stump of the original bearing tree, described in the original field notes as:

"Hemlock 9 S 81°E 40 links."

is still present at this date, with a portion of the original scribe marks still visible.

## Description of monument and accessories I established to perpetuate the original location of this corner.

At the site of the original post, as determined from the existing original bearing  
tree noted above, I emplaced a "Galvanized iron pipe, three feet long, one inch in  
diameter, with aluminum cap denoted as, 'Kimberly Clark Corp. T35N 13, 14, 23,  
24, R13E SPERHAKE RLS 463 W.C. Cr. IS 4.50 CHS. N.'"

The pipe is witnessed by:

W. Birch 7 S 70°E 25½ links. (SCRIBED W.C. S 24 NBT).  
W. Birch 6 S 88°W 12 links. (SCRIBED W.C. S 23 NBT).

Dated at \_\_\_\_\_, Wis., this \_\_\_\_\_ day of \_\_\_\_\_, 19 \_\_\_\_\_.

Signature Neal Sperhake Title Registered Land Surveyor Registration No. 463  
(County Surveyor, Registered Land Surveyor, or other duly authorized official)

~~Office of Register of Deeds~~ County of Forest, State of Wisconsin I hereby certify that the within  
instrument was ~~filed in this office for record~~ on the 12th day of January, 19 65.

~~at xxxxxx'clock~~ My signed and sworn to before me.

Anna Peterson  
Notary Public


By \_\_\_\_\_ Deputy

43513233700

*over*

83597

REGISTRATION OFFICE  
FOREST COUNTY, WIS.

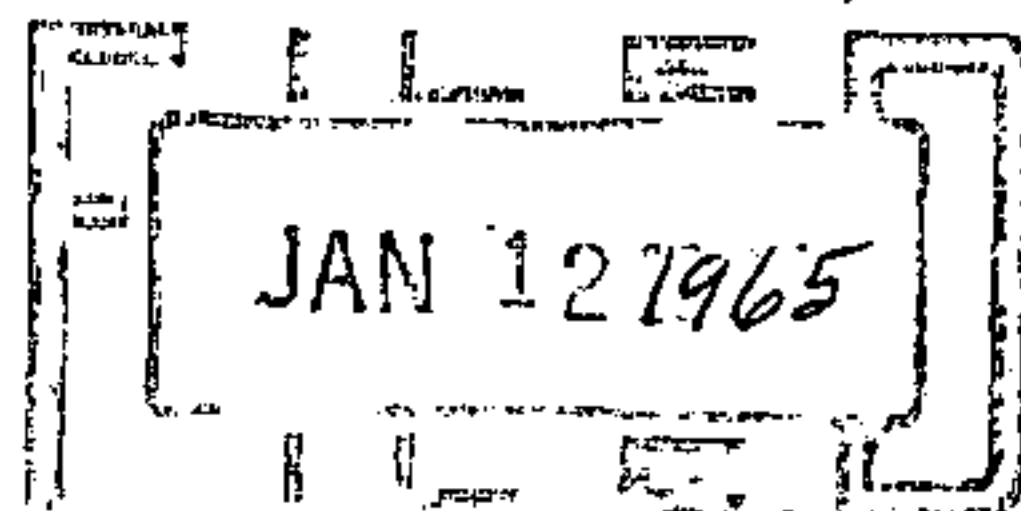

10  
*Luna Peterson* Registrar of Records

