

State of Wisconsin

County of FOREST

ss. RESTORATION OF LOST ORIGINAL GOVERNMENT SURVEY CORNER.

I NEAL SPERHAKE, do hereby certify that on the THIRTIETH day of SEPTEMBER 19 64, I established the NORTH QUARTER SECTION CORNER OF SECTION 25, TOWNSHIP 35 NORTH, RANGE 13 EAST, Fourth Principal Meridian, as described hereon.

History: This corner was established during the original survey of this township, as noted in the original field notes for the original survey of T35N-R13E, 4th. p.m.

Description of monument and accessories I established to perpetuate the location of this corner:


At the point determined for the location of the corner I emplaced a:

GALVANIZED IRON PIPE, THREE FEET LONG, ONE INCH IN DIAMETER, WITH ALUMINUM CAP DENOTED AS, "KIMBERLY CLARK CORP. T35N 1/4 BTWN. 24 & 25 R13E SPERHAKE RLS 463 9/30/64."

The pipe is witnessed by:

Maple 3 N 46°W 40 links. (SCRIBED 1/4 S 24 NBT).
W. Birch 4 S 32°W 5 links. (SCRIBED 1/4 S 25 NBT).


Description as to how corner was located: No evidence of the original corner present. Thus, set by proportionate measurement. Since both the section corners 1/2 mile east and west have been previously established with a distance between them of 80:70 chains, the quarter corner was set 40.35 chains from either corner and on a straight line between them.

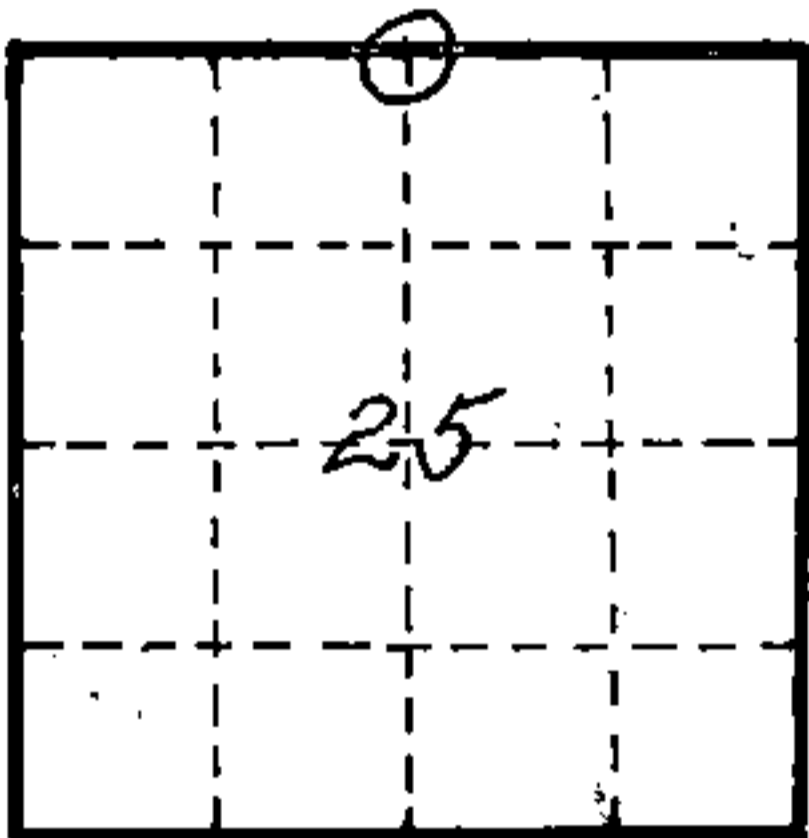

O = Corner monument restored

89599

REGISTRARS OFFICE
FOREST COUNTY, WIS.

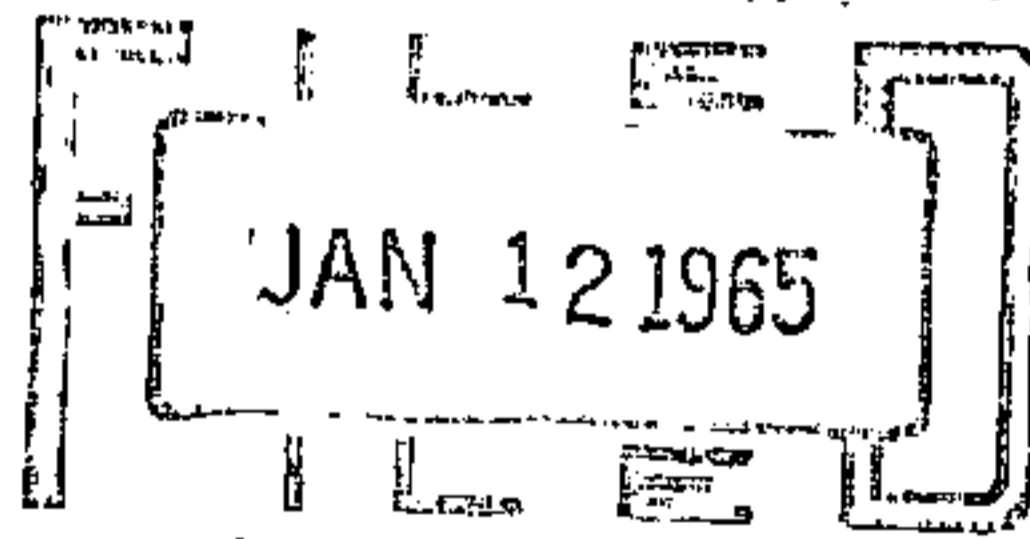

At 10 o'clock A.M.
Anna Peterson Register of Deeds

Resident witnesses _____

Dated at Crandon, Wisconsin, this 12th day of January, 1965.

Signature Neal Sperhake

Title Registered Land Surveyor Registration No. 463

~~Office at~~ Crandon County ~~of~~ Wisconsin,
I hereby certify that the within instrument was ~~filed in the~~
~~office for records~~ on the 12th day of January
1965, and was ~~filed in Book No.~~ signed and ~~page No.~~ sworn to
~~in County Records.~~ before me.

Surveyor's Seal

Signature Anna Peterson Title Notary Public

43513240020

Index No. **R23**