

CERTIFIED LAND CORNER RESTORATION

Index No. 108 V25 V25

State of Wisconsin }
County of FOREST } ss.

I NEAL SPERHAKE, do hereby certify that on the FOURTEENTH day of NOVEMBER, 1961, I found evidence of the NORTHEAST SECTION corner of SECTION 36 Township 35 North, Range 13 EAST, Fourth Principal Meridian, as described hereon; and that from this evidence I established a new monument and accessories as described hereon to perpetuate the original location of this corner.


Resident witnesses:

Les. Hillberg - Crandon

Richard Piontek - Waubesa

David Seaburg - Laona

FORM 985 H. C. MILLER CO., MILWAUKEE

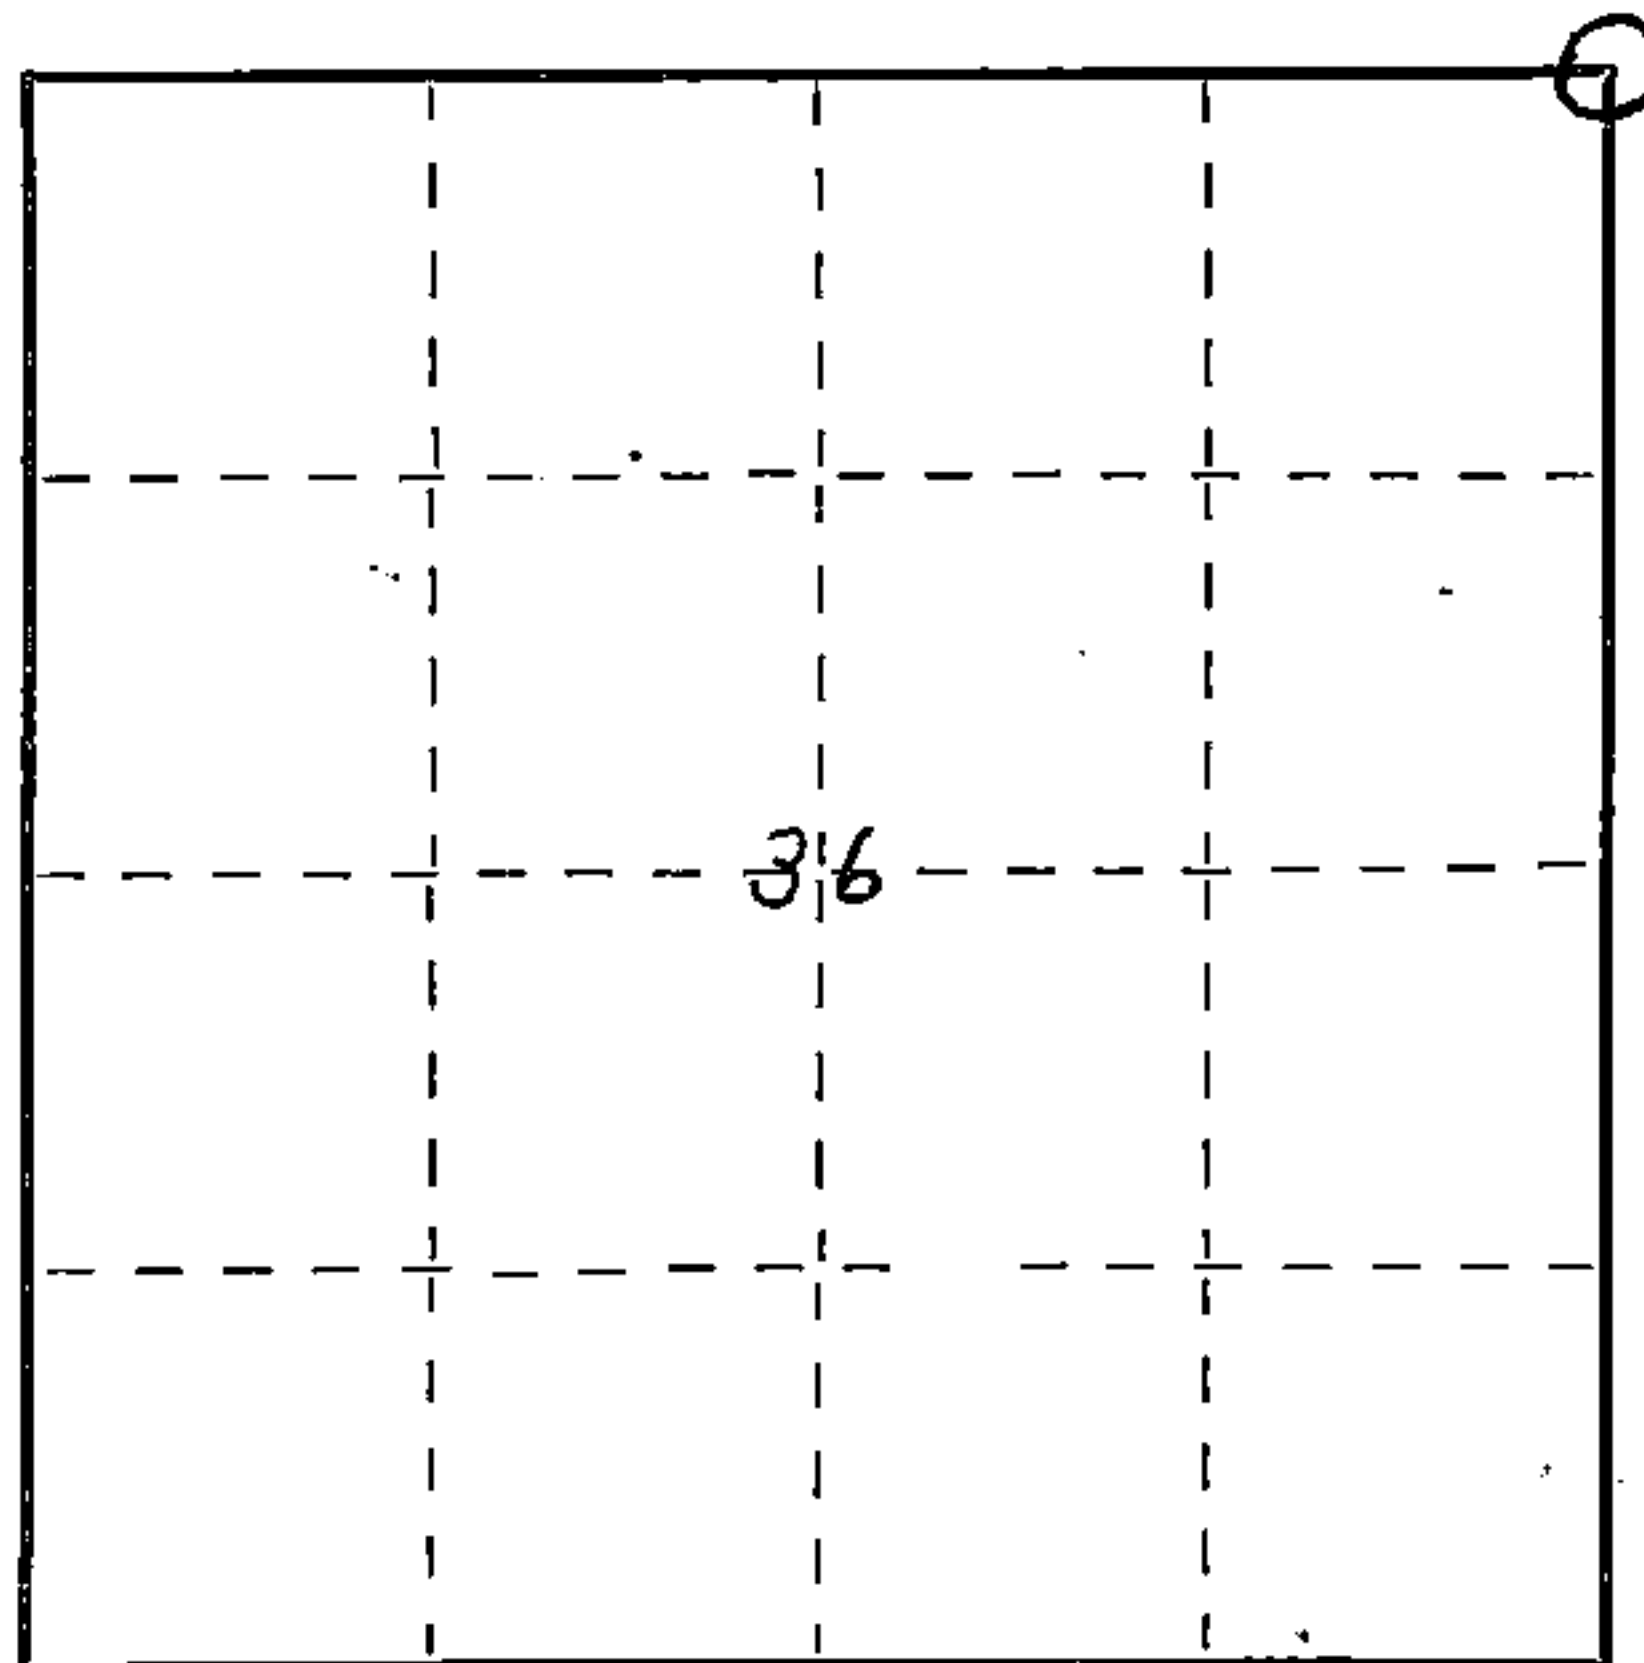

○ = Corner monument restored.

History of original corner establishment:

This corner can also be described as: THE SECTION CORNER COMMON TO SECTIONS 25 AND 36, T35N-R13E, AND SECTIONS 30 AND 31, T35N-R14E, 4TH P.M.

This corner was established during the original survey of this township, as noted in the Original Field Notes for the Original Survey of T35N-R13E, the 4th P.M.

Description of corner evidence found:

The stump of the original bearing tree, described in the original field notes as,

"PINE 30 S54E 9 LINKS"

is still present at this date, with a portion of the original scribe marks still visible.

Description of monument and accessories I established to perpetuate the original location of this corner.

At the site of the original post, as determined from the existing original bearing tree noted above, I emplaced a "GALVANIZED IRON PIPE, THREE FEET LONG, ONE INCH IN DIAMETER, WITH AN ALUMINUM CAP DENOTED AS, "KIMBERLY-CLARK CORP T35N -25, 36, 30, 31, R13-14E SPERHAKE RLS 463 11-14-61".

The pipe is witnessed by:

- Maple 4 N35°W 23 links. (Scribed S25 NBT).
- Balsam 4 S47°W 31 links. (Scribed S36 NBT).
- Oak 12 N71°E 35 links. (Scribed S30 NBT).
- Hemlock 7 S11E 33 links. (Scribed S31 NBT).

Dated at Crandon, Wis. this 11th day of Feb., 1963

Signature *Neal Sperhake* Title Registered Land Surveyor Registration No. S-463
(County Surveyor, Registered Land Surveyor, or other duly authorized official)

Office of Register of Deeds, County of Forest, I hereby certify that the within instrument was filed in this office for record on the 11th day of Feb., 1963 at 10 o'clock A. M. 86837

Anna Peterson
(Register of Deeds)

Subscribed & sworn to before me this 11th day of Feb. 1963
Anna Peterson
Notary Public, Forest Co., Wis
Com. exp. 10/31/65

By _____ Deputy

43513250000
Surveyors Seal