

State of Wisconsin

County of FOREST

ss. RESTORATION OF LOST ORIGINAL GOVERNMENT SURVEY CORNER.

I NEAL SPERHAKE, do hereby certify that on the SEVENTEENTH day of SEPTEMBER, 1964, I established the NORTHWEST SECTION CORNER OF SECTION 35, TOWNSHIP 35 NORTH, RANGE 13 EAST, Fourth Principal Meridian, as described hereon.


History: This corner was established during the original survey of this township, as noted in the original field notes for the original survey of T35N-R13E, 4th. p.m.

Description of monument and accessories I established to perpetuate the location of this corner:

At the point determined for the location of the corner I emplaced a:
GALVANIZED IRON PIPE, THREE FEET LONG, ONE INCH IN DIAMETER, WITH ALUMINUM-CAP DENOTED AS, "KIMBERLY CLARK CORP. T35N 27, 26, 34, 35 R13E SPERHAKE RLS 463 9/17/64."

The pipe is witnessed by:
W. Pine 20 N 47°W 268 links. (SCRIBED S27 NBT).

Description as to how corner was located: No evidence of the original corner is present. Thus, set by double proportionate measurement. To the north the section corner common to 22, 23, 26, 27, and to the south the section corner on the town line between 34 and 35 have been previously established with a distance between them of 160.93 chains. Thus, the north-south position of 26, 27, 34, 35, was determined as being 80.46½ chains from either previously established corner. To the east the section corner of 25, 26, 35, 36, and to the west the section corner of 27, 28, 33, 34, have been previously established with a distance between them of 160.82 chains. The record distance was 160.20 chains. The record distance of the line between sections 26 and 35 was 79.20 chains. Thus, the east-west position of 26, 27, 34, 35, was determined as being 79.51 chains west of 25, 26, 35, 36, and 81.31 chains east of 27, 28, 33, 34.

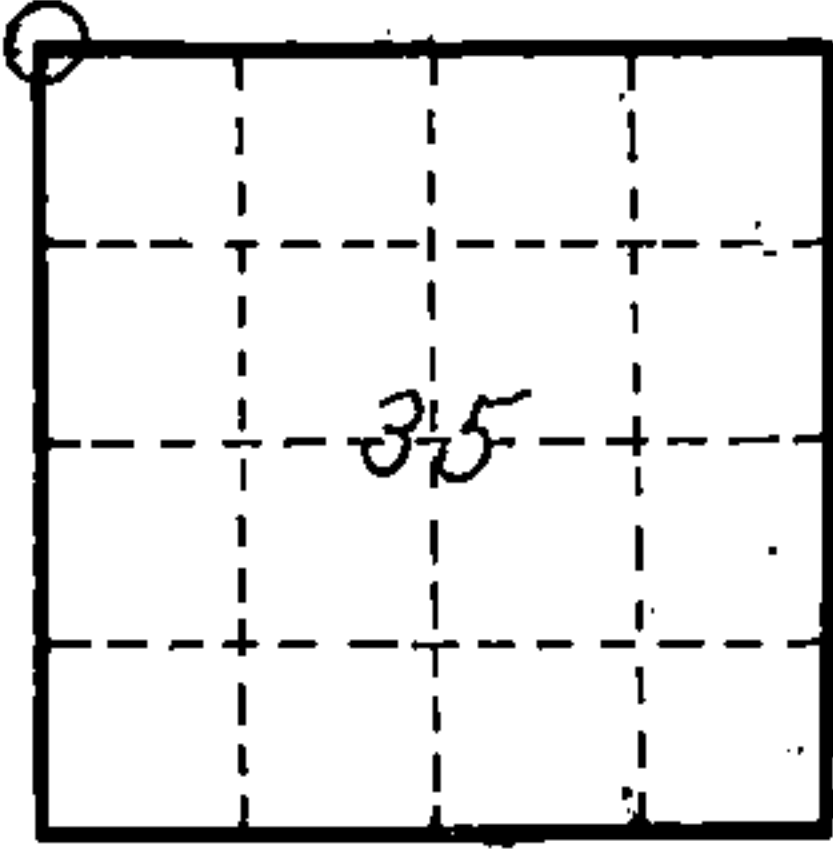

0 = Corner monument restored

89615
NOTARY PUBLIC OFFICE
FOREST COUNTY, WIS.
JAN 12 1965
Anna Peterson 10 A.M.

Resident witnesses _____

Dated at Crandon, Wisconsin, this 12th day of January, 1965

Signature Neal Sperhake

Title Registered Land Surveyor Registration No. 463

~~Office of~~ Forest County ~~of~~ Wisconsin, I hereby certify that the within instrument was ~~filed in this~~ filed in this office for record on the 12th day of January 1965, and was ~~filed in Book No.~~ signed and page No. sworn to ~~of County Records.~~ before me.

Surveyor's Seal

Signature Anna Peterson Title Notary Public

43513270000

Index No. 117