

State of Wisconsin

County of FOREST

ss. RESTORATION OF LOST ORIGINAL GOVERNMENT SURVEY CORNER.

I NEAL SPERHAKE, do hereby certify that on the TWENTIETH day of OCTOBER 19 64, I established the NORTH QUARTER SECTION CORNER OF SECTION 34, TOWNSHIP 35 NORTH, RANGE 13 EAST, Fourth Principal Meridian, as described hereon.

History: This corner was established during the original survey of this township, as noted in the original field notes for the original survey of T35N-R13E, 4th. p.m.

Description of monument and accessories I established to perpetuate the location of this corner:


At the point determined for the location of the corner I emplaced a:

GALVANIZED IRON PIPE, THREE FEET LONG, ONE INCH IN DIAMETER, WITH ALUMINUM CAP DENOTED AS, "KIMBERLY CLARK CORP. T35N 1/4 BTWN. 27 & 34 R13E SPERHAKE RLS 463 10/20/64."

The pipe is witnessed by:

Maple 10 N 20°W 20 links. (SCRIBED 1/4 S 27 NBT).  
Maple 13 S 6°W 36 links. (SCRIBED 1/4 S 34 NBT).


Description as to how corner was located: No evidence of the original corner present. Thus, set by proportionate measurement. Since both the section corners 1/2 mile east and west respectively, have been previously established with a distance between them of 81.31 chains, the quarter corner was set 40.65 1/2 chains from either corner and on a straight line between them.

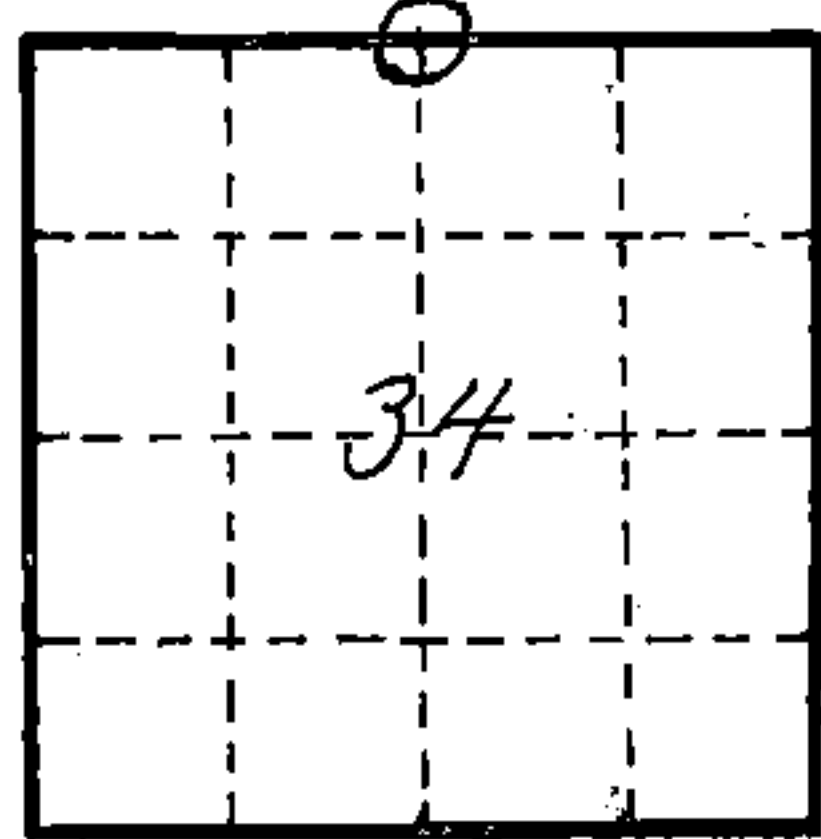

O = Corner monument restored

89612

RECORDING OFFICE  
FOREST COUNTY, WIS.

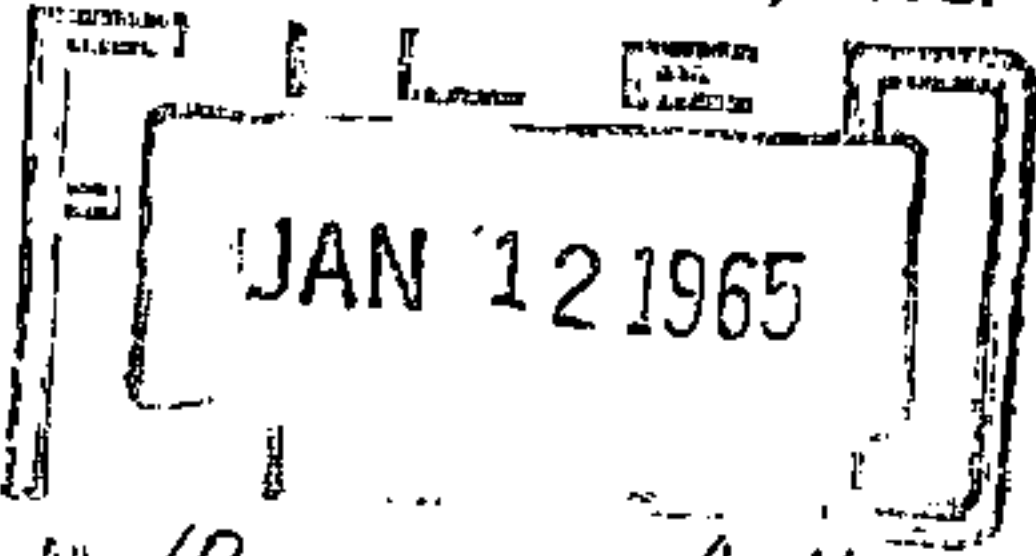

Resident witnesses

Dated at Crandon, Wisconsin, this 12th day of January, 1965.

Signature Neal Sperhake

Title Registered Land Surveyor Registration No. 463

Office of Forest County of Wisconsin

I hereby certify that the within instrument was filed in the office of the recorder on the 12th day of January 1965, and was signed and sworn to before me.

Surveyor's Seal

Signature Anna Peterson Title Notary Public

43513270020

Index No. 115