

State of Wisconsin

County of FOREST

ss. RESTORATION OF LOST ORIGINAL GOVERNMENT SURVEY CORNER.

I NEAL SPERHAKE, do hereby certify that on the SEVENTEENTH day of SEPTEMBER, 19 64, I established the WEST QUARTER SECTION CORNER OF SECTION 26, TOWNSHIP 35 NORTH, RANGE 13 EAST, Fourth Principal Meridian,
as described hereon.

History: This corner was established during the original survey of this township, as noted in the original field notes for the original survey of T35N-R13E, 4th. p.m.

Description of monument and accessories I established to perpetuate the location of this corner:


At the point determined for the location of the corner I emplaced a:

GALVANIZED IRON PIPE, THREE FEET LONG, ONE INCH IN DIAMETER, WITH ALUMINUM CAP DENOTED AS, "KIMBERLY CLARK CORP. T35N $\frac{1}{4}$ BTWN. 27 & 26 R13E SPERHAKE RLS 463 9/17/64."

The pipe is witnessed by:


Spruce 6 N 54° E 8 links. (SCRIBED $\frac{1}{4}$ S 26 NBT).
Spruce 5 S 15° W $6\frac{1}{2}$ links. (SCRIBED $\frac{1}{4}$ S 27 NBT).

Description as to how corner was located: No evidence of the original corner present. Thus, set by proportionate measurement. Since both the section corners $\frac{1}{2}$ mile north and south have been previously established with a distance between them of $80.46\frac{1}{2}$ chains, the quarter corner was set $40.23\frac{1}{4}$ chains from either corner and on a straight line between them.

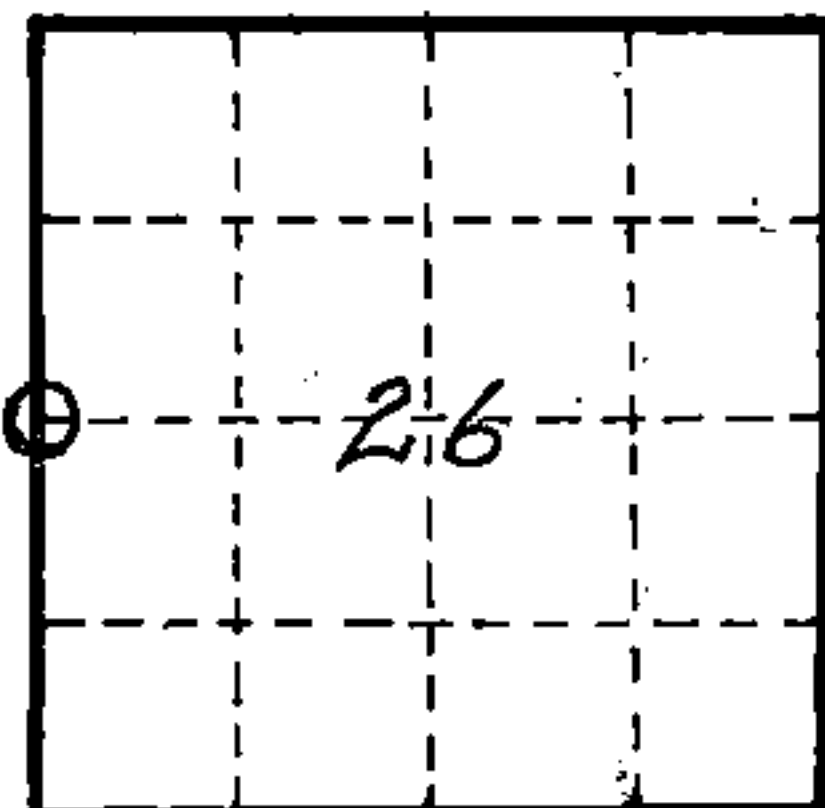

O = Corner monument restored

89604

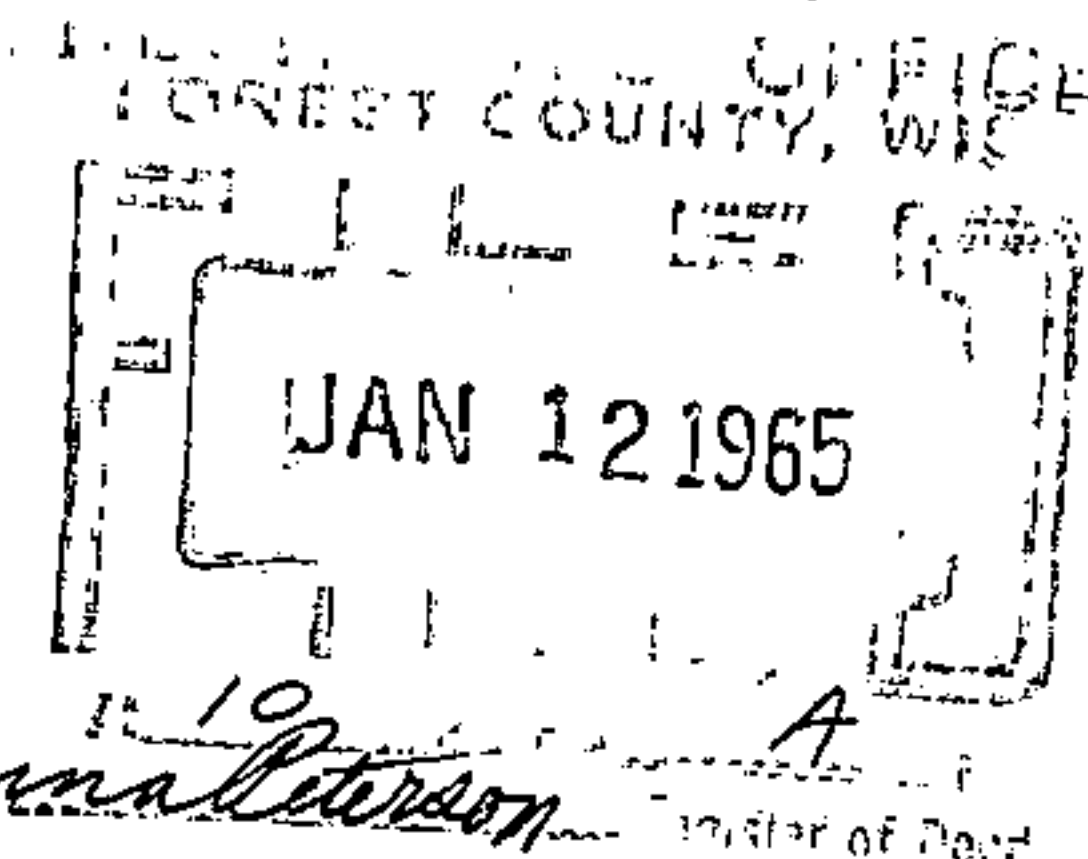

Resident witnesses _____

Dated at Crandon, Wisconsin, this 12th day of January, 19 65.

Signature Neal Sperhake

Title Registered Land Surveyor Registration No. 463

~~Office of~~ Forest County ~~of~~ Wisconsin,
I hereby certify that the within instrument was ~~filed in this~~
~~office for record~~ on the 12th day of January
19 65, and was ~~filed in Book No.~~ signed and ~~Page No.~~ sworn to
~~of County Records~~ before me.

Surveyor's Seal

Signature Anna Peterson Title Notary Public

4351327 2000

Index No. 112