

CERTIFIED LAND CORNER RESTORATION


Index No. **V13**

State of Wisconsin }
County of Forest } ss.

I, Thomas R. Arnott, do hereby certify that on the 4th day of December, 1975, I found evidence of the Section corner of sections 27, 28, 33 & 34 Township 35, North, Range 13 E, Fourth Principal Meridian, as described hereon; and that from this evidence I established a new monument and accessories as described hereon to perpetuate the original location of this corner.

Resident witnesses:

.....
.....
.....

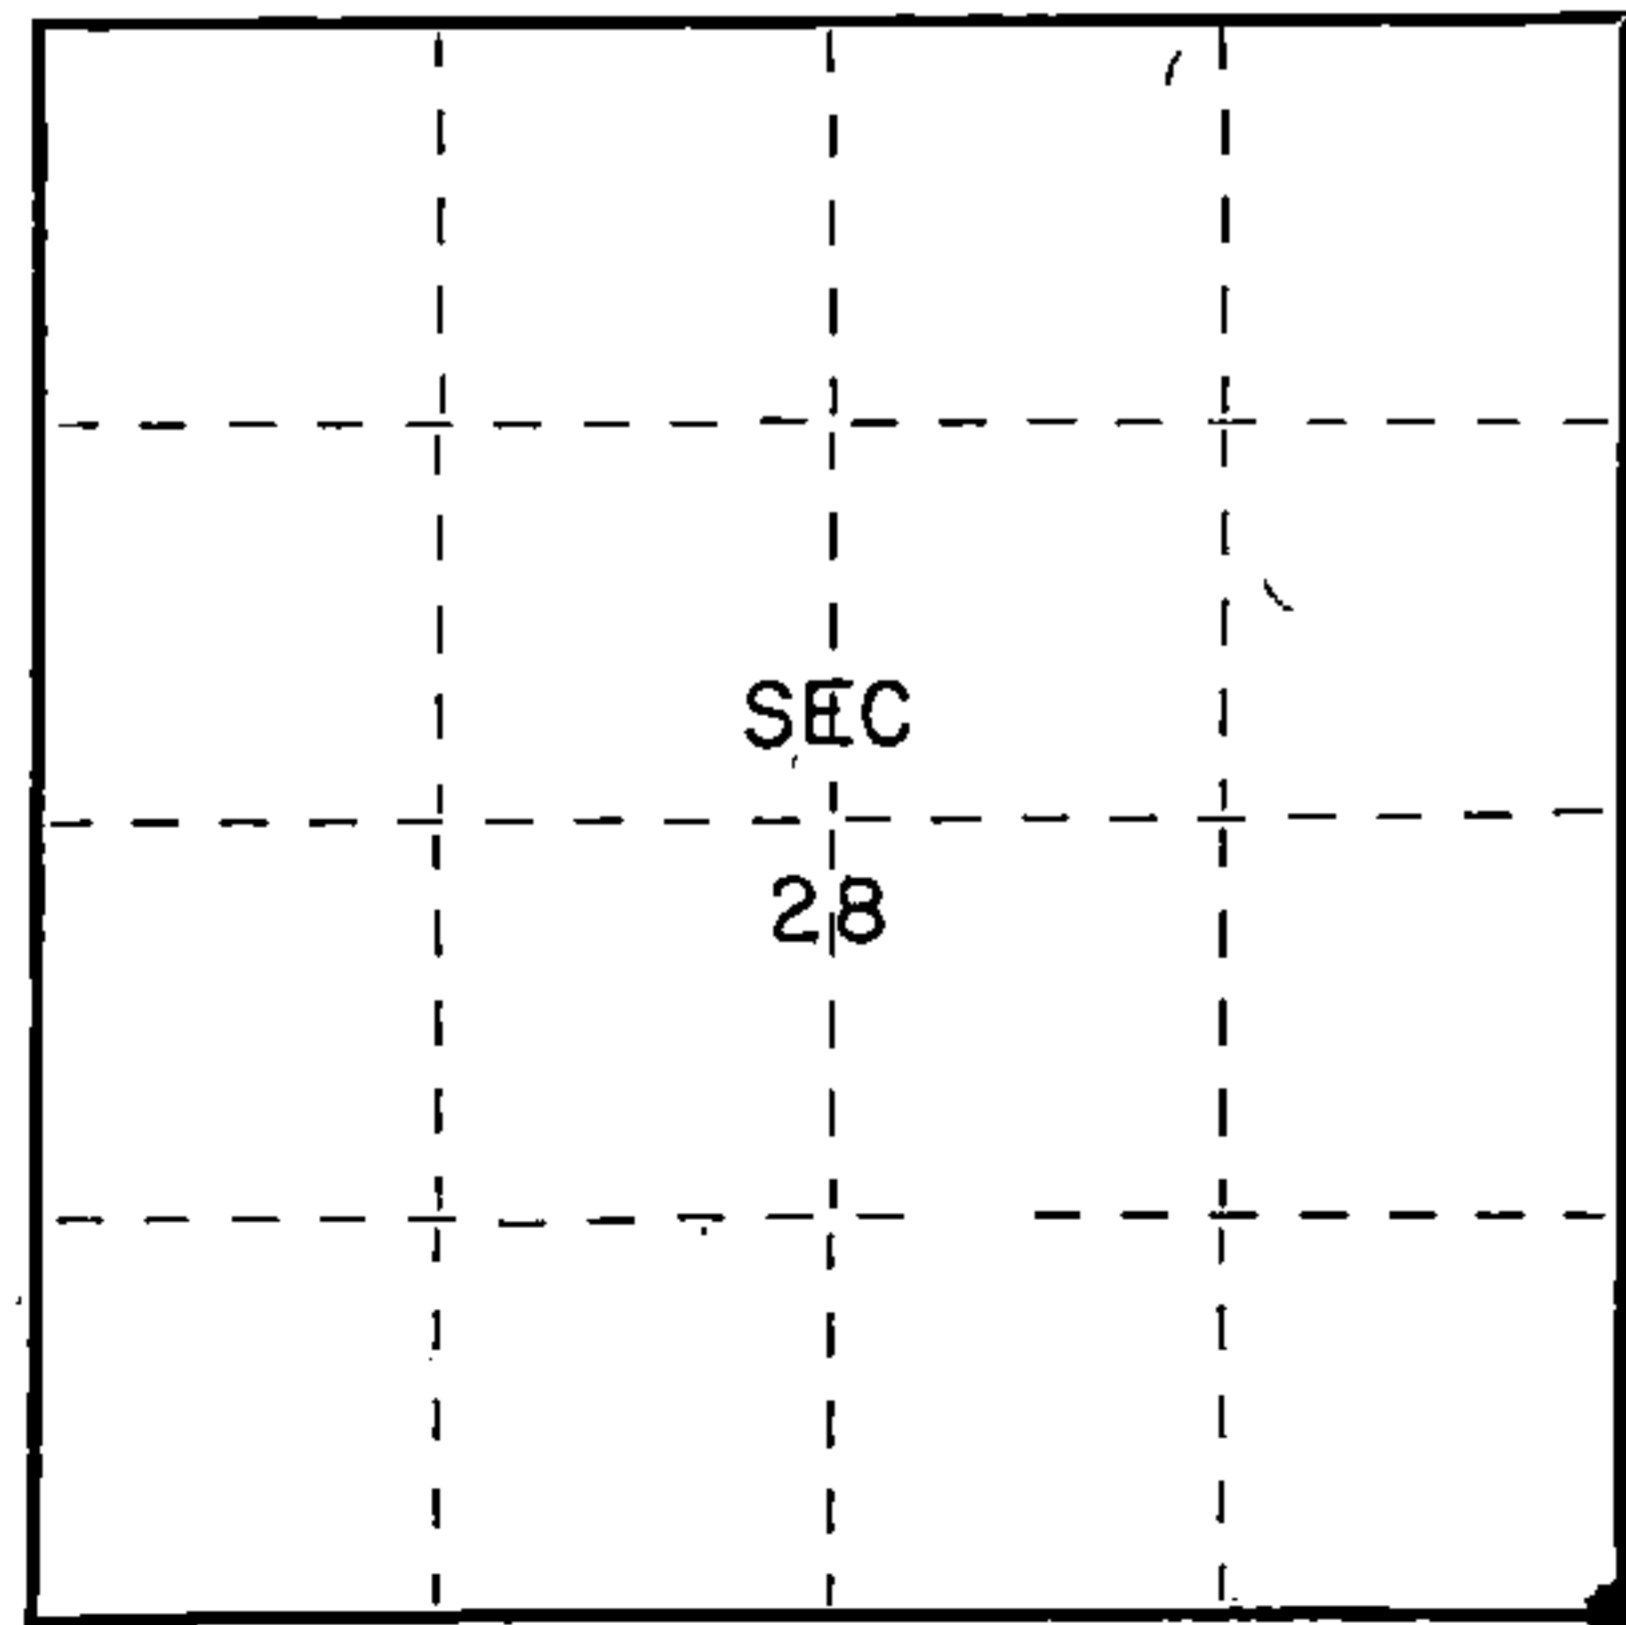

○ = Corner monument restored.

History of original corner establishment:

Original Subdivision by James L. Nowlin Sept. 11 - Sept. 21, 1865

Birch 30 N43E 30 Lks.
Birch 15 N45W 35 Lks.

Description of corner evidence found:

2" iron pipe found 5' long with brass cap set by C.E. Walker in 1940

Description of monument and accessories I established to perpetuate the original location of this corner.

Left moument set by Walker

Ties:

Maple 10 N79E 19.25 feet
Maple 8 S45E 14.59 feet
Maple 8 S44W 7.17 feet



A 3513280000

Dated at Grandon, Wis., this 15th day of December, 1975

Signature Thomas Arnott Title Land Surveyor Registration No. S-887
(County Surveyor, Registered Land Surveyor, or other duly authorized official)

Office of Register of Deeds, County of Forest, I hereby certify that the within instrument was filed in this office for record on the 15th day of December, 1975 at 11 o'clock A. M.

Eugene Stutzny Document Number 108376
(Register of Deeds)

By _____ Deputy

FORM 985 H. C. MILLER CO., MILWAUKEE