

State of Wisconsin

County of FOREST

ss. RESTORATION OF LOST ORIGINAL GOVERNMENT SURVEY CORNER.

I NEAL SPERHAKE, do hereby certify that on the THIRTIETH day of SEPTEMBER, 1964, I ~~established~~ <sup>found</sup> located the WEST QUARTER SECTION CORNER OF SECTION 27, TOWNSHIP 35 NORTH, RANGE 13 EAST, Fourth Principal Meridian, as described hereon.

**History:** This corner was established during the original survey of this township, as noted in the original field notes for the original survey of T35N-R13E, 4th. p.m. and apparently was relocated by C. E. Walker, Forest County Surveyor, in 1940. However, no record of Walker's survey was obtainable.

**Description of monument and accessories I established to perpetuate the location of this corner:**


At the point determined for the location of the corner I <sup>found</sup> ~~established~~ <sup>found</sup> replaced a:

GALVANIZED IRON PIPE, FIVE FEET LONG, TWO INS. IN DIAMETER, WITH BRASS CAP DENOTED AS, "FOREST CO. FOREST CROP SURVEY T35N-R13E 1/4 BTWN. 27 & 28 C. E. WALKER 10/23/1940."

The pipe is witnessed by:

- Spruce 8 S 77°W 16 1/2 links. (SCRIBED 1/4 S 28 NBT).
- Cedar 8 N 32°E 42 links. (SCRIBED 1/4 S 27 NBT).

**Description as to how corner was located:** I am certain that the two scribed trees found here are the original bearing trees, based upon the apparent age of the trees and the scribing. However, neither tree agrees with the calls and the bearings as noted in the original field notes. I am certain that in the original work a mistake was made and the wrong bearings and calls written into the notes. Walker's pipe and cap were found here, as noted above, and in addition, the remains of a post apparently much older than Walker's pipe, was found next to his pipe. It is impossible to determine from the two existing bearing trees where the original corner was placed since no interpretation of the calls and bearings will fit both trees. Since the old post and Walker's pipe were found on approximately a straight line between the two trees, and about, though not quite, equidistant from them, I am assuming that at the time the existing post was set it was possible some remnant of the original post was present, which accounts for the placing of the existing post and Walker's pipe. The existing trees are, from Walker's pipe, as follows:

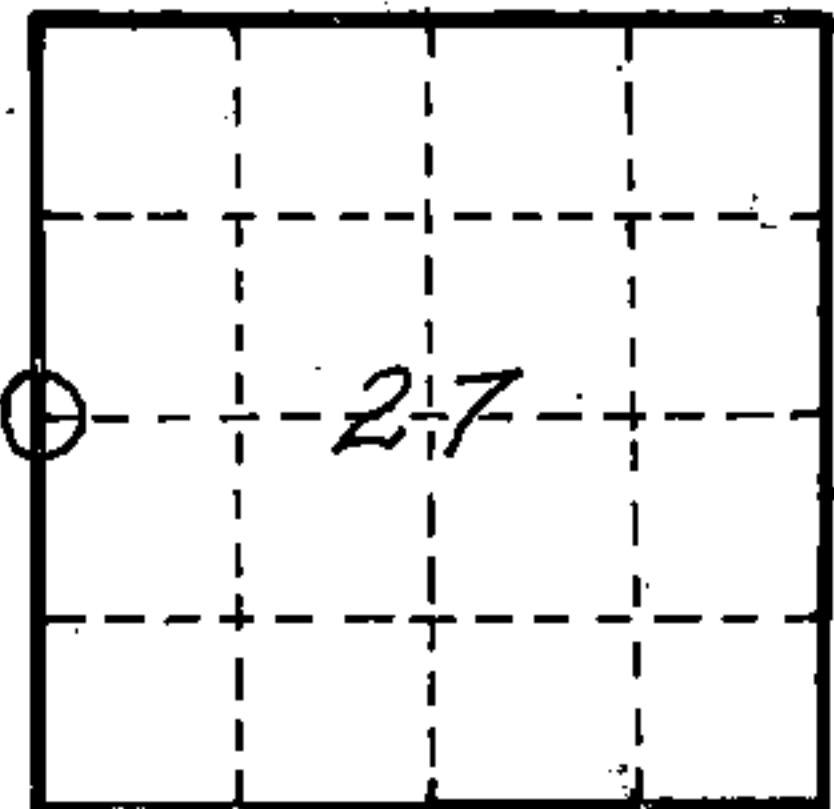

O = Corner monument restored

Dead cedar stub, about 7" in diameter at N 43°E 24 links with scribing remaining as follows: "27 T35 R13 BT."

Live cedar, 12" in diameter, though probably not over 8" in diameter at time of scribing at S 53°W 33 1/2 links with scribing visible as follows: "28 T35 R13 BT."

I have rewitnessed Walker's pipe as noted above.

Resident witnesses \_\_\_\_\_

Dated at Crandon, Wisconsin, this 12th day of January, 1965.

Signature Neal Sperhake

Title Registered Land Surveyor Registration No. 463

~~Office of~~ Forest County ~~of~~ Wisconsin

I hereby certify that the within instrument was ~~filed in this~~ ~~office for record~~ on the 12th day of January 1965, and was ~~filed in Book No.~~ signed and ~~Page No.~~ sworn to ~~of County Records.~~ before me.

Surveyor's Seal

Signature Anna Peterson Title Notary Public

43513282000

Index No. 113

Notary Seal: Anna Peterson, Notary Public, Forest County, Wis., Commission Expires JAN 12 1965