

CERTIFIED LAND CORNER RESTORATION


Index No. T-9

State of Wisconsin }
County of Forest } ss.

I Thomas R. Arnott, do hereby certify that on the 26th day of December, 1975, I found evidence of the 1/4 corner of sections 28 & 29 Township 35 North, Range 13 E, Fourth Principal Meridian, as described hereon; and that from this evidence I established a new monument and accessories as described hereon to perpetuate the original location of this corner.

Resident witnesses:

.....
.....
.....

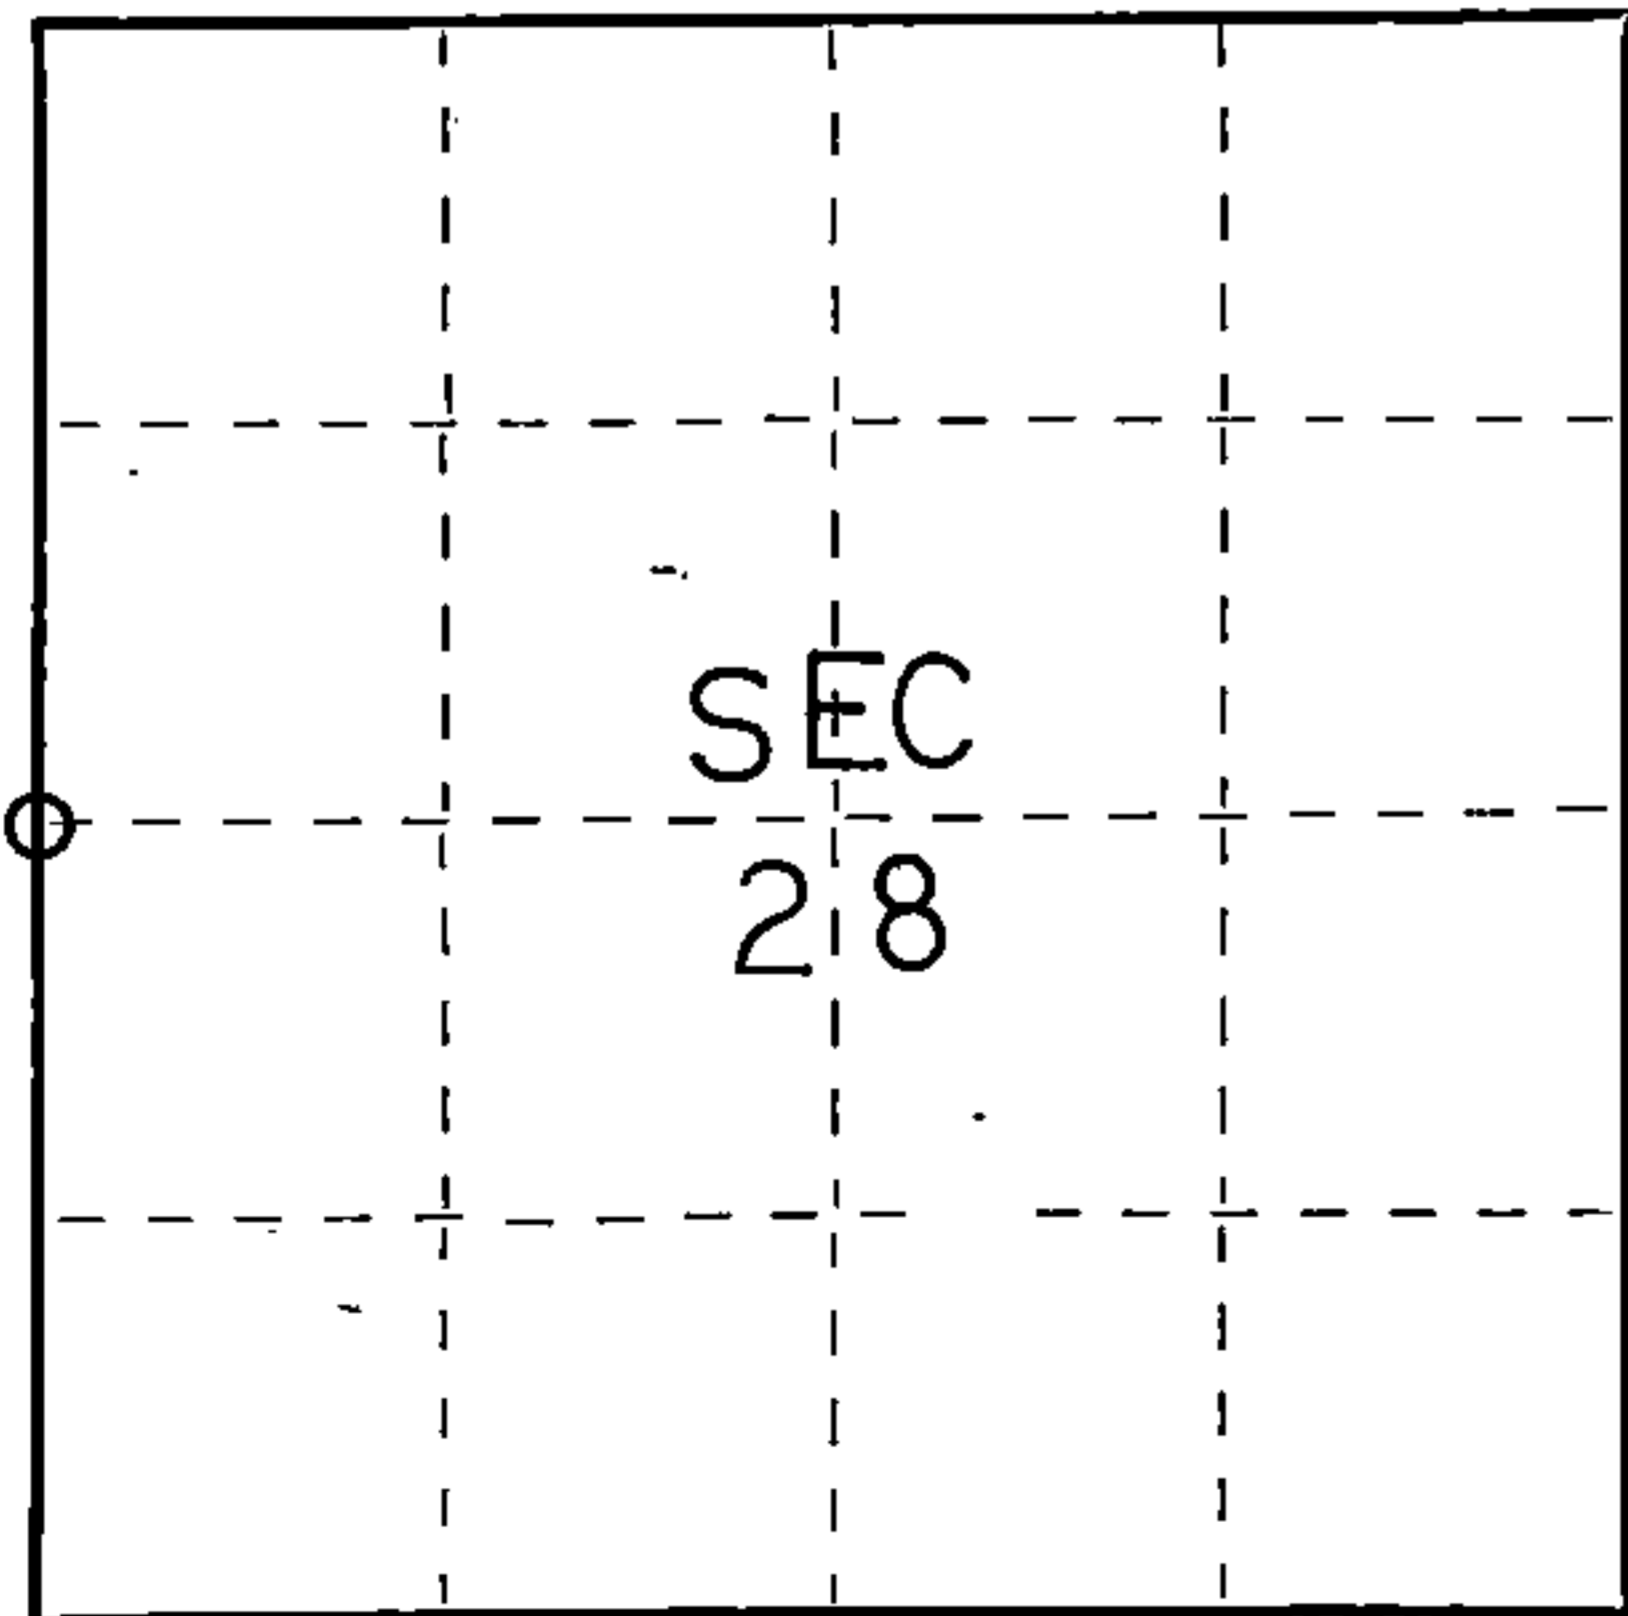

○ = Corner monument restored.

History of original corner establishment:

Original subdivision by James Nowlin Sept. 11 - Sept. 21, 1865

Hemlock 18 N35E 15 Lks.
Hemlock 24 N68W 27 Lks.

Description of corner evidence found:

2" iron pipe 5' long with brass cap set by C.E. Walker in 1940

Description of monument and accessories I established to perpetuate the original location of this corner.

Left monument set by Walker

Ties:

Balsam 8 N29E 10.00 Feet
Balsam 6 S59E 7.22 Feet
W. Birch 6 S35W 13.22 Feet



A 3513292000

Dated at Grandon, Wis., this 8th day of January, 1976.

Signature Thomas Arnott Title Surveyor Registration No. S-887
(County Surveyor, Registered Land Surveyor, or other duly authorized official)

Office of Register of Deeds, County of Forest, I hereby certify that the within instrument was filed in this office for record on the 8th day of January, 1976 at 11 o'clock A.M.

Eugene Staszny Document Number 108527
(Register of Deeds)

By Deputy

FORM 985 R. C. MILLER CO., MILWAUKEE