

CERTIFIED LAND CORNER RESTORATION

Index No. V-33


State of Wisconsin }
County of Forest } ss.

I Thomas R. Arnott, do hereby certify that on the 22nd day of September, 19 75, I found evidence of the 1/4 corner of sections 30 & 31 Township 35, North, Range 13 E, Fourth Principal Meridian, as described hereon; and that from this evidence I established a new monument and accessories as described hereon to perpetuate the original location of this corner.

Resident witnesses:

Herbert Wagoner

FORM 985 H. C. MILLER CO., MILWAUKEE

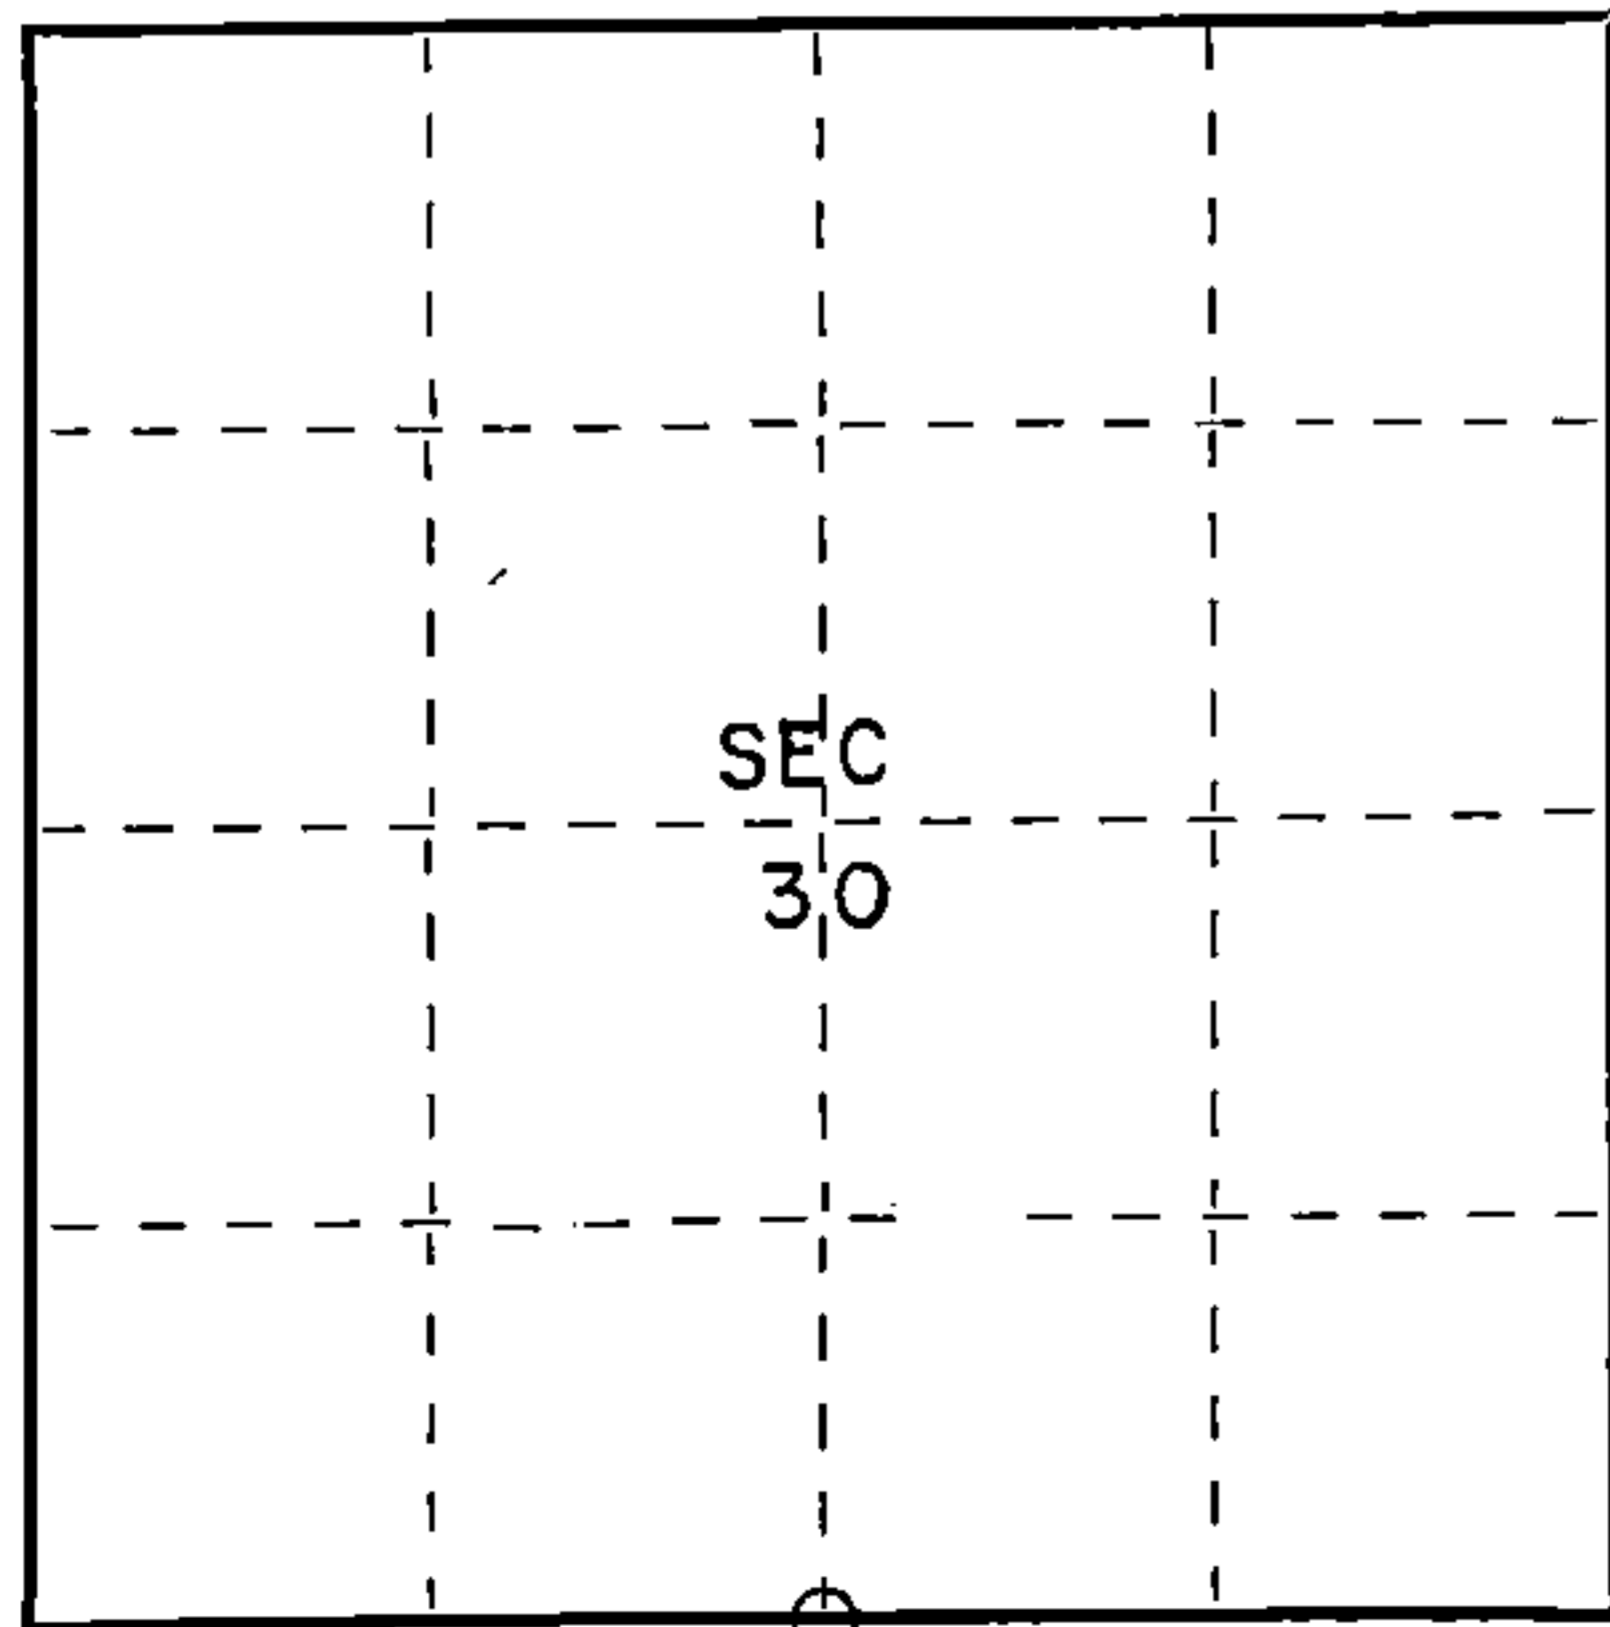

○ = Corner monument restored.

History of original corner establishment:

Original subdivision by James L. Nowlin Sept. 11- Sept. 21, 1865

Maple 14 N20W 21 Lks.
Birch 16 S57W 13 Lks.

Description of corner evidence found:

2" iron pipe found



43513300020

Description of monument and accessories I established to perpetuate the original location of this corner.

reset iron pipe with new Forest County aluminum monument

Ties:

W. Birch 10" N31E 26.04 feet (BT found)
Maple 8" N61W 29.96 feet
Maple S62 S32W 24.64 feet

Dated at Crandon, Wis., this 30th day of October, 19 75

Signature Thomas R. Arnott Title Land Surveyor Registration No. S-887
(County Surveyor, Registered Land Surveyor, or other duly authorized official)

Office of Register of Deeds, County of Forest, I hereby certify that the within instrument was filed in this office for record on the 30th day of October, 19 75 at 1 o'clock P. M.

Eugene Staszny Document Number 108110
(Register of Deeds)

By _____ Deputy