

CERTIFIED LAND CORNER RESTORATION

Index No. **X 79**

State of Wisconsin }
County of Forest } ss.

I Thomas R. Arnott, do hereby certify that on the 20th day of September, 19 75, I found evidence of the 1/4 corner of sections 32 & 33 Township 35, North, Range 13 E, Fourth Principal Meridian, as described hereon; and that from this evidence I established a new monument and accessories as described hereon to perpetuate the original location of this corner.

Resident witnesses:

Herbert Wagoner


History of original corner establishment:

Original subdivision by James L. Nowlin 11 Sept. - 21 Sept., 1865

Birch 15 S76E 32 Lks.
Sugar 12 S80W 14 Lks.

Description of corner evidence found:

1 3/4" iron pipe found

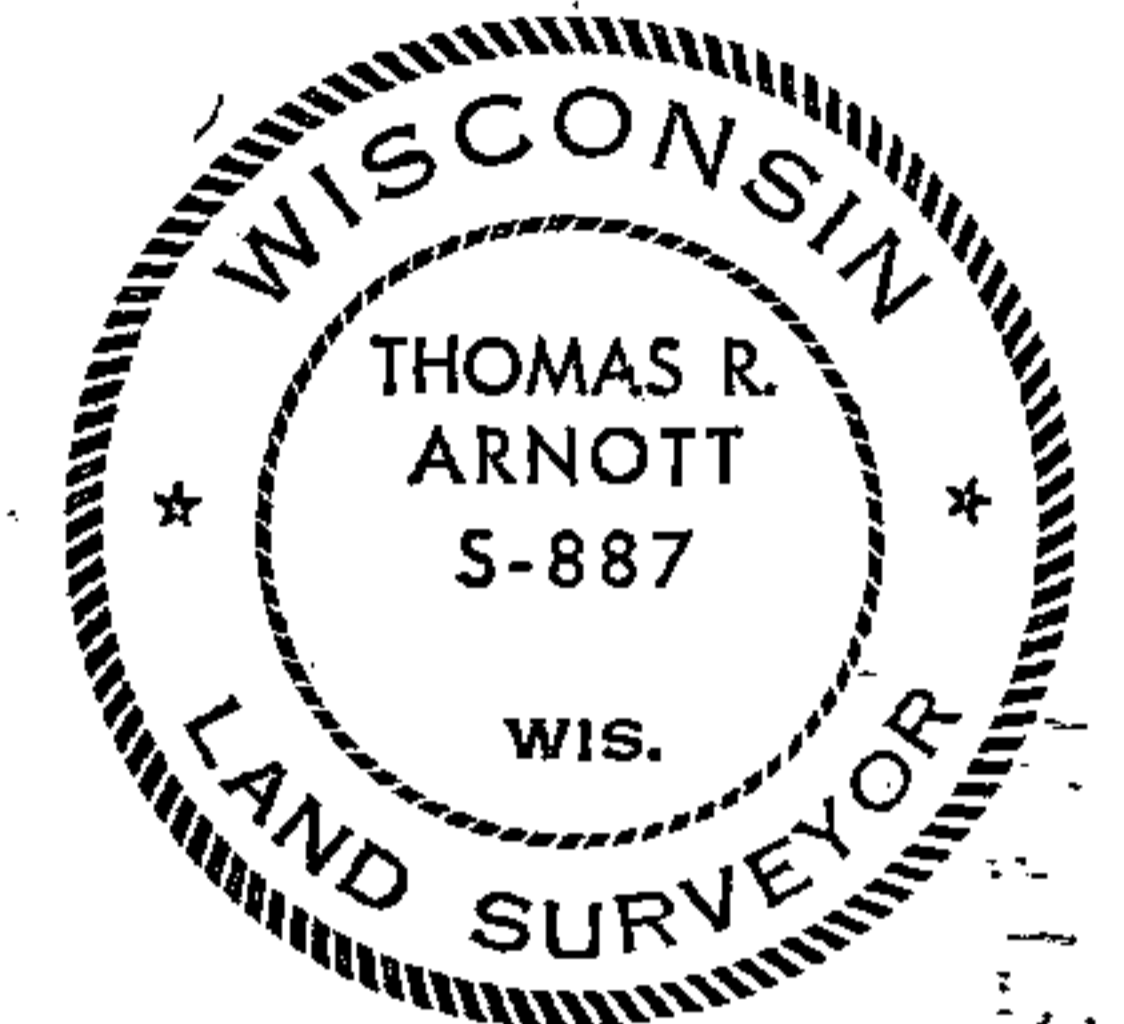


Description of monument and accessories I established to perpetuate the original location of this corner.

Reset corner with new Forest County aluminum monument

Ties:

Maple 6" N77E 4.73 feet (BT found)
Ash 16" S50W 7.45 feet (BT found)

FORM 985 H. C. MILLER CO., MILWAUKEE

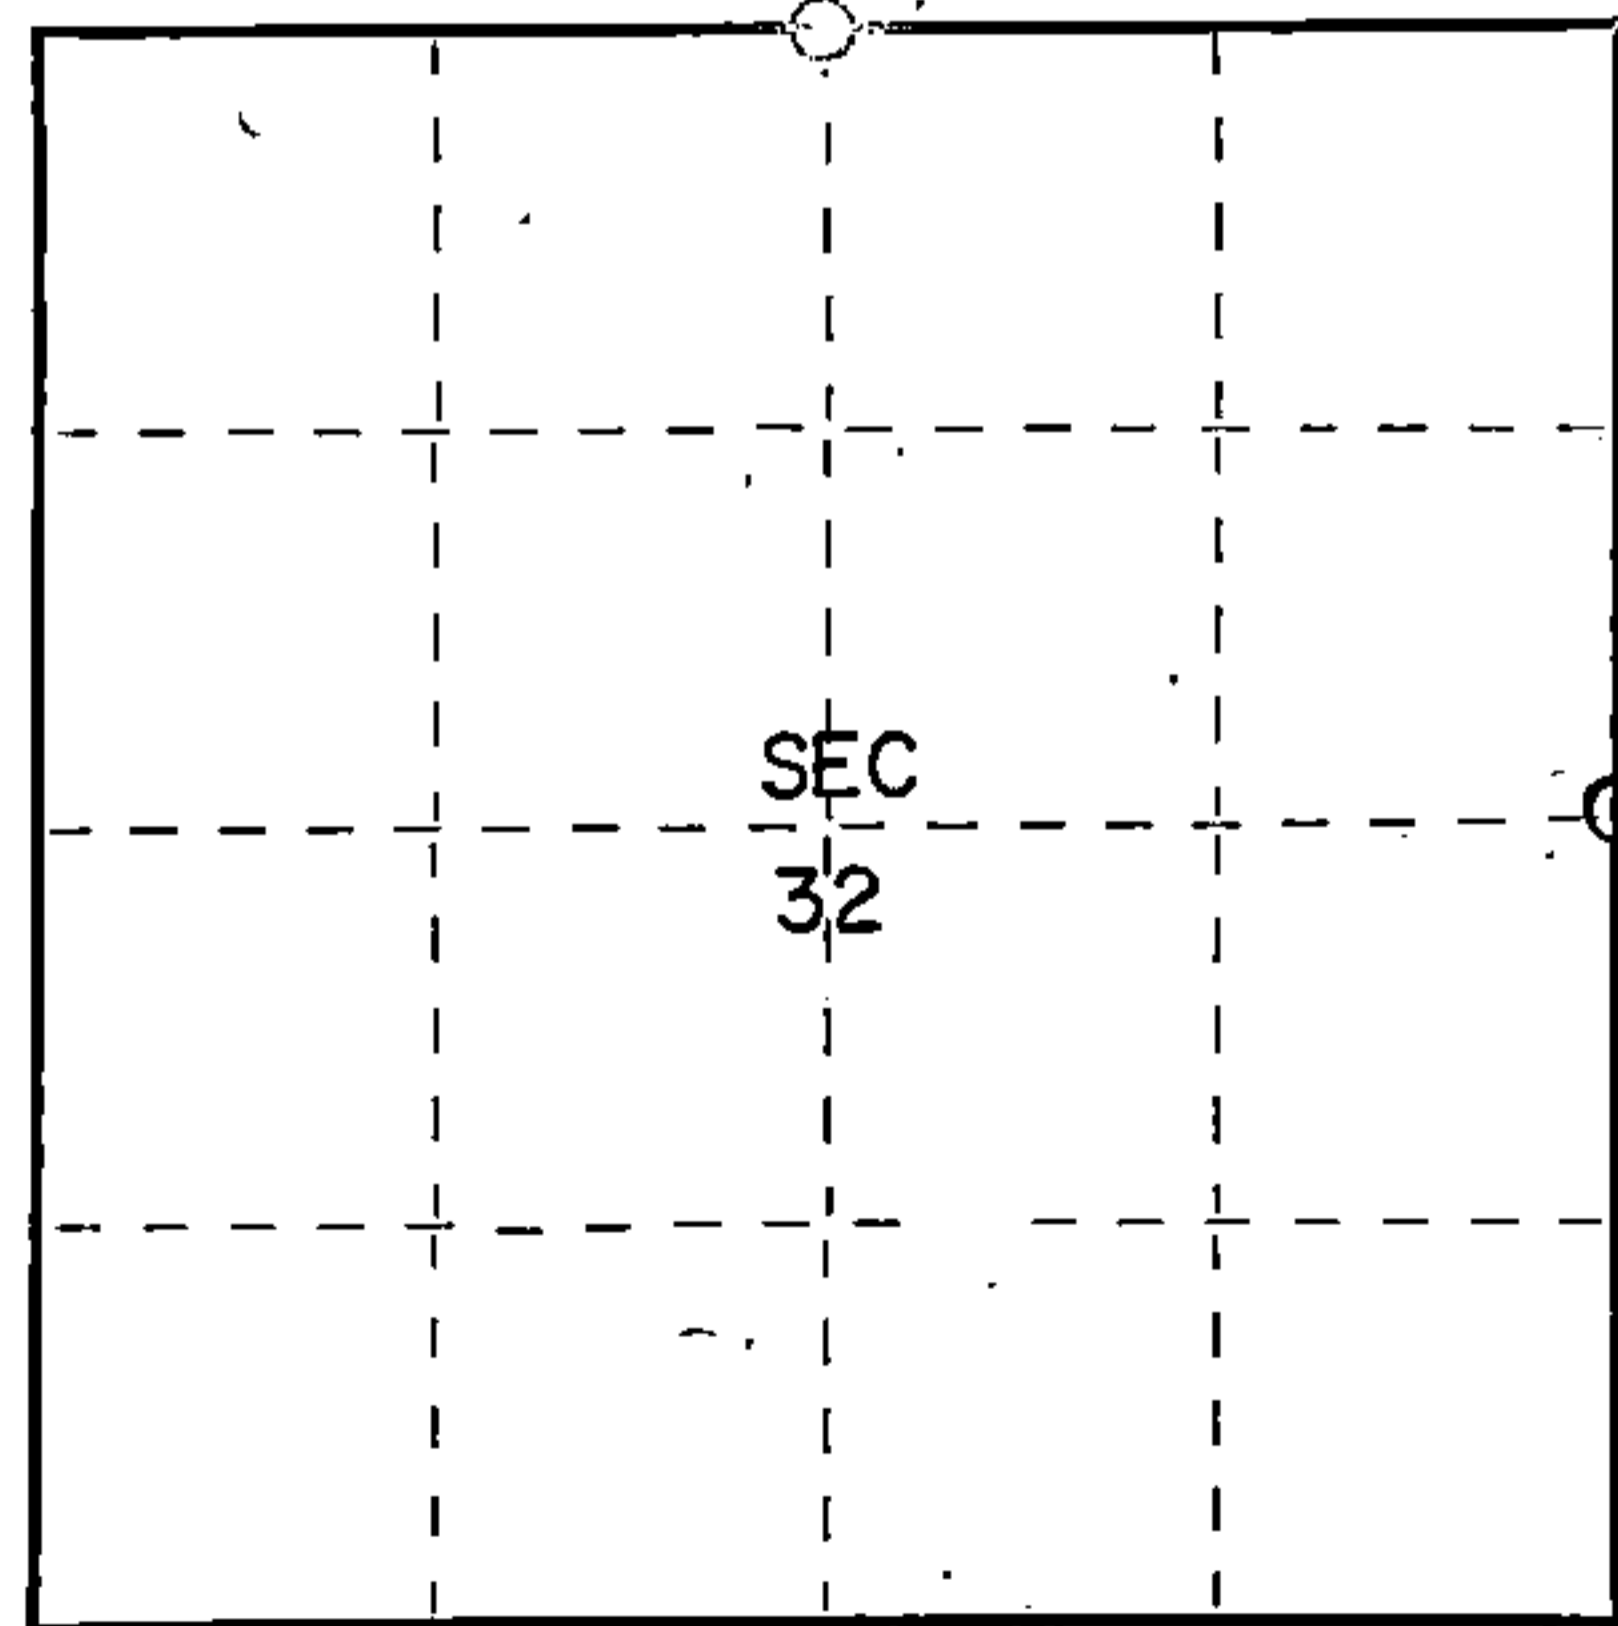

○ = Corner monument restored.

Dated at Crandon, Wis., this 30th day of October, 19 75.

Signature Thomas R. Arnott Title Land Surveyor Registration No. S-887
(County Surveyor, Registered Land Surveyor, or other duly authorized official)

Office of Register of Deeds, County of Forest, I hereby certify that the within instrument was filed in this office for record on the 30th day of October, 19 75 at 3 o'clock P. M.

Eugene Stutzman
(Register of Deeds)
By _____ Deputy

Document Number **108124**

A 351332 2000