

CERTIFIED LAND CORNER RESTORATION

Index No. **A-13**  
**A 13**

State of Wisconsin }  
County of FOREST } ss.

I INEAL SPERHAKE, do hereby certify that on the TWELFTH day of DECEMBER, 1962, I found evidence of the NORTHWEST SECTION corner of SECTION 3 Township 34, North, Range 13 EAST, Fourth Principal Meridian, as described hereon; and that from this evidence I established a new monument and accessories as described hereon to perpetuate the original location of this corner.

Resident witnesses:

Richard Piontek - Waubesa

History of original corner establishment:

This corner can also be described as: THE SECTION CORNER COMMON TO SECTION 3 AND 4, T34N-R13E, AND SECTIONS 33 AND 34, T35N-R13E, 4TH P.M.

This corner was established during the original survey of this township, as noted in the Original Field Notes for the Original Survey of T35N-R13E, 4th P.M.

Description of corner evidence found:

The original bearing tree, described in the original field notes as:

"Y. Birch 18 N45E 28 links"

is still present at this date, with a portion of the original scribe marks still visible.

Description of monument and accessories I established to perpetuate the original location of this corner.

At the site of the original post, as determined from the existing original bearing tree noted above, I emplaced a "Galvanized iron pipe, three feet long, one inch in diameter, with an aluminum cap denoted as, "Kimberly-Clark Corp T34-35N 33, 34, 3, 4, R13E Sperhake RLS 463 12-12-62".

The pipe is witnessed by:


- Maple 12 N62°E 56½ links. (Scribed S34 NBT).
- Maple 4 S58°E 30 links. (Scribed S 3NBT).
- Basswood 4 S50°W 40 links. (Scribed S 4 NBT).
- Maple 4 N35°W 27 links. (Scribed S33 NBT).

Dated at Crandon, Wis., this 11th day of April, 1963.

Signature [Signature] Title Registered Land Surveyor Registration No. S-463  
(County Surveyor, Registered Land Surveyor, or other duly authorized official)

~~Official of Registrar of Deeds~~ County of Forest, I hereby certify that the within instrument was ~~signed and sworn to~~ signed and sworn to on the 11th day of April, 1963.

~~at~~ ~~clock~~ ~~Mr~~  
Adeline De Noble  
Notary Public ~~(Assistant Deed)~~ Forest County, Wis  
My commission expires February 6, 1966 My Commission Expires ~~Depend~~

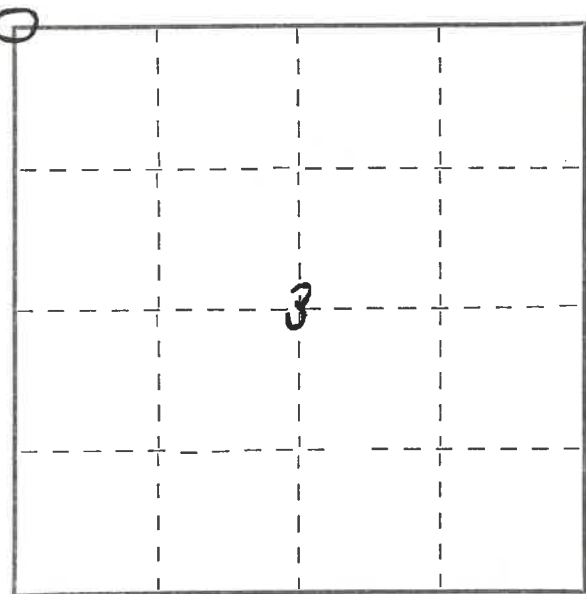


○ = Corner monument restored.

FORM 985 H. C. MILLER CO., MILWAUKEE

43513330000  
Surveyor's Seal

86985

REGISTER'S OFFICE  
FOREST COUNTY, WIS.

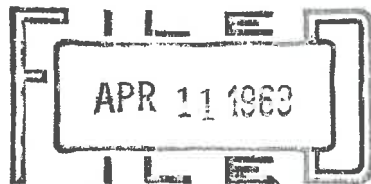

At 2 o'clock P. M.  
Karl A. Lange Register of Deeds  
sp.