

CERTIFIED LAND CORNER RESTORATION


Index No. X Y 13

State of Wisconsin }
County of FOREST } ss.

I NEAL SPERHAKE, do hereby certify that on the THIRTIETH day of SEPTEMBER, 19 64, I found evidence of the SOUTHWEST MEANDER corner of SECTION 34 Township 35, North, Range 13 EAST, Fourth Principal Meridian, as described hereon; and that from this evidence I established a new monument and accessories as described hereon to perpetuate the original location of this corner.

Resident witnesses:

.....
.....
.....

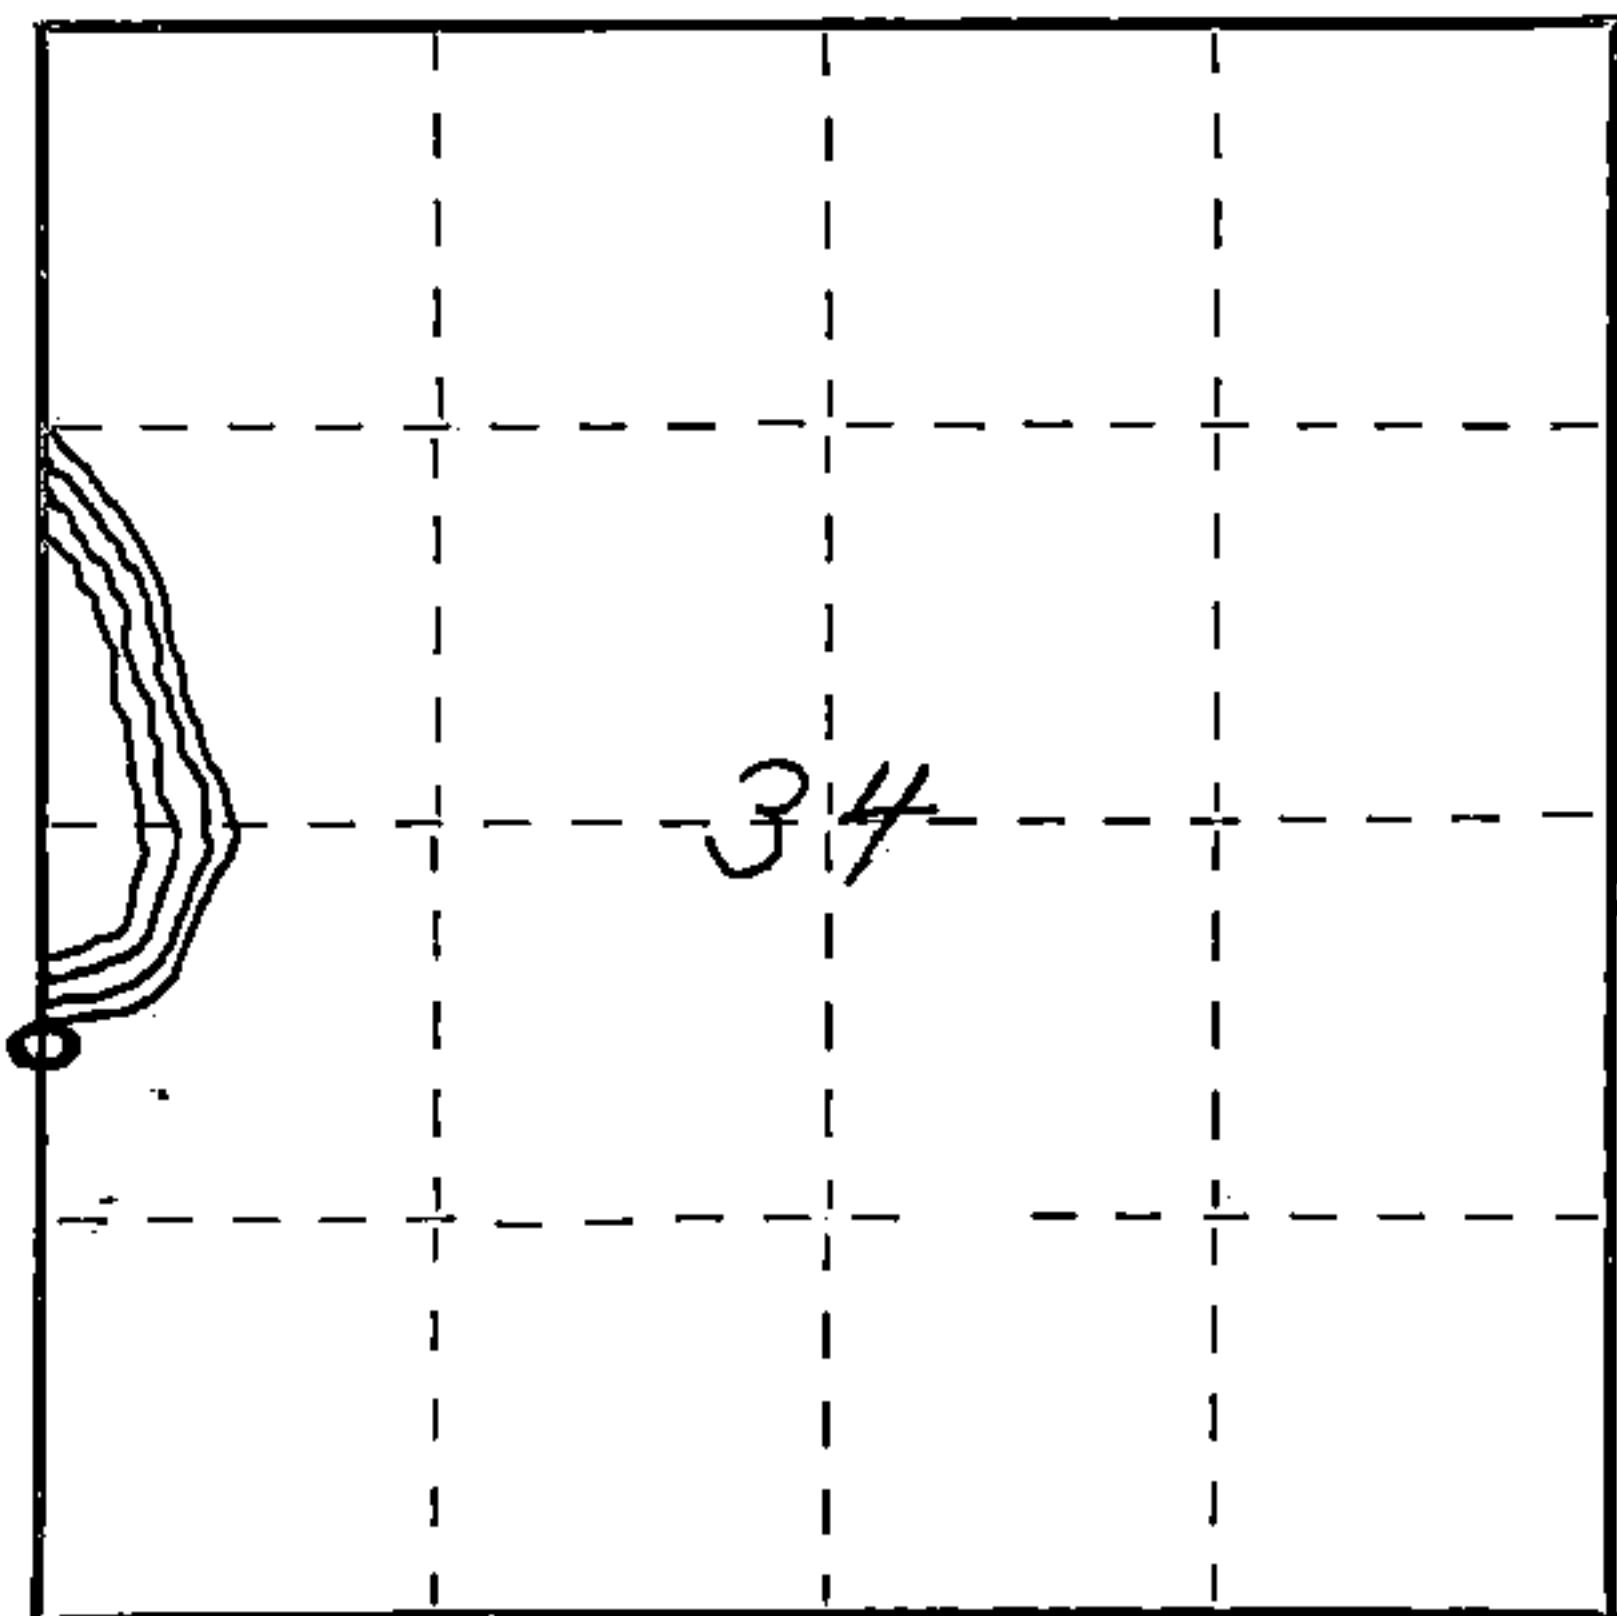

○ = Corner monument restored.

History of original corner establishment: This corner can also be described as: "THE MEANDER CORNER ON THE SOUTH SIDE OF GROUND HEMLOCK LAKE BETWEEN SECTIONS 33 AND 34, T35N-R13E, 4th. p.m.

This corner was established during the original survey of this township, as noted in the original field notes for the original survey of T35N-R13E, 4th. p.m.

Description of corner evidence found:

The stump of the original bearing tree, described in the original field notes as:

"Cedar 6 S 59°W 15 links."

is still present at this date, with a portion of the original scribe marks still visible.

Description of monument and accessories I established to perpetuate the original location of this corner.

At the site of the original post, as determined from the existing original bearing tree noted above, I emplaced a "Galvanized iron pipe, three feet long, one inch in diameter, with aluminum cap denoted as, 'Kimberly-Clark Corp. T35N MC BTWN. 33 & 34 R13E SPERHAKE RLS 463 9/30/64."

The pipe is witnessed by:

Hemlock 7 N 59°W 25 links. (SCRIBED S33 MC NBT).

Hemlock 5 S 67°E 16 links. (SCRIBED S34 MC NBT).

Dated at _____ Wis, this _____ day of _____, 19 _____

Signature Neal Sperhake Title Registered Land Surveyor Registration No. 463
(County Surveyor, Registered Land Surveyor, or other duly authorized official)

~~Office of Register of Deeds~~, County of Forest, State of Wis., I hereby certify that the within instrument was ~~filed in this office for record~~ on the 12th day of January, 19 65
~~at _____~~ signed and sworn to before me.

Anna Peterson
Notary Public (Register of Deeds)

By _____ Deputy

FORM 985 H. C. MILLER CO., MILWAUKEE

43513331500

Handwritten signature

89614

REGISTER'S OFFICE
FOREST COUNTY, WIS.

FILED
JAN 12 1965
FILED

M. 9 o'clock A. M.
Anna Peterson Register of Deeds