

State of Wisconsin
County of FOREST

ss. ESTABLISHMENT OF QUARTER - QUARTER SECTION CORNER BETWEEN ORIGINAL GOVERNMENT SURVEY CORNERS.

I NEAL SPERHAKE, do hereby certify that on the TWENTY-FIRST day of NOVEMBER 1963, I established the EAST ONE SIXTEENTH CORNER BETWEEN SECTIONS 3, TOWNSHIP 34 NORTH, RANGE 13 EAST AND SECTION 34, TOWNSHIP 35 NORTH, RANGE 13 EAST, Fourth Principal Meridian, as described hereon

History: There is no record of this corner having ever been previously established.

Description of monument and accessories I established to perpetuate the location of this corner:


At the point determined for the location of the corner I emplaced a:

GALVANIZED IRON PIPE, THREE FEET LONG, ONE INCH IN DIAMETER, WITH AN ALUMINUM CAP DENOTED AS, "KIMBERLY-CLARK CORP. T34-35N E 1/16 BTWN. 3 & 34 R13E SPERHAKE RLS 463 11/21/63."

The pipe is witnessed by:

Maple 11 N 03°E 40 links. (SCRIBED S34 BT).
Maple 6 S 26°E 35 links. (SCRIBED S 3 BT).

Description as to how corner was located: The section corner 1/4 mile east and the quarter corner 1/4 mile west have been previously established with a distance of 39.76 chains between them. Thus, set the east one-sixteenth corner 19.88 chains from either corner and on a straight line between them.

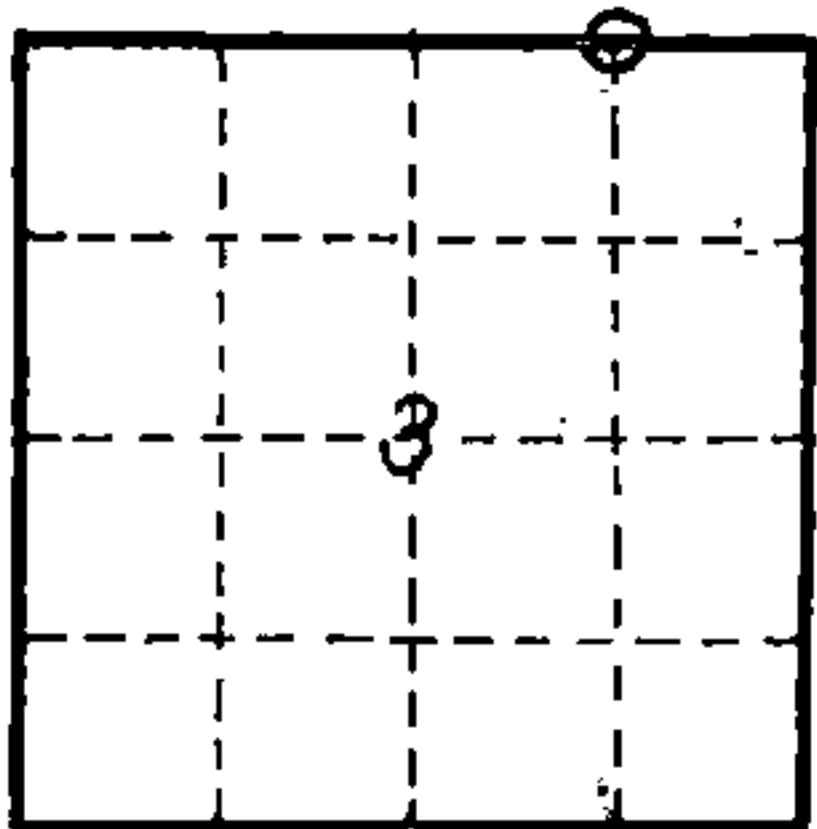

O = Corner monument restored

Subscribed & sworn to before me this 25 day of Aug. 1964.

Anna Peterson
Notary Public, Forest Co., Wis.
Com. expires 10/31/65

Resident witnesses _____

Dated at Crandon, Wisconsin, this 25 day of Aug., 1964.

Signature Neal Sperhake

Title Registered Land Surveyor Registration No. 463

Office of Register of Deeds County of Forest,
I hereby certify that the within instrument was filed in this office for record on the 25 day of Aug. (2 P.M.) 1964, and was filed in Book No. _____ Page No. _____ of County Records.

Surveyor's Seal

Signature Anna Peterson Title Reg. of Deeds

43513340010

88935

Index No. 1608