

State of Wisconsin  
County of Forest

ss. ESTABLISHMENT OF SOUTH QUARTER - QUARTER SECTION CORNER  
OF SECTION 34

I L. ERNEST GEORGE, do hereby certify that on the FIFTH day of AUGUST  
19 68, I established the SOUTH ONE SIXTEENTH CORNER ON THE NORTH-SOUTH QUARTER LINE OF  
SECTION 34, TOWNSHIP 35 NORTH, RANGE 13 EAST, Fourth Principal Meridian.  
as described hereon

History: There is no record of this corner having ever been previously established.

Description of monument and accessories I established to perpetuate the location of this corner:


At the point determined for the location of the corner, I emplaced a:

GALVANIZED IRON PIPE, THREE FEET LONG, ONE INCH IN DIAMETER, WITH ALUMINUM CAP DENOTED AS,  
"KIMBERLY-CLARK CORP. T35N S 1/16 of SEC. 34 R13E GEORGE RLS S-0309 8/5/69

The pipe is witnessed by:

- Maple 13 S 18°W 83 links. (SCRIBED S34 BT).
- Maple 12 S 71°E 65 links. (SCRIBED S34 BT).

Description as to how corner was located: The quarter corner 1/4 mile South and the center  
1/4 of Section 34 1/4 mile North have been previously set with a  
distance of 41.21 1/2 chains between them. Thus, set the south 1/16th  
corner of Section 34, 20.60-3/4 chains from either corner and on a  
straight line between them.

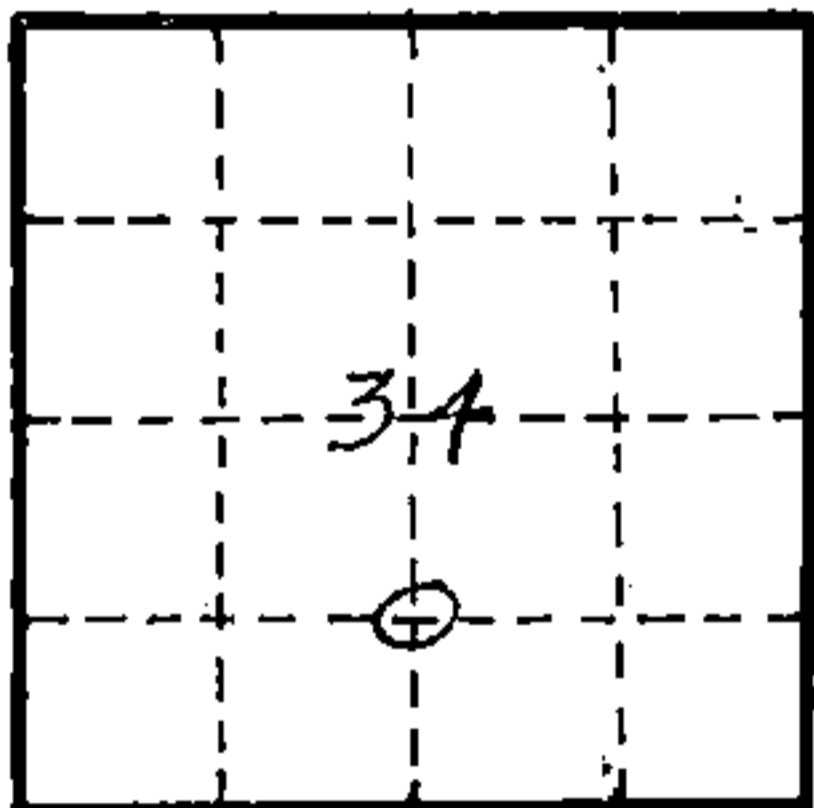

O = Corner monument  
restored

Resident witnesses \_\_\_\_\_

Dated at Crandon, Wisconsin, this 18th  
day of March, 19 74.

Signature L. Ernest George

Title Registered Land Surveyor Registration No. S 0309

Office of Register of Deeds County of Forest,  
I hereby certify that the within instrument was filed in this  
office for record on the 19th day of March  
19 74, and was filed in Book No. Corner Page No. Y-15  
of County Records. Restorations

Surveyor's Seal

Signature Eugene Stegny Title Register of Deeds

DOCUMENT NUMBER 105007

43513 34 1020

Index No. Y15