

State of Wisconsin

County of FOREST

ss. RESTORATION OF LOST ORIGINAL GOVERNMENT SURVEY CORNER.

I NEAL SPERHAKE, do hereby certify that on the SEVENTEENTH day of SEPTEMBER, 1964, I established the WEST QUARTER SECTION CORNER OF SECTION 35, TOWNSHIP 35 NORTH, RANGE 13 EAST, Fourth Principal Meridian, as described hereon.

History: This corner was established during the original survey of this township, as noted in the original field notes for the original survey of T35N-R13E, 4th. p.m.

Description of monument and accessories I established to perpetuate the location of this corner:


At the point determined for the location of the corner I emplaced a:

GALVANIZED IRON PIPE, THREE FEET LONG, ONE INCH IN DIAMETER, WITH ALUMINUM CAP DENOTED AS, "KIMBERLY CLARK CORP. T35N 1/4 BTWN. 34 & 35 R35E SPERHAKE RLS 463 9/17/64."

The pipe is witnessed by:

Maple 7 S 87°W 66 1/2 links. (SCRIBED 1/4 S 34 NBT).
Cherry 6 N 78°E 36 links. (SCRIBED 1/4 S 35 NBT).

Description as to how corner was located: No evidence of the original corner present. Thus, set by proportionate measurement. The distance between the previously established section corner of 26, 27, 34, 35 and the townline corner of 34, 35 is 80.46 1/2 chains. Thus, set the quarter corner 40.23 1/4 chains from either corner and on a straight line between them.

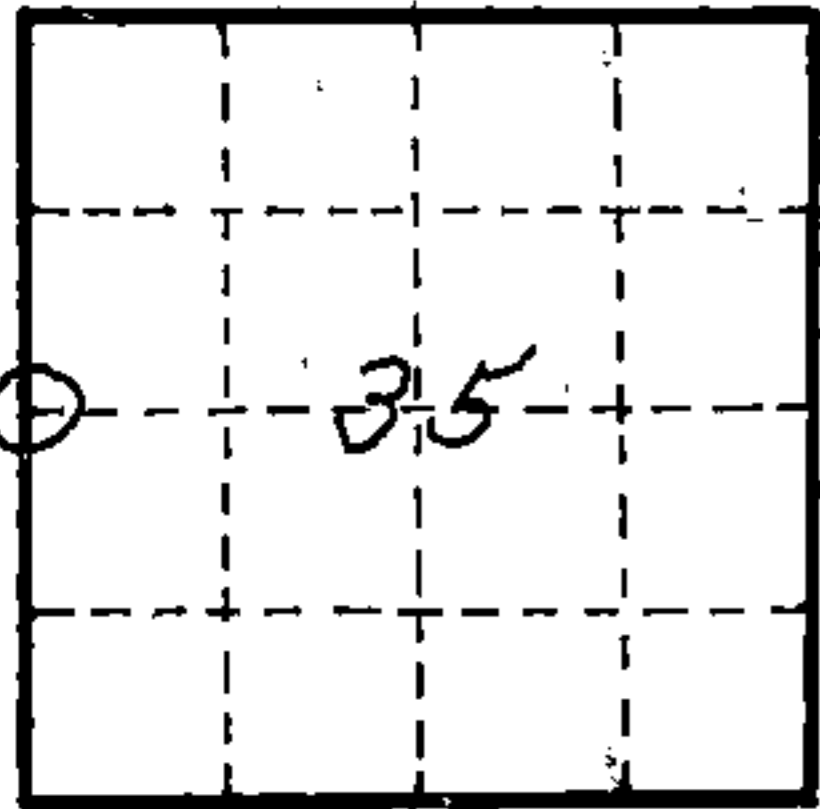

0 = Corner monument restored

89619

REGISTERED LAND SURVEYOR'S OFFICE
FOREST COUNTY, WIS.
JAN 12 1965
10:10 AM
Anna Peterson, Register of Deeds

Resident witnesses _____

Dated at Crandon, Wisconsin, this 12th day of January, 1965.

Signature Neal Sperhake

Title Registered Land Surveyor Registration No. 463

~~Office of~~ Forest County ~~of~~ Wisconsin,

I hereby certify that the within instrument was ~~filed in this~~ ~~office for record~~ on the 12th day of January 1965, and was ~~filed in Book No.~~ signed and ~~Page No.~~ sworn to ~~of County Records.~~ before me.

Surveyor's Seal

Signature Anna Peterson Title Notary Public

4351339 2000

Index No. X17