

State of Wisconsin  
County of FOREST

ss. ESTABLISHMENT OF CENTER QUARTER SECTION CORNER OF SECTION 34

I L. ERNEST GEORGE, do hereby certify that on the THIRD day of JUNE,  
19 68, I established the CENTER QUARTER SECTION CORNER OF SECTION 34, TOWNSHIP 35 NORTH,  
RANGE 13 EAST, Fourth Principal Meridian,  
as described hereon.

History: There is no record of this corner having ever been previously established.

Description of monument and accessories I established to perpetuate the location of this corner:


At the point determined for the location of the corner I emplaced a:

GALVANIZED IRON PIPE, THREE FEET LONG, ONE INCH IN DIAMETER, WITH ALUMINUM CAP DENOTED AS,  
"KIMBERLY-CLARK CORP. T35N CENTER 1/4 34, R13E GEORGE RLS S-0309 6/3/68."

The pipe is witnessed by:

- Hemlock 11 N 03°E 25 1/2 links. (SCRIBED S34 BT).
- Hemlock 13 S 63°E 14 1/2 links. (SCRIBED S34 BT).

Description as to how corner was located: The north, east and south quarter corners of section 34 have been previously established and the location of the quarter corner on the west side of section 34 (located in Ground Hemlock Lake) has been determined. Straight lines were run between opposite quarter corners and the center quarter of section 34 was set at the point of intersection of these lines. It is 40.87 chains north to the quarter corner between sections 27 and 34, 40.27 1/4 chains east to the quarter corner between sections 34 and 35, 41.21 1/2 chains south to the quarter corner between sections 34 and 3 on the town line and 39.02 1/2 chains west to where the quarter corner between sections 33 and 34 would be located if it were not in the lake. There is 29.70 chains between the center quarter of section 34 and an iron pipe located on the east-west quarter line of section 34 and 45 1/2 links east of the shoreline of Ground Hemlock Lake.

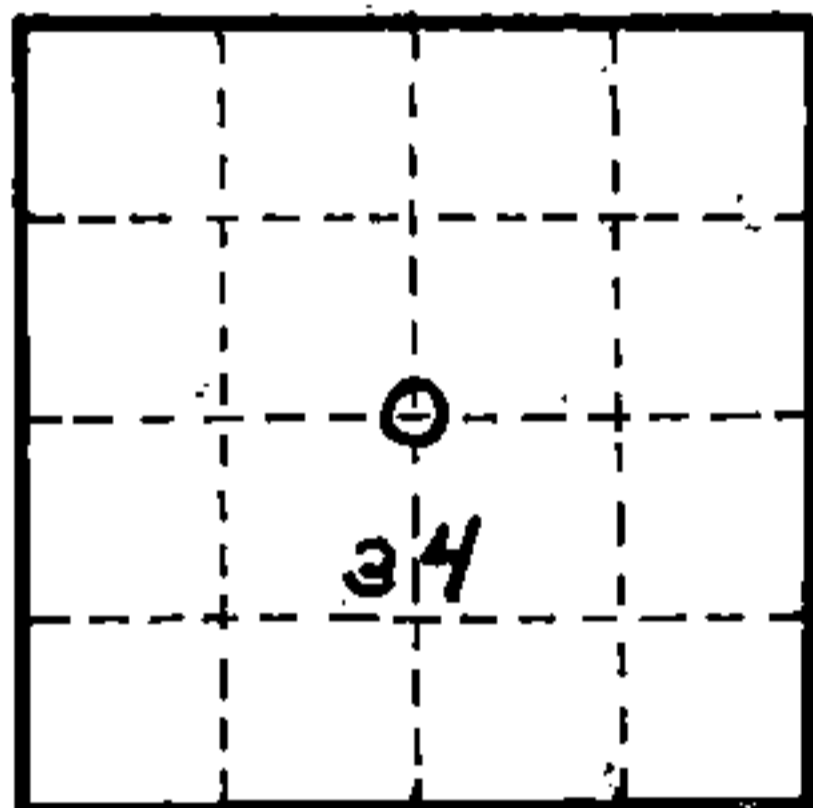

O = Corner monument restored

DOCUMENT NUMBER  
**95962**

Resident witnesses \_\_\_\_\_

Dated at Iron Mountain, Michigan, Wisconsin, this 20th  
day of December, 1968.

Signature L. Ernest George

Title Registered Land Surveyor Registration No. S-0309

Office of Register of Deeds County of Forest

I hereby certify that the within instrument was filed in this  
office for record on the 21st day of February  
19 69, and was filed in Book No. I of Page No. X-15  
of County Records. CORNER RESTORATIONS

Surveyor's Seal

Signature Eugene Staszny Title Register of Deeds

43513 34 2020

Index No. **X15**