

State of Wisconsin  
County of FOREST

ss. ESTABLISHMENT OF CENTER OF NORTHWEST QUARTER OF SECTION 34.

I L. ERNEST GEORGE, do hereby certify that on the THIRD day of JUNE, 1968, I established the CENTER OF THE NORTHWEST QUARTER OF SECTION 34, TOWNSHIP 35 NORTH, RANGE 13 EAST, Fourth Principal Meridian, as described hereon.

History: There is no record of this corner having ever been previously established.

Description of monument and accessories I established to perpetuate the location of this corner:


At the point determined for the location of the corner I emplaced a:

GALVANIZED IRON PIPE, THREE FEET LONG, ONE INCH IN DIAMETER, WITH ALUMINUM CAP DENOTED AS, "KIMBERLY-CLARK CORP. T35N CENTER NW $\frac{1}{4}$  34 R13E GEORGE RLS S-0309 6/3/68."

The pipe is witnessed by:

Y. Birch 5 N 53<sup>0</sup>E 12 $\frac{1}{2}$  links. (SCRIBED S34 BT).  
Maple 5 S 50<sup>0</sup>W 12 links. (SCRIBED S34 BT).

Description as to how corner was located: The N 1/16th corner between sections 33 and 34; the W 1/16th corner between sections 27 and 34; the N 1/16th corner of section 34 and the W 1/16th corner of section 34, have been previously set. Straight lines were run between the opposite 1/16th corners and the center of the NW quarter of section 34 was set at the point of intersection of these two straight lines. It is 20.71 chains north to the W 1/16th corner between sections 27 and 34; 19.39 chains west to the N 1/16th corner between sections 33 and 34; 20.53-3/4 chains south to the W 1/16th corner of section 34 and 19.92 chains east to the N 1/16th corner of section 34.

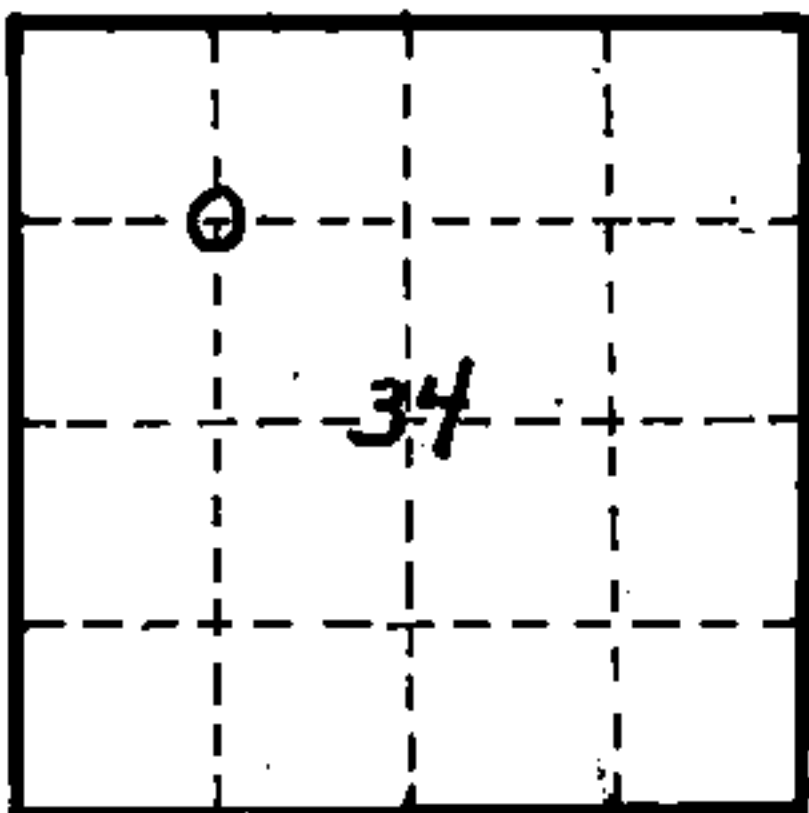

O = Corner monument  
restored

DOCUMENT NUMBER  
95965

Resident witnesses \_\_\_\_\_

Dated at Iron Mountain, Michigan, Wisconsin, this 20th day of December, 1968.

Signature L. Ernest George

Title Registered Land Surveyor Registration No. S-0309

Office of Register of Deeds County of Forest

I hereby certify that the within instrument was filed in this office for record on the 21st day of February 1969, and was filed in Book No. 1 of \_\_\_\_\_ Page No. W-14 of County Records. CORNER RESTORATIONS

Surveyor's Seal

Signature Eugene Stutzman Title Register of Deeds

43513343030

Index No. W 14