

86982

RESTORATION OF LOST ORIGINAL GOVERNMENT SURVEY CORNER

Index No. 123

719

STATE OF WISCONSIN

I NEAL SPERHAKE, do hereby certify that on the TWELFTH day of DECEMBER, 1962, I restored the SOUTH QUARTER SECTION CORNER of SECTION 35, TOWNSHIP 35 NORTH, RANGE 13 EAST, Fourth Principal Meridian, as described hereon.

Resident Witnesses:

Richard Piontek - Waubesa.

History of original corner establishment:

This corner was established during the original survey of this township, as noted in the Original Field Notes for the Original Survey of T35N-R13E, 4th P.M.

Description of monument and accessories I established to perpetuate the location of this corner:

At the point determined for the location of the corner I emplaced a:


"GALVANIZED IRON PIPE, THREE FEET LONG, ONE INCH IN DIAMETER, WITH AN ALUMINUM CAP DENOTED AS, 'KIMBERLY-CLARK CORP T34-35N 1/4 BTWN 2 & 35 R13E SPERHAKE RLS 463 12-12-62".

The pipe is witnessed by:

- B. Ash 5 N 6°W 25 links. (Scribed S35 NBT).
- Spruce 5 S66°E 29 links. (Scribed S 2 NBT).


Description as to how corner was located:

No evidence of original corner present. Thus, set by proportionate measurement between the previously established section corners one half mile east and west, respectively. The distance between the corners is 80.03 chains. Therefore, the 1/4 corner was set 40.01½ chains from either section corner, on a straight line between them.

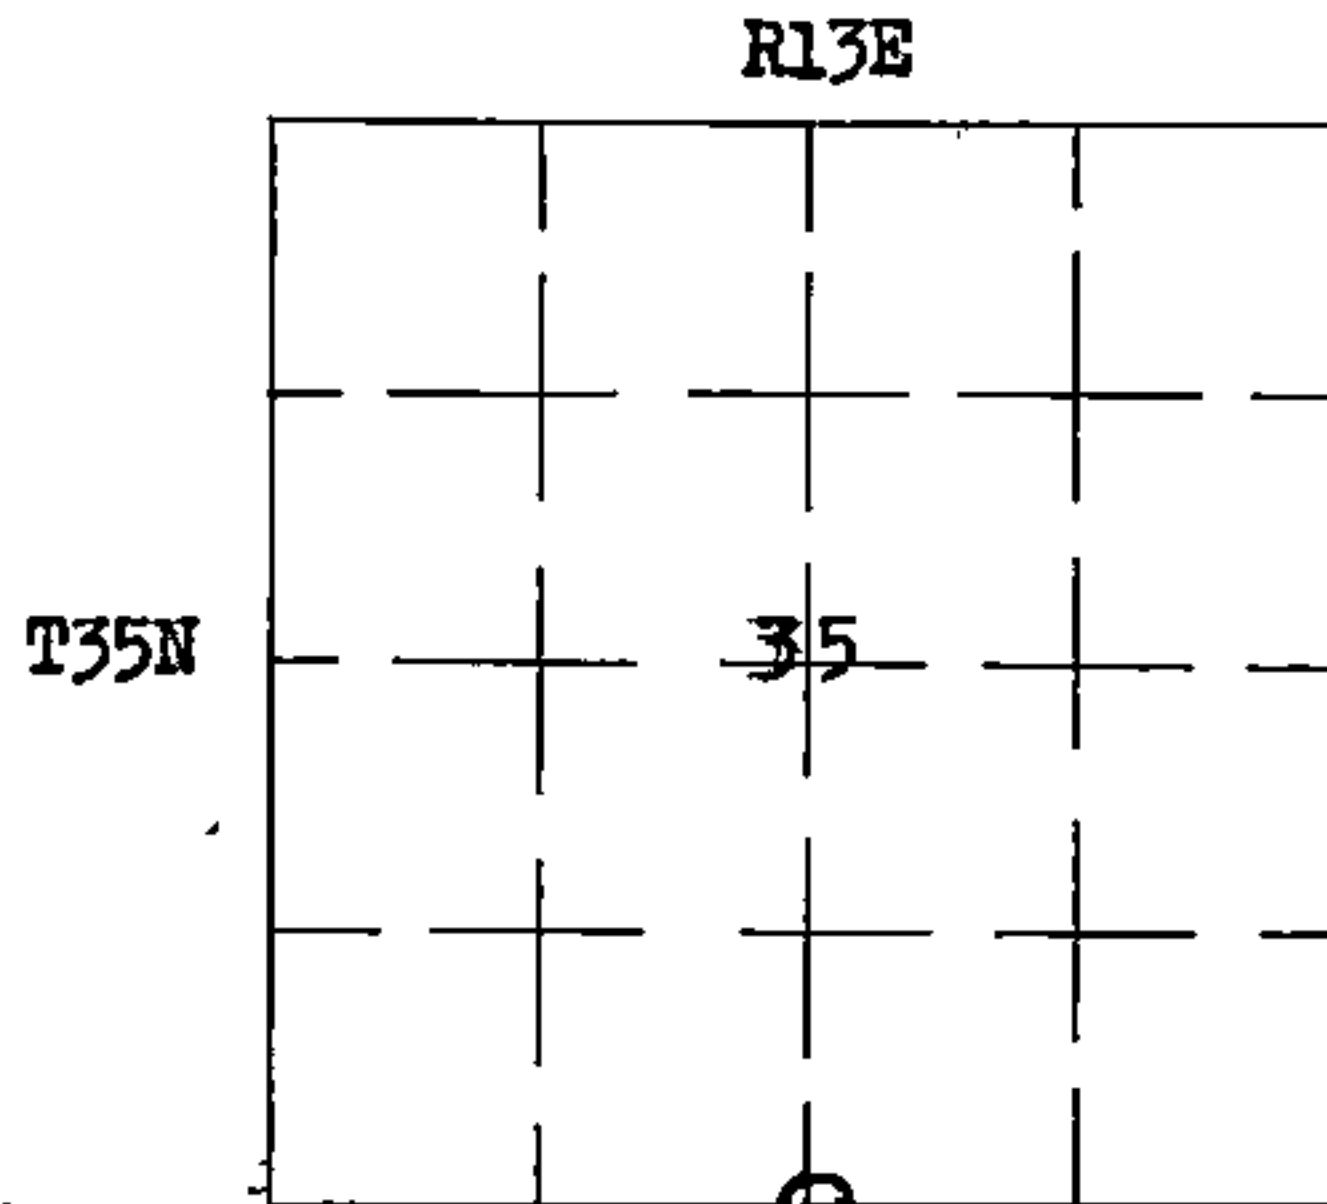

0 = Corner monument restored

REGISTER'S OFFICE
FOREST COUNTY, WIS.

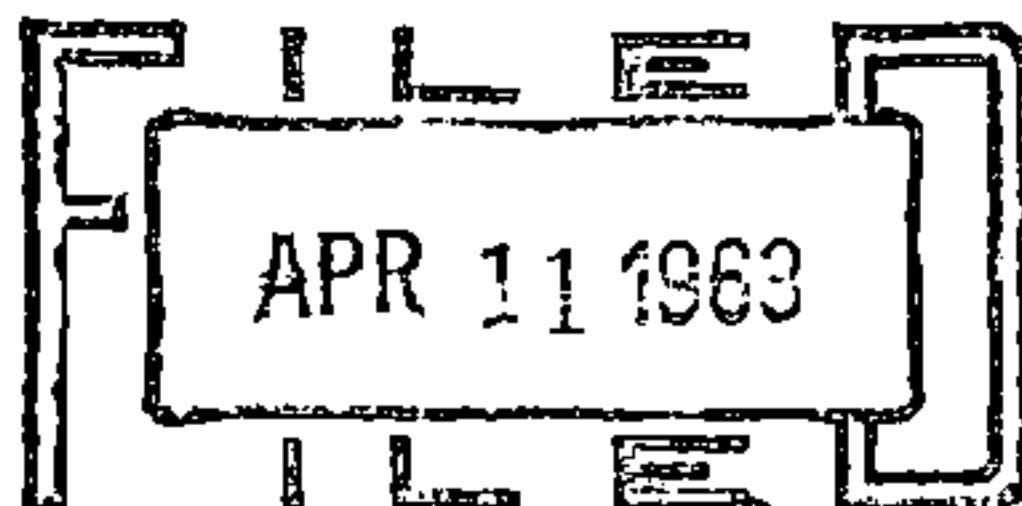

At 2 o'clock P.M.
Karl A. Unger Register of Deeds
By Sy.

Dated at Crandon, Wis., this 11th day of April, 19 63

Signature Neal Sperhake Title Registered Land Surveyor Registration No. S-463

~~Office of Register of Deeds~~, County of Forest, I hereby certify that the within instrument was ~~filed in this office for record~~ signed and sworn to on the 11th day of April, 19 63

~~BY~~ Adeline DeNoble ~~My~~

Adeline DeNoble
Notary ~~(Register of Deeds)~~ Public
Forest County Wisconsin
~~My~~ My commission expires Deputy
My Commission Expires
February 6, 1966

43513350020

Surveyor's Seal