

CERTIFIED LAND CORNER RESTORATION

Index No. **Y-19**

State of Wisconsin }
Forest } ss.
County of _____
Glen Barker

History of original corner establishment:

No evidence of any previous corner.

I, _____, do hereby
certify that on the 1st day
of April, 19 83, I found
~~evidence of the~~ SC 1/16
corner of Section 35
Township 35, North, Range
13 East, Fourth Principal Meridian,
as described hereon; and that from this evidence
I established a new monument and accessories
as described hereon to perpetuate the original
location of this corner.

Description of corner evidence found:

Total distance from 1/4 corner between section 2 & 35 T34 & 35N R13E to C 1/4 section 35 is 2638.06 ft.

Set SC 1/16 1319.03 ft. intermediate.

Resident witnesses:

J. Claflin - R.

H. Wagoner



Description of monument and accessories I established to perpetuate the original location of this corner.

Set a 1" iron pipe with 2" diameter alloy cap stamped:

Monument projects 18" above ground

S1682

Marked NBTs

T35N R13E

Maple 7" S2°W 2.96 ft.

S 35


Maple 7" S85E 14.56 ft.

SC 1/16

Scribed 1/16 - B.T.

CPI - 1983

T35N

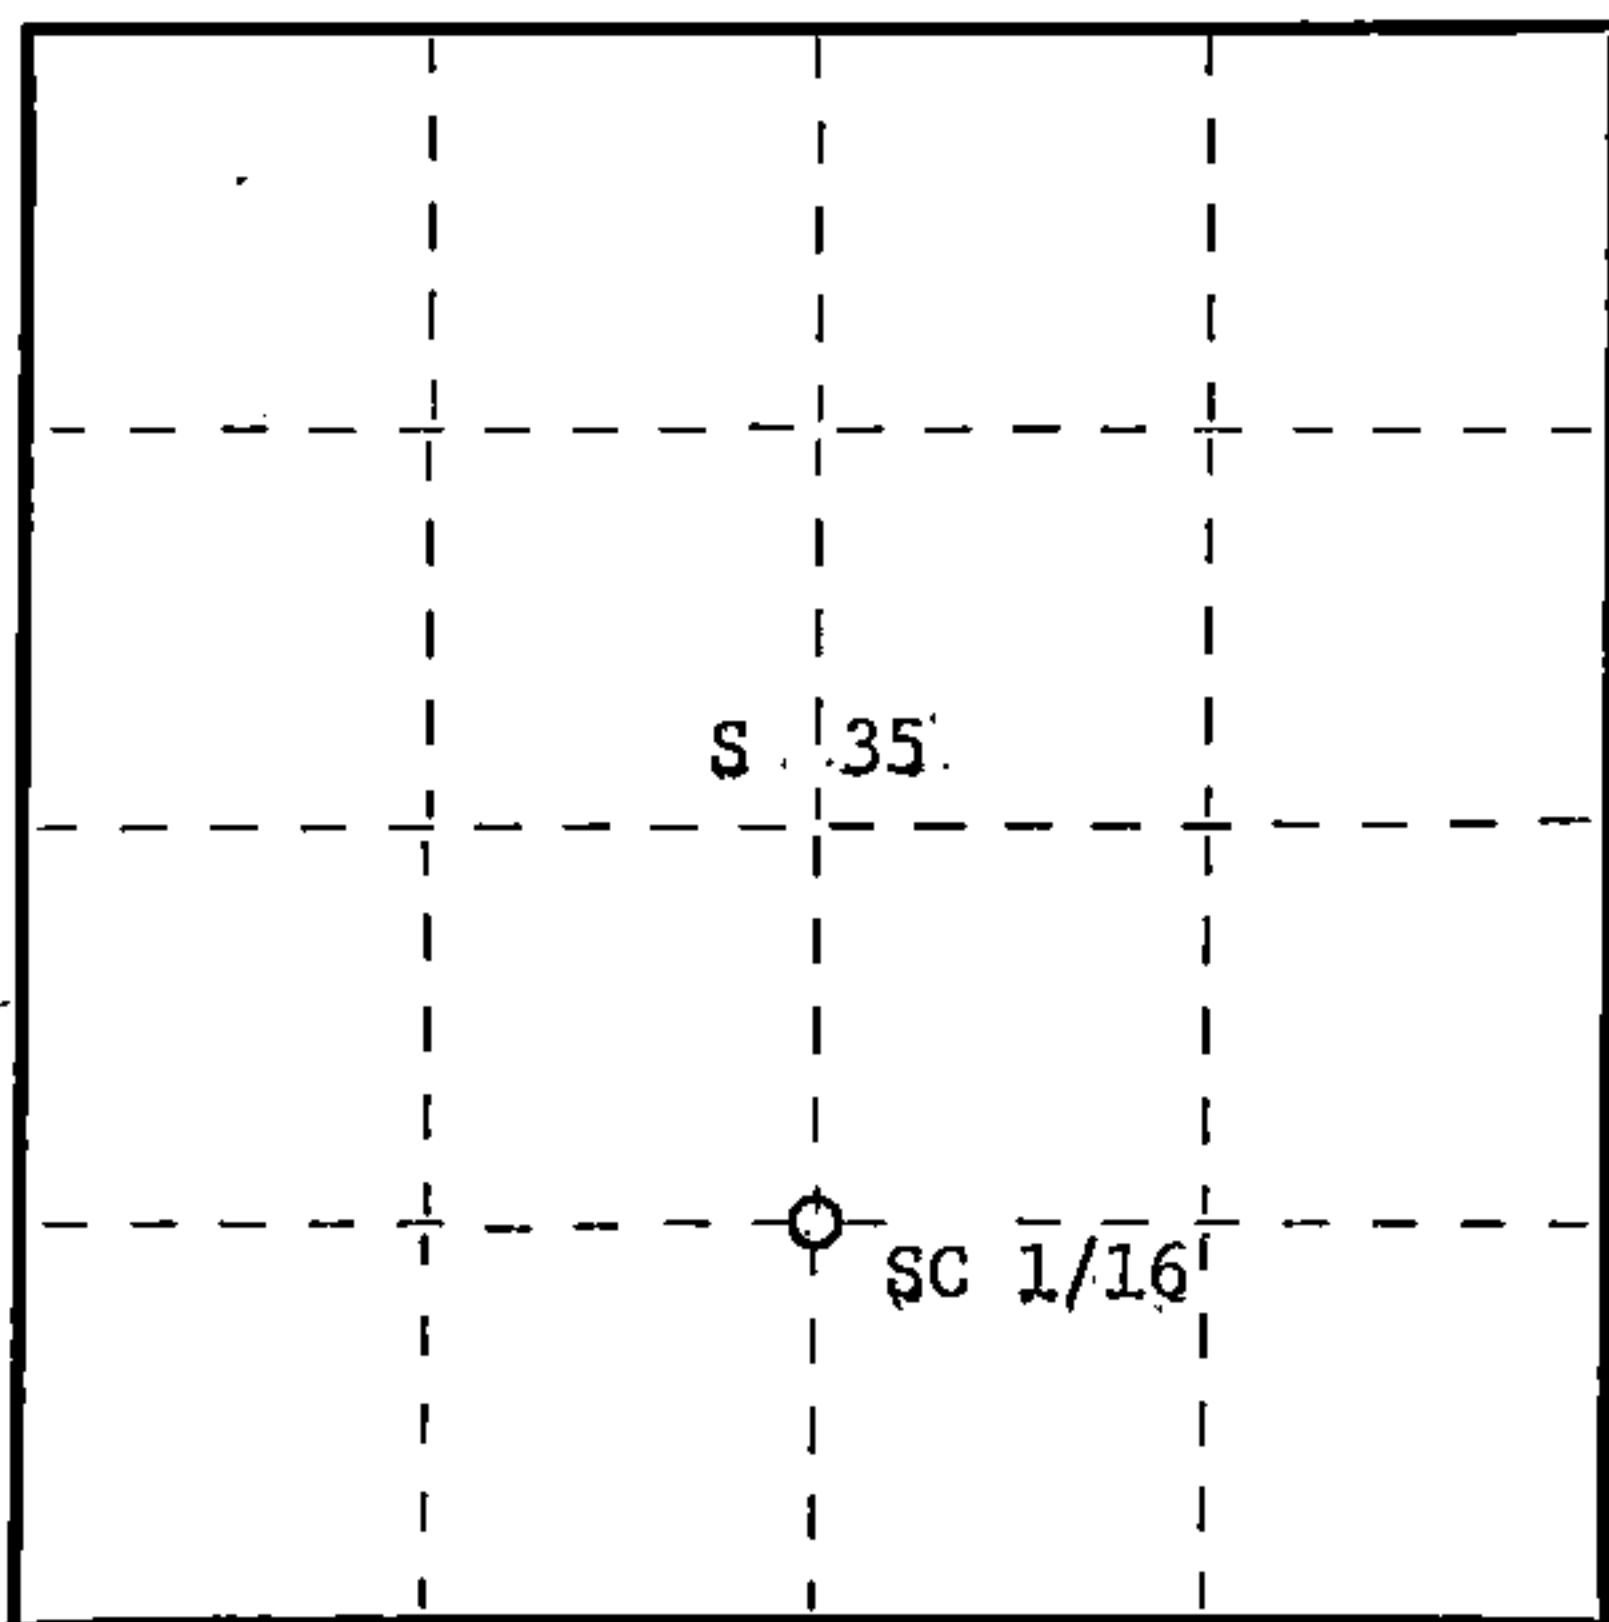

Dated at Rhineland, Wis., this 6th day of May, 19 83.

Signature Glen Barker Title Registered Land Surveyor Registration No. S1682
(County Surveyor, Registered Land Surveyor, or other duly authorized official)

Office of Register of Deeds, County of Forest, I hereby certify that the within
instrument was filed in this office for record on the 19th day of May, 19 83
at 3:00 o'clock P. M.

Eugene Staszny
(Register of Deeds)

By _____ Deputy

DOCUMENT NO.
123419

Stock No. 26272

FORM 985

43513351020