

CERTIFIED LAND CORNER RESTORATION

Index No. **V-18**

State of Wisconsin }  
County of Forest } ss.

History of original corner establishment:  
No evidence of any previous corner.

I Glen Barker, do hereby certify that on the 1st day of April, 19 83, I ~~found~~ found evidence of the SW 1/16 corner of Section 35 Township 35, North, Range 13 East, Fourth Principal Meridian, as described hereon; and that from this evidence I established a new monument and accessories as described hereon to perpetuate the original location of this corner.

Description of corner evidence found:  
Corner established by subdivision of the SW 1/4.  
Location of SW 1/16 is 1322.14 ft. of WC 1/16 and 1314.77 ft. of SC 1/16.

Resident witnesses:

J. Claflin

H. Wagoner



Description of monument and accessories I established to perpetuate the original location of this corner.

Set a 1" iron pipe with 2" diameter alloy cap stamped:

Monument projects 18" above ground.

Marked NBTs

Sugar 7" N71E 15.82 ft.

Sugar 7" S40W 18.03 ft.

Scribed 1/16 - B.T.


S1682

T35N R13E

SW 1/16 S-35

CPI - 1983

T35N

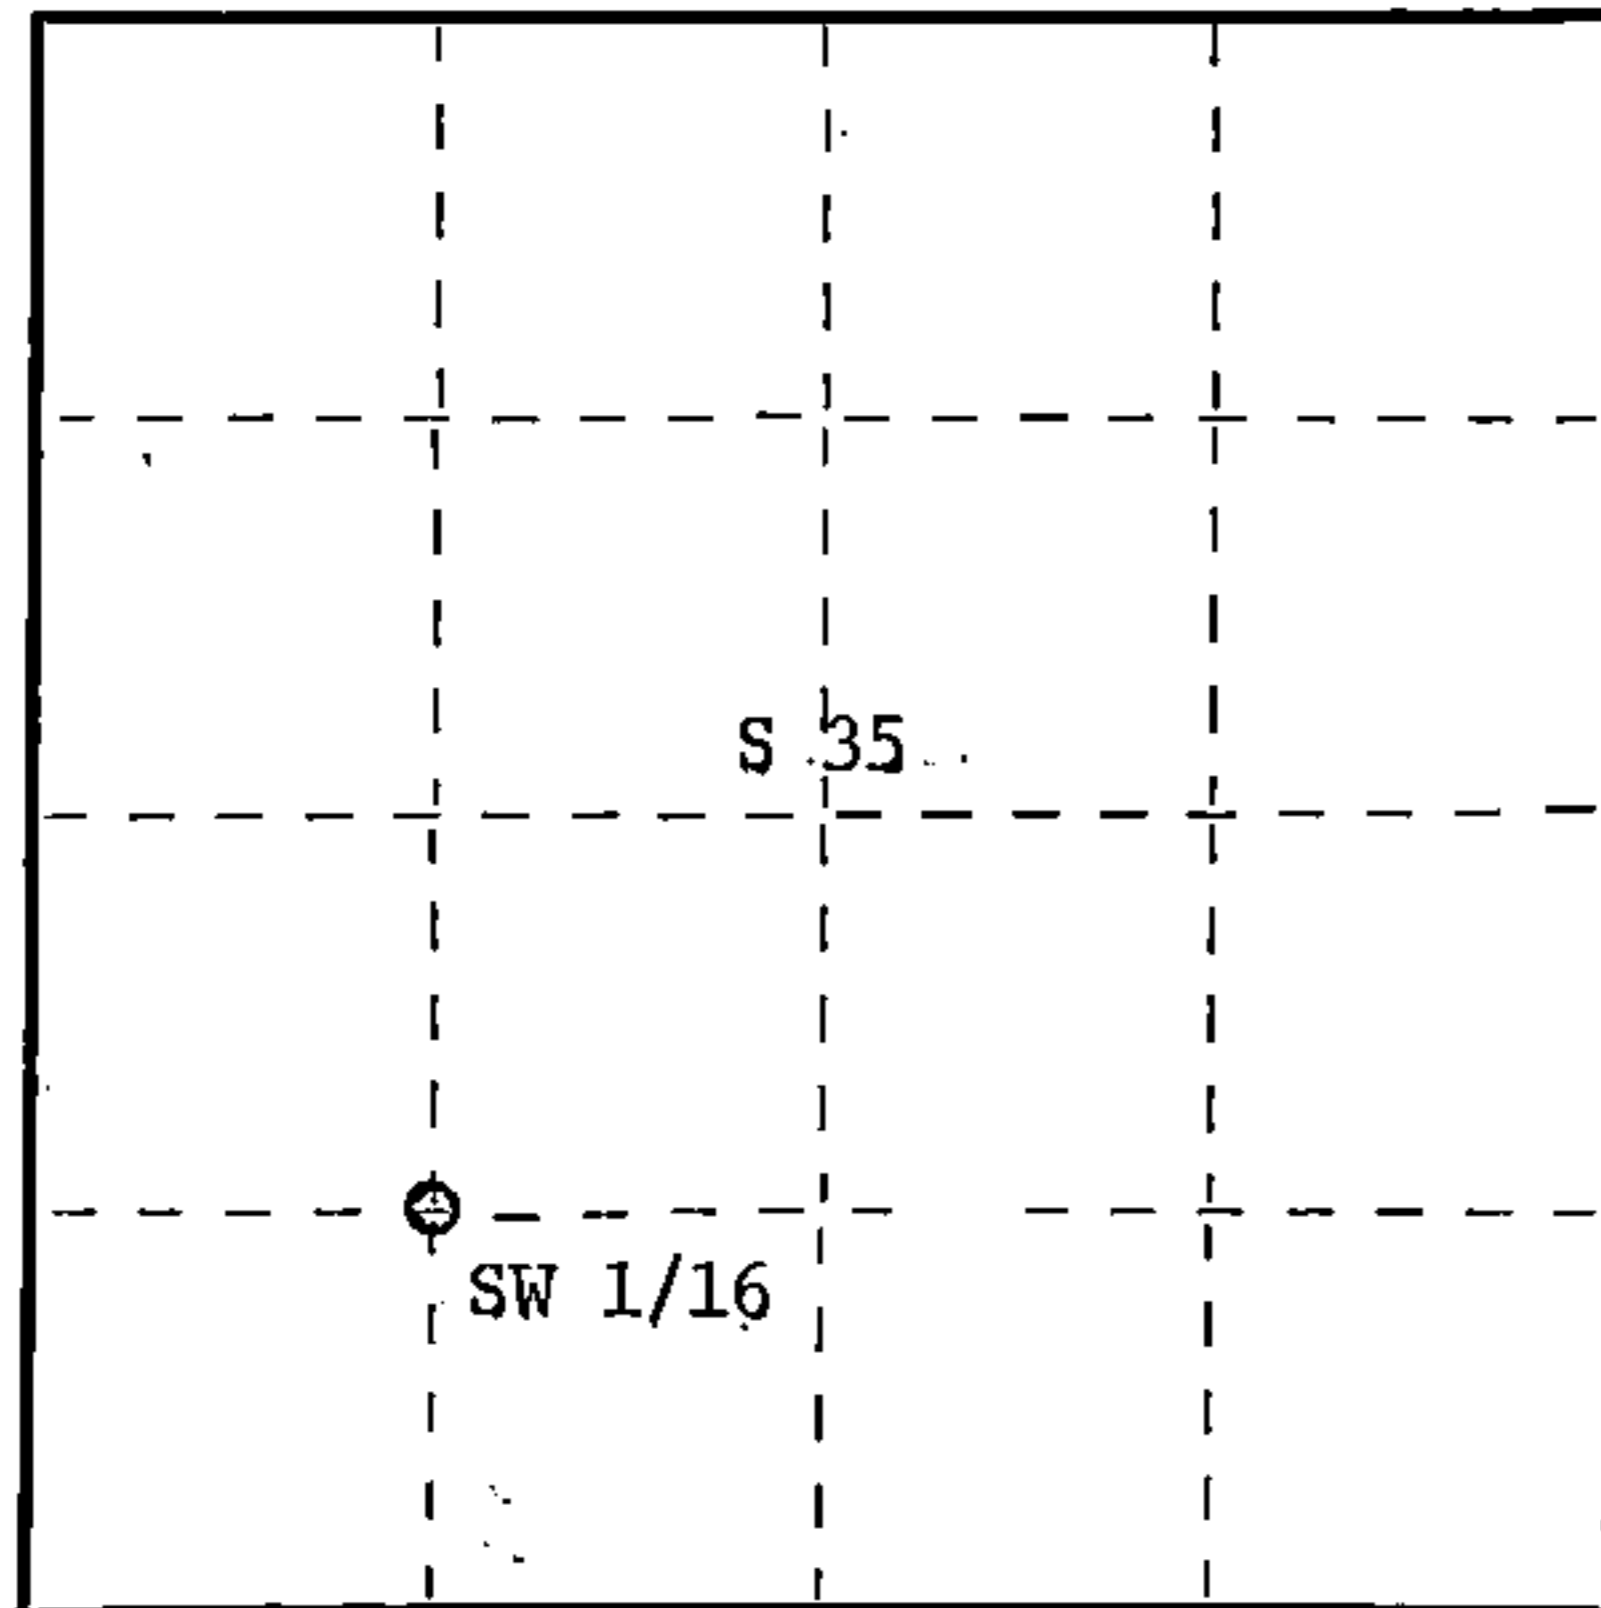

○ = Corner monument restored.

Dated at Rhineland, Wis., this 6th day of May, 19 83.

Signature Glen Barker Title Registered Land Surveyor Registration No. S1682  
(County Surveyor, Registered Land Surveyor, or other duly authorized official)

Office of Register of Deeds, County of Forest, I hereby certify that the within instrument was filed in this office for record on the 19th day of May, 19 83 at 3:00 o'clock P. M.

Eugene Stutzman  
(Register of Deeds)

By.....Deputy

DOCUMENT NO.  
**123418**

Stock No. 26272

McMillan County, WI

FORM 985

43513351030