

State of Wisconsin

County of FOREST

ss. RESTORATION OF LOST ORIGINAL GOVERNMENT SURVEY CORNER.

I NEAL SPERHAKE, do hereby certify that on the SEVENTH day of AUGUST, 19 64, I established the WEST QUARTER SECTION CORNER OF SECTION 36, TOWNSHIP 35 NORTH, RANGE 13 EAST, Fourth Principal Meridian, as described hereon.

History: This corner was established during the original survey of this township, as noted in the original field notes for the original survey of T35N-R13E, 4th. p.m.

Description of monument and accessories I established to perpetuate the location of this corner:


At the point determined for the location of the corner I emplaced a:

GALVANIZED IRON PIPE, THREE FEET LONG, ONE INCH IN DIAMETER, WITH ALUMINUM CAP DENOTED AS, "KIMBERLY CLARK CORP. T35N 1/4 BTWN. 35 & 36 R13E SPERHAKE RLS 463 8/7/64."

The pipe is witnessed by:

- Hemlock 8 N 70°E 33 links. (SCRIBED 1/4 S 36 NBT).
- Maple 7 S 66°W 33 links. (SCRIBED 1/4 S 35 NBT).

Description as to how corner was located: No evidence of the original corner is present. Thus, set by proportionate measurement. Both the section corners 1/2 mile north and south, respectively, have been previously determined with a distance between them of 79.62 chains. Thus, set the quarter corner 39.81 chains from either corner and on a straight line between them.

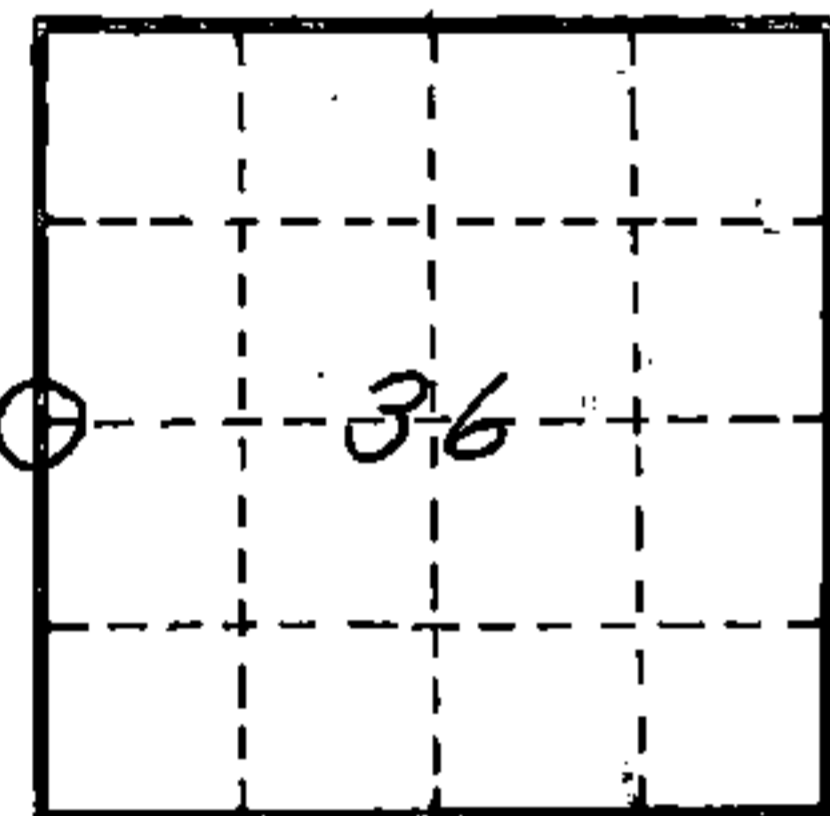

0 = Corner monument restored

89625
 RECORDS OFFICE
 FOREST COUNTY, WIS.
 JAN 12 1965
 At 10 o'clock 4 M
 Anna Peterson Register of Deeds

Resident witnesses _____

Dated at Crandon, Wisconsin, this 12th day of January, 1965.

Signature Neal Sperhake

Title Registered Land Surveyor Registration No. 463

~~Office of~~ Forest County ~~of~~ Wisconsin, I hereby certify that the within instrument was ~~filed in the~~ ~~office for record~~ on the ~~xx~~ 12th day of January 19 65, and was ~~filed in Book No.~~ signed and Page No. sworn to ~~of County Records.~~ before me.

Surveyor's Seal

Signature Anna Peterson Title Notary Public

43513352000

Index No. X21