

CERTIFIED LAND CORNER RESTORATION

Index No. **W-19**

State of Wisconsin }
County of Forest } ss.

History of original corner establishment:
No evidence of any previous corner.

I Glen Barker, do hereby certify that on the 25th day of March 19 83, I ~~found~~ evidence of the NC 1/16 corner of Section 35 Township 35, North, Range 13 East, Fourth Principal Meridian, as described hereon; and that from this evidence I established a new monument and accessories as described hereon to perpetuate the original location of this corner.


Description of corner evidence found:

Total distance from 1/4 corner between sections 26 & 35 to C 1/4 corner section 35 is 2638.48 ft.
Set NC 1/16 1319.24 ft. intermediate.

Resident witnesses:

J. Claflin

H. Wagoner

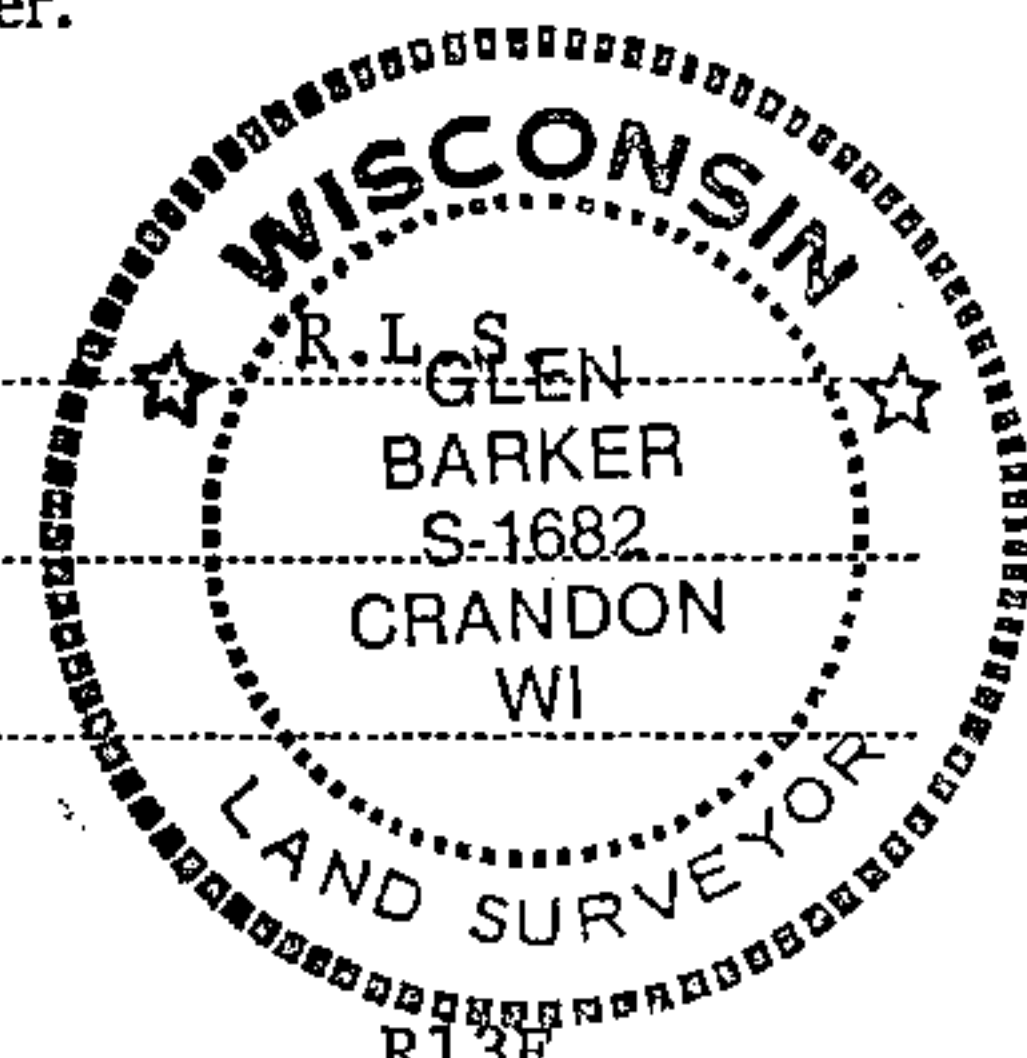


Description of monument and accessories I established to perpetuate the original location of this corner.

Set a 1" x 12" iron pipe in Spring Lake Road for NC 1/16 position.
Set a 1" iron pipe with 2" diameter alloy cap 32.18 ft. west of true corner for witness corner stamped:

Marked NBTs to true corner
Maple 5" N71E 26.33 ft.
Maple 6" N63W 53.05 ft.
Scribed 1/16 - B.T.

S1682
T35N R13E
S 35 W.C.
NC 1/16
E. 32.18 ft.
CPI - 1983

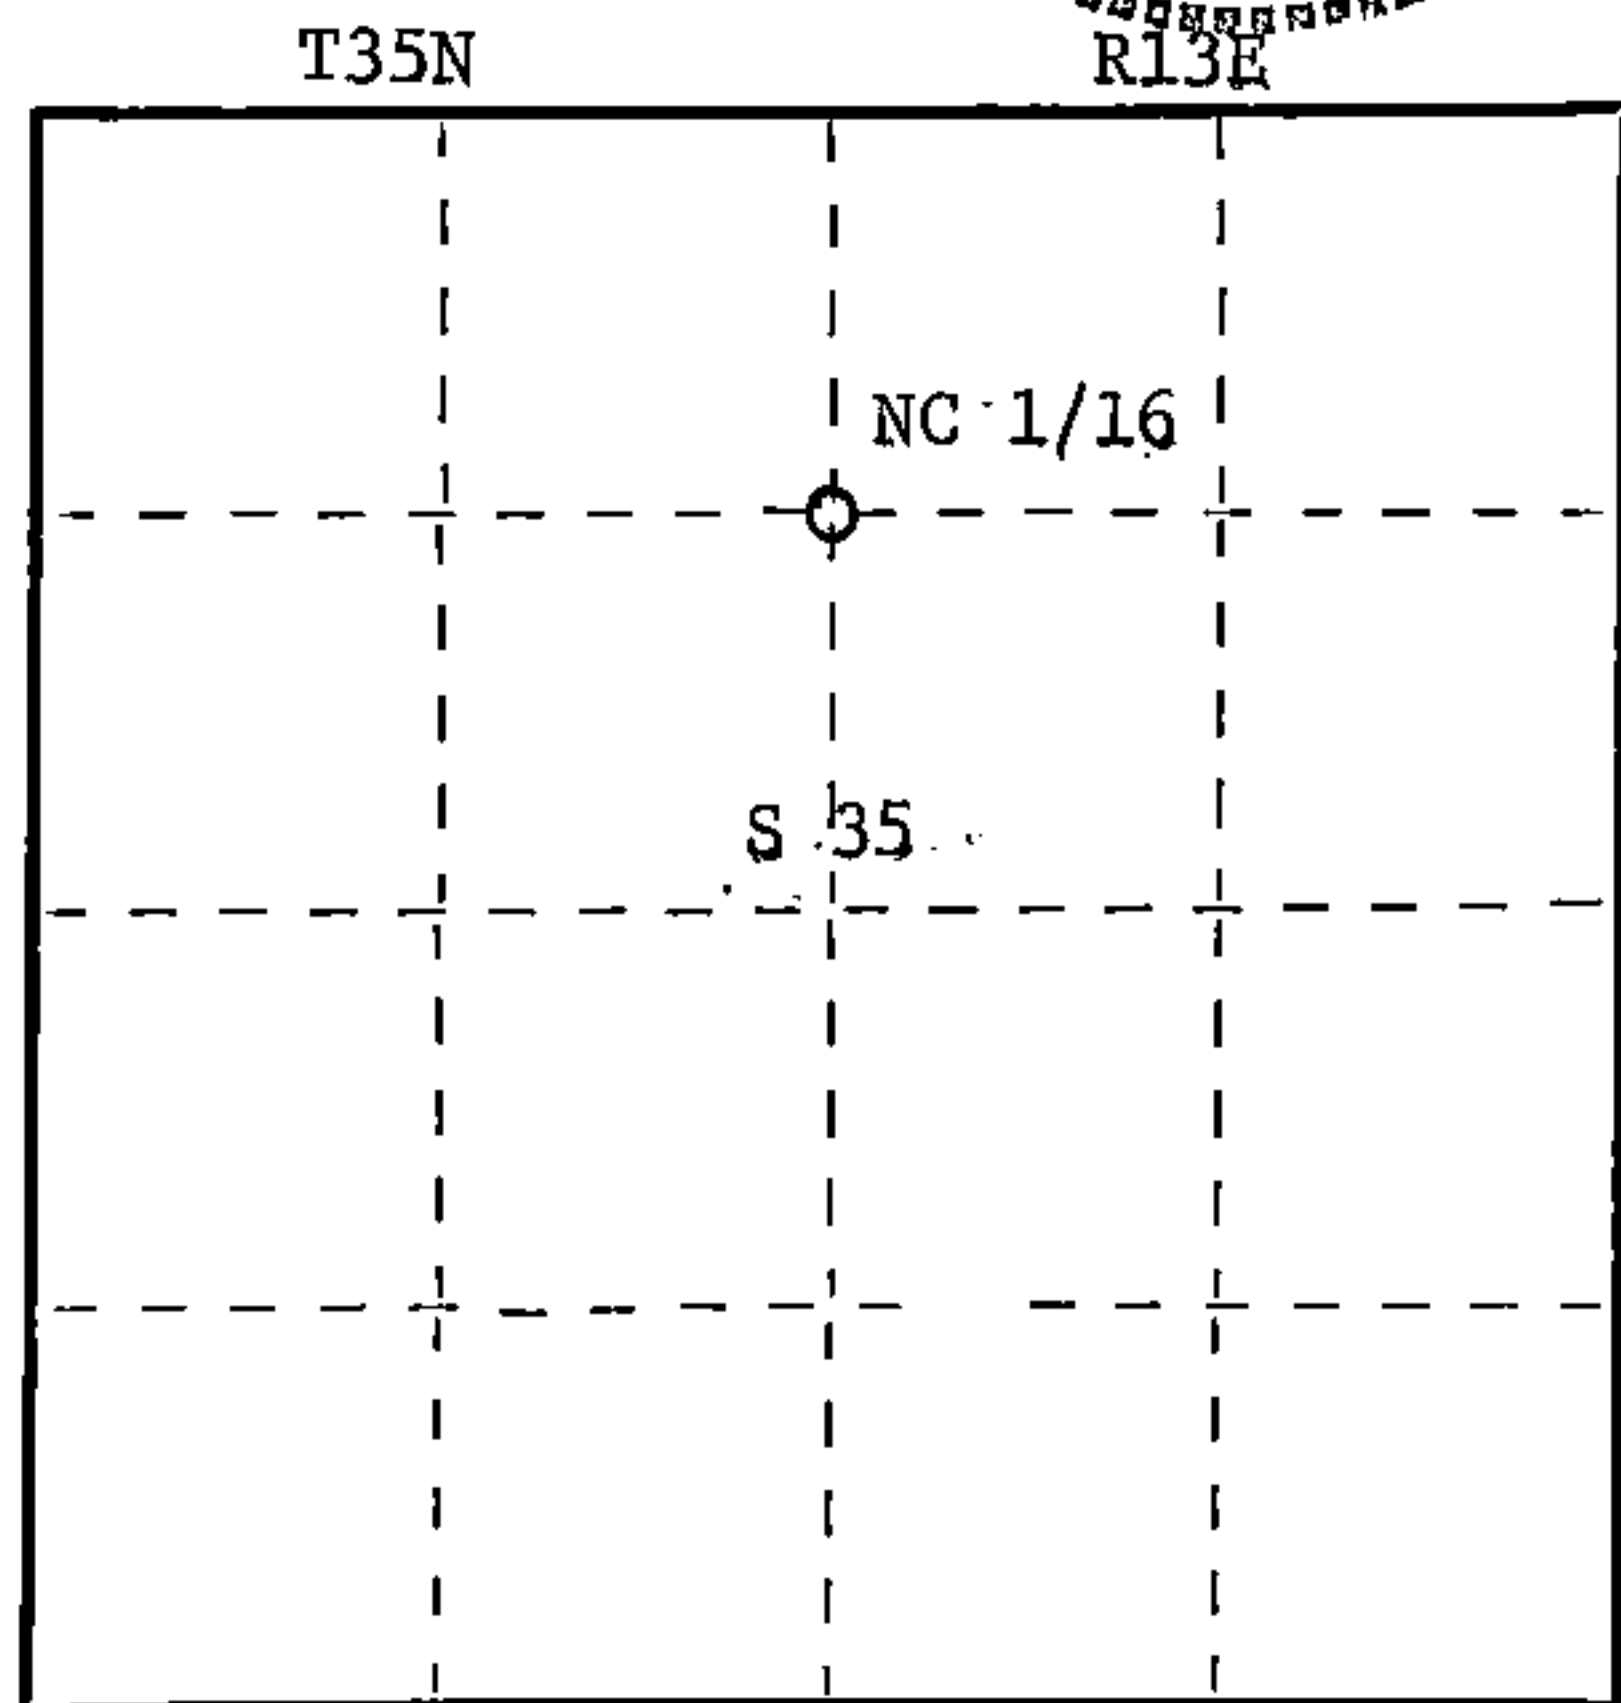

○ = Corner monument restored.

Dated at Rhineland, Wis., this 6th day of May, 19 83.

Signature Glen Barker Title Registered Land Surveyor Registration No. S1682
(County Surveyor, Registered Land Surveyor, or other duly authorized official)

Office of Register of Deeds, County of Forest, I hereby certify that the within instrument was filed in this office for record on the 19th day of May, 19 83 at 3:00 o'clock P. M.

Eugene Statynsky
(Register of Deeds)
By _____ Deputy

DOCUMENT NO. **123416**

Stock No. 26272
FORM 985
McMillan Company
MILWAUKEE, WISCONSIN

43513353020