

CERTIFIED LAND CORNER RESTORATION

State of Wisconsin }
County of Forest } ss.

I Jean F. Resvick, do hereby certify that on the 6th day of February, 1978, I found evidence of the Southwest Section corner of Section 31 Township 35 North, Range 14 East, Fourth Principal Meridian, as described hereon; and that from this evidence I established a new monument and accessories as described hereon to perpetuate the original location of this corner:

Description of original monument and accessories and subsequent restorations:

Surveyed in 1857 by Alfred Millard. Set post
Hemlock 10, N35E, 42 links
Hemlock 24, N53W, 17 links
Hemlock 18, S18W, 60 links
Hemlock 11, S72E, 45 links
Dependent resurvey in 1946 by Hugh B. Crawford
Set concrete monument, 24 inches long, 6 inches diameter, 14 inches in the ground and in mound on stone, with brass cap marked:
T35N, R13E, R14E, S36, S31, S1, S6, T34N, 1946



Birch 16, N51E, 35 links
Maple 5, S69°30'E, 20 links
Hemlock 5, S43W, 19 1/2 links
Birch 10, N52W, 82 links

Description of corner evidence found:

Monument as described
Birch 16, scribed, dead snag
Maple 13, scribed
Hemlock, scribed, dead and down
Birch, scribed, dead snag

Description of monument and accessories I established to perpetuate the location of this corner:

Blazed and scribed the following new bearing trees:
Maple 14, N27E, 8.42 feet
Maple 10, S6W, 13.29 feet
Hemlock 10, N73W, 41.52 feet
Set steel sign post 1.5 feet northeast of monument

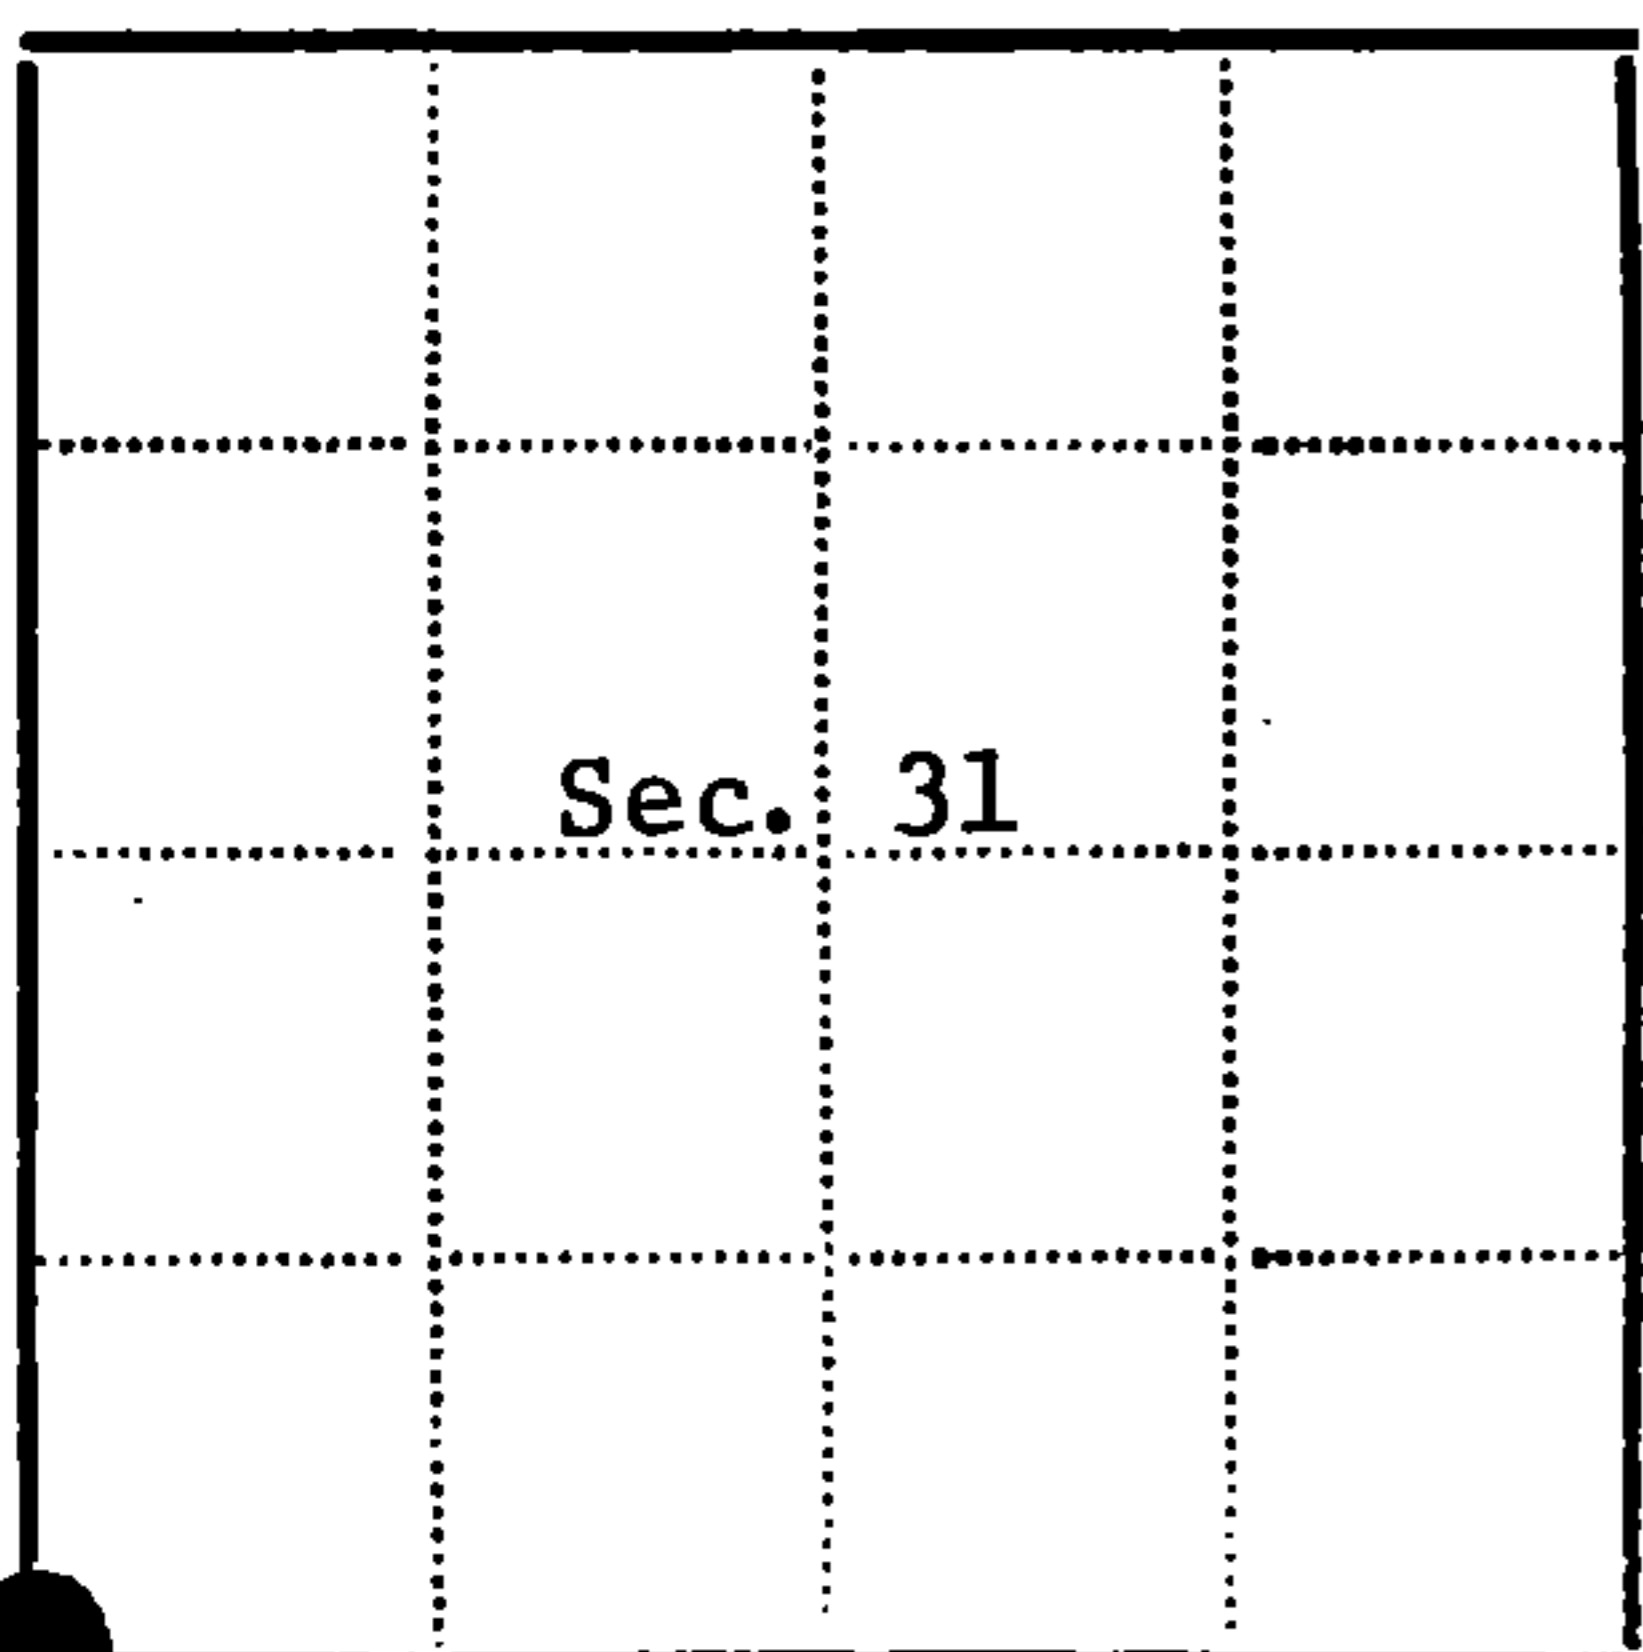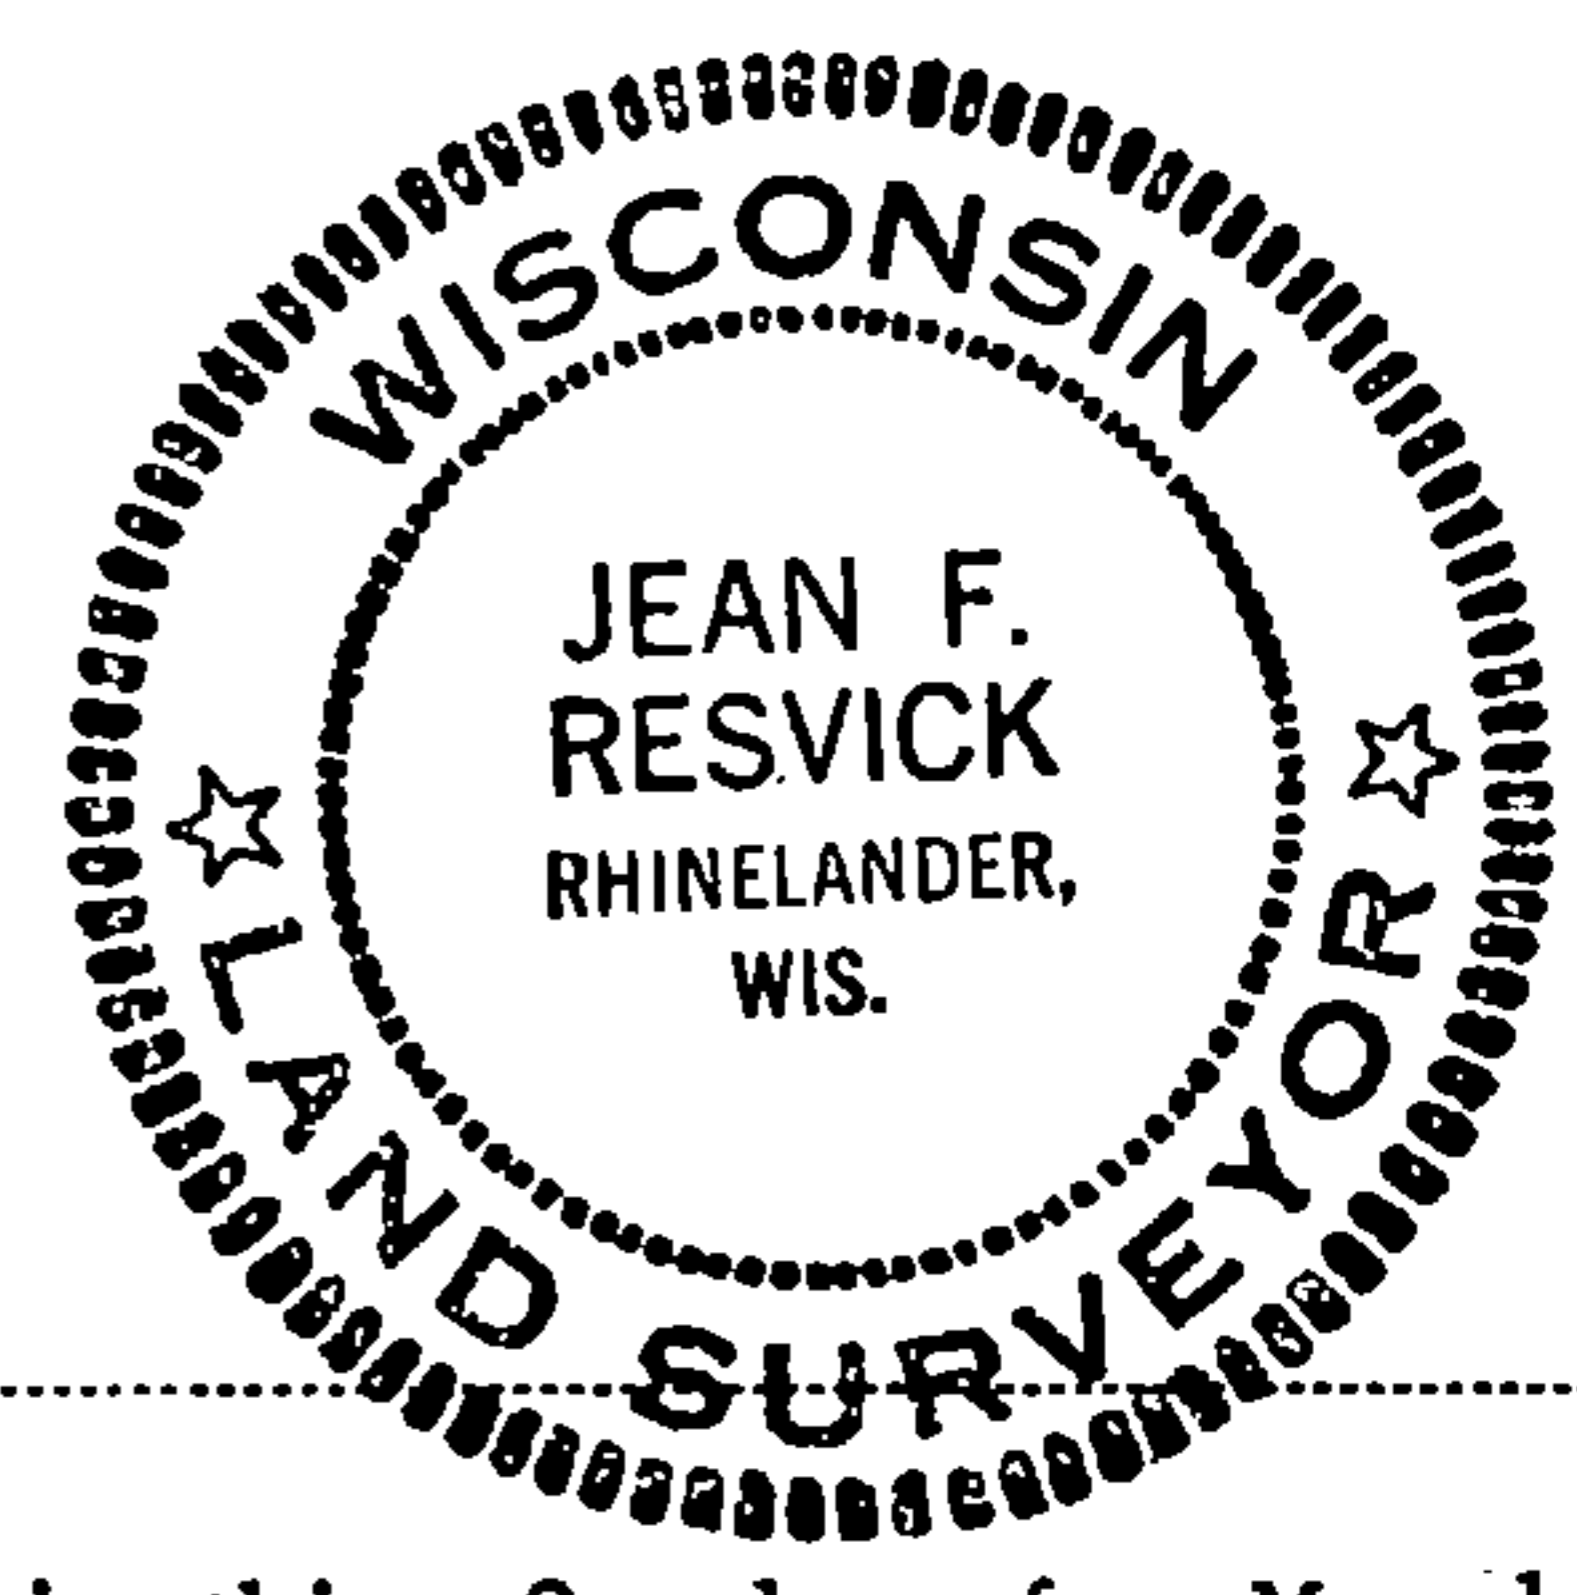

● - Corner monument restored
□ -

Resident witnesses.....

Dated at Rhinelander Wisconsin, this 2 day of March 1978...

Signature *Jean F. Resvick* Title Land Surveyor
(County Surveyor, Registered Land Surveyor, or other duly authorized official)

Surveyors Registration No. S-802 DOCUMENT NUMBER 113631

Office of Register of Deeds County of Forest

I hereby certify that the within instrument was filed in this office for record on the 20th day of April 1978, and was filed in Book No. Page No. of County Records.

Signature *Eugene Stately* Title Register of Deeds

Township 35 North, Range 14 East, Section 31, Index No. Z-1, Page No.

21