


State of Wisconsin }
County of FOREST } ss.

I NEAL SPERHAKE, do hereby
certify that on the ELEVENTH day
of DECEMBER, 1962, I found
evidence of the SOUTH QUARTER SECTION
corner of SECTION 36
Township 35, North, Range
13 EAST, Fourth Principal Meridian,
as described hereon; and that from this evidence
I established a new monument and accessories
as described hereon to perpetuate the original
location of this corner.

Resident witnesses:

Richard Piontek - Waubeno.

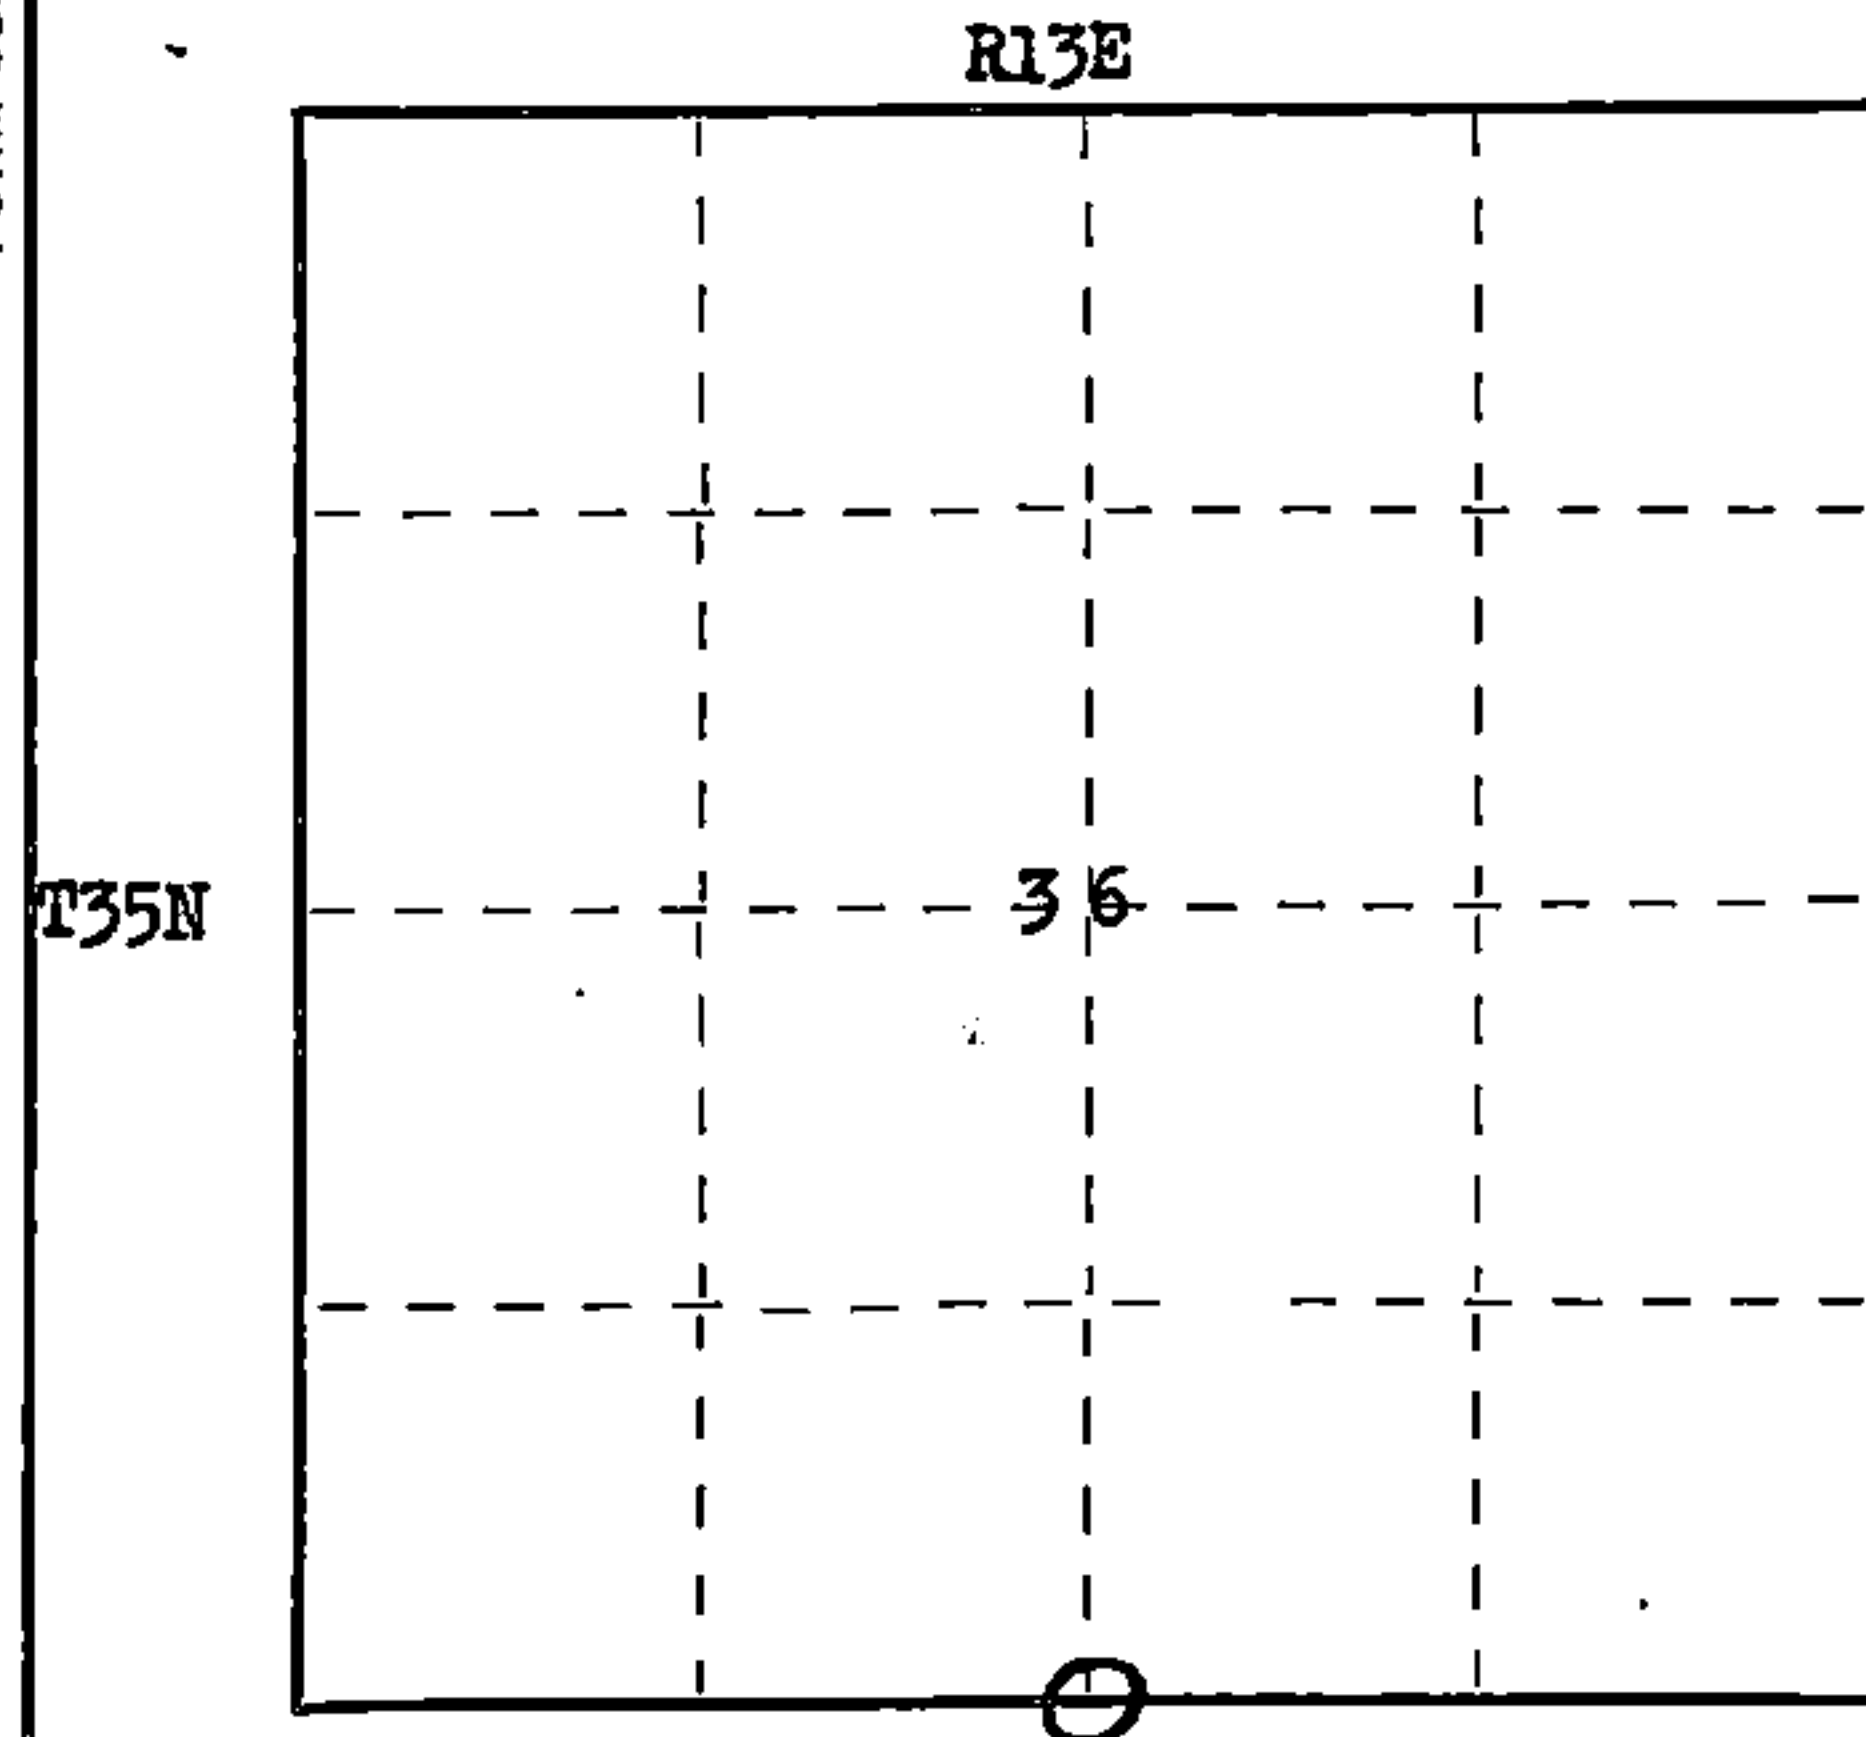

○ = Corner monument restored.

CERTIFIED LAND CORNER RESTORATION

Index No.

131
223

History of original corner establishment:

This corner can also be described as: THE QUARTER SECTION CORNER BETWEEN SECTIONS 1,
T34N-R13E, AND, 36, T35N-R13E, 4TH P.M.

This corner was established during the original survey of this township, as noted in
the original field notes for the original survey of T35N-R13E, 4th p.m.

Description of corner evidence found:

The original bearing tree, described in the original field notes as,

"Y. BIRCH 13 S43W 9 links"

is still present at this date, with a portion of the original scribe marks still visible.

Description of monument and accessories I established to perpetuate the original location of this corner.

At the site of the original post, as determined from the existing original bearing
tree noted above, I emplaced a "GALVANIZED IRON PIPE, THREE FEET LONG, ONE INCH IN
DIAMETER, WITH AN ALUMINUM CAP DENOTED AS, 'KIMBERLY-CLARK CORP T34-35N
1/4 BTWN 1 & 36 R13E SPERHAKE RLS 463 12-11-62".

The pipe is witnessed by:

Maple 4 N44°E 44 links. (Scribed S36 NBT).
W. Birch 5 S14°E 29½ links. (Scribed S 1 NBT).

Dated at Crandon, Wis., this 11th day of April, 1963.

Signature [Signature] Title Registered Land Surveyor Registration No. S-463
(County Surveyor, Registered Land Surveyor, or other duly authorized official)

~~Office of Registered Deeds~~, County of Forest, I hereby certify that the within
instrument was ~~filed~~ signed and sworn to on the 11th day of April, 1963.
~~at~~ Crandon ~~MI.~~

Adeline DeNoble
Notary Public ~~(Registered Deed)~~ Forest County, Wisconsin

My commission expires February 6, 1966 My Commission Expires ~~February 6, 1966~~

Surveyor's Seal 4351336 0020