

STATE OF WISCONSIN

County of FOREST

I NEAL SPERHAKE, do hereby certify that on the TWELFTH day of DECEMBER, 1962, I established the WEST ONE SIXTEENTH CORNER BETWEEN SECTIONS 1, TOWNSHIP 34 NORTH, RANGE 13 EAST, AND, 36, TOWNSHIP 35 NORTH, RANGE 13 EAST, Fourth Principal Meridian, as described hereon.

Resident Witnesses:

Richard Piontek - Waubeno.

This corner can also be described as either the "WEST 1/8 TH, OR, THE WEST QUARTER - QUARTER SECTION CORNER BETWEEN SECTIONS 1, T34N-R13E, AND, 36, T35N-R13E, 4TH P.M.

History:

There is no record of this corner having ever been previously established.

Description of monument and accessories I established to perpetuate the location of this corner:

At the point determined for the location of the corner I emplaced as:


"GALVANIZED IRON PIPE, THREE FEET LONG, ONE INCH IN DIAMETER, WITH AN ALUMINUM CAP DENOTED AS, 'KIMBERLY-CLARK CORP T34-35N W1/16 BTWN 1 & 36 R13E SPERHAKE RLS 463 12-12-62".

The pipe is witnessed by:-

- Maple 5 N55°E 26 links. (Scribed S36 BT).
- Maple 3 S19°E 25½ links. (Scribed S 1 BT).


Description as to how corner was located:

Since both the quarter section corner one quarter mile east, and the section corner one quarter mile west have been previously established, with a distance between them of 40.01 chains, the 1/16th corner was set 20.00½ chains from either corner, on a straight line between them.

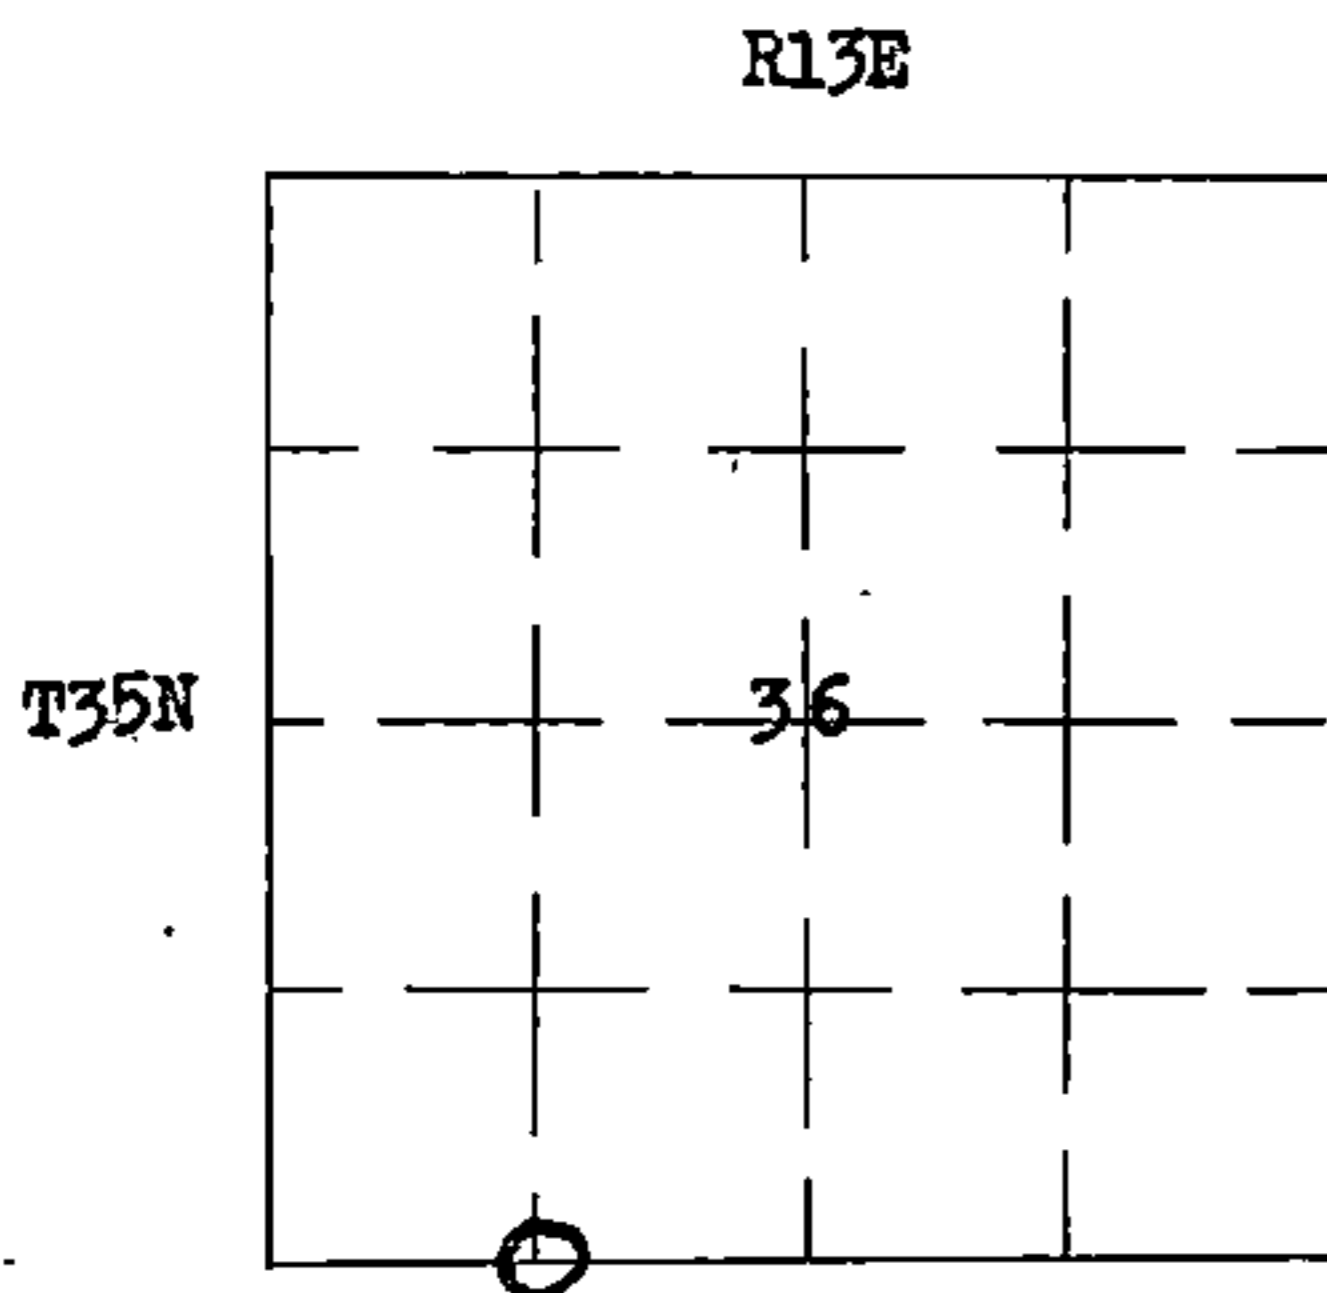

0 = Corner monument established

REGISTER'S OFFICE
FOREST COUNTY, WIS.

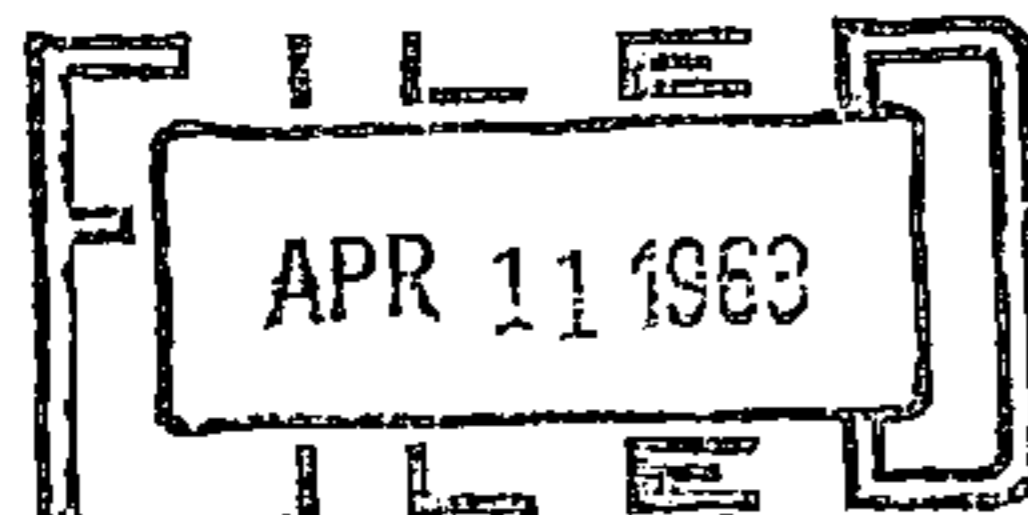

At 2 o'clock P.M.
Carl A. Unges Register of Deeds
Dep.

Dated at Crandon, Wis., this 11th day of April, 1963

Signature Neal Sperhake Title Registered Land Surveyor Registration No. S-463

~~Office of Register of Deeds~~ County of Forest I hereby certify that the within

instrument was ~~filed in this office for record~~ signed and sworn to on the 11th day of April, 1963

at o'clock M

Adeline De Noble
Notary (Register of Deeds) Public
Forest County, Wisconsin
~~My~~ My commission expires Empty

My Commission Expires
February 6, 1966

Surveyor's Seal

43513360030