


U. S. PUBLIC LAND SURVEY MONUMENT RECORD

INSTRUCTIONS: This record shall show the location of the corner and shall include all of the following nine elements (a through i).

(a) Identify the corner by reference to the U.S. public land survey system.

○ = Corner monument restored.

Section corner to Sections 2-3-10-11, T35N, R14E, Forest County, Wisconsin

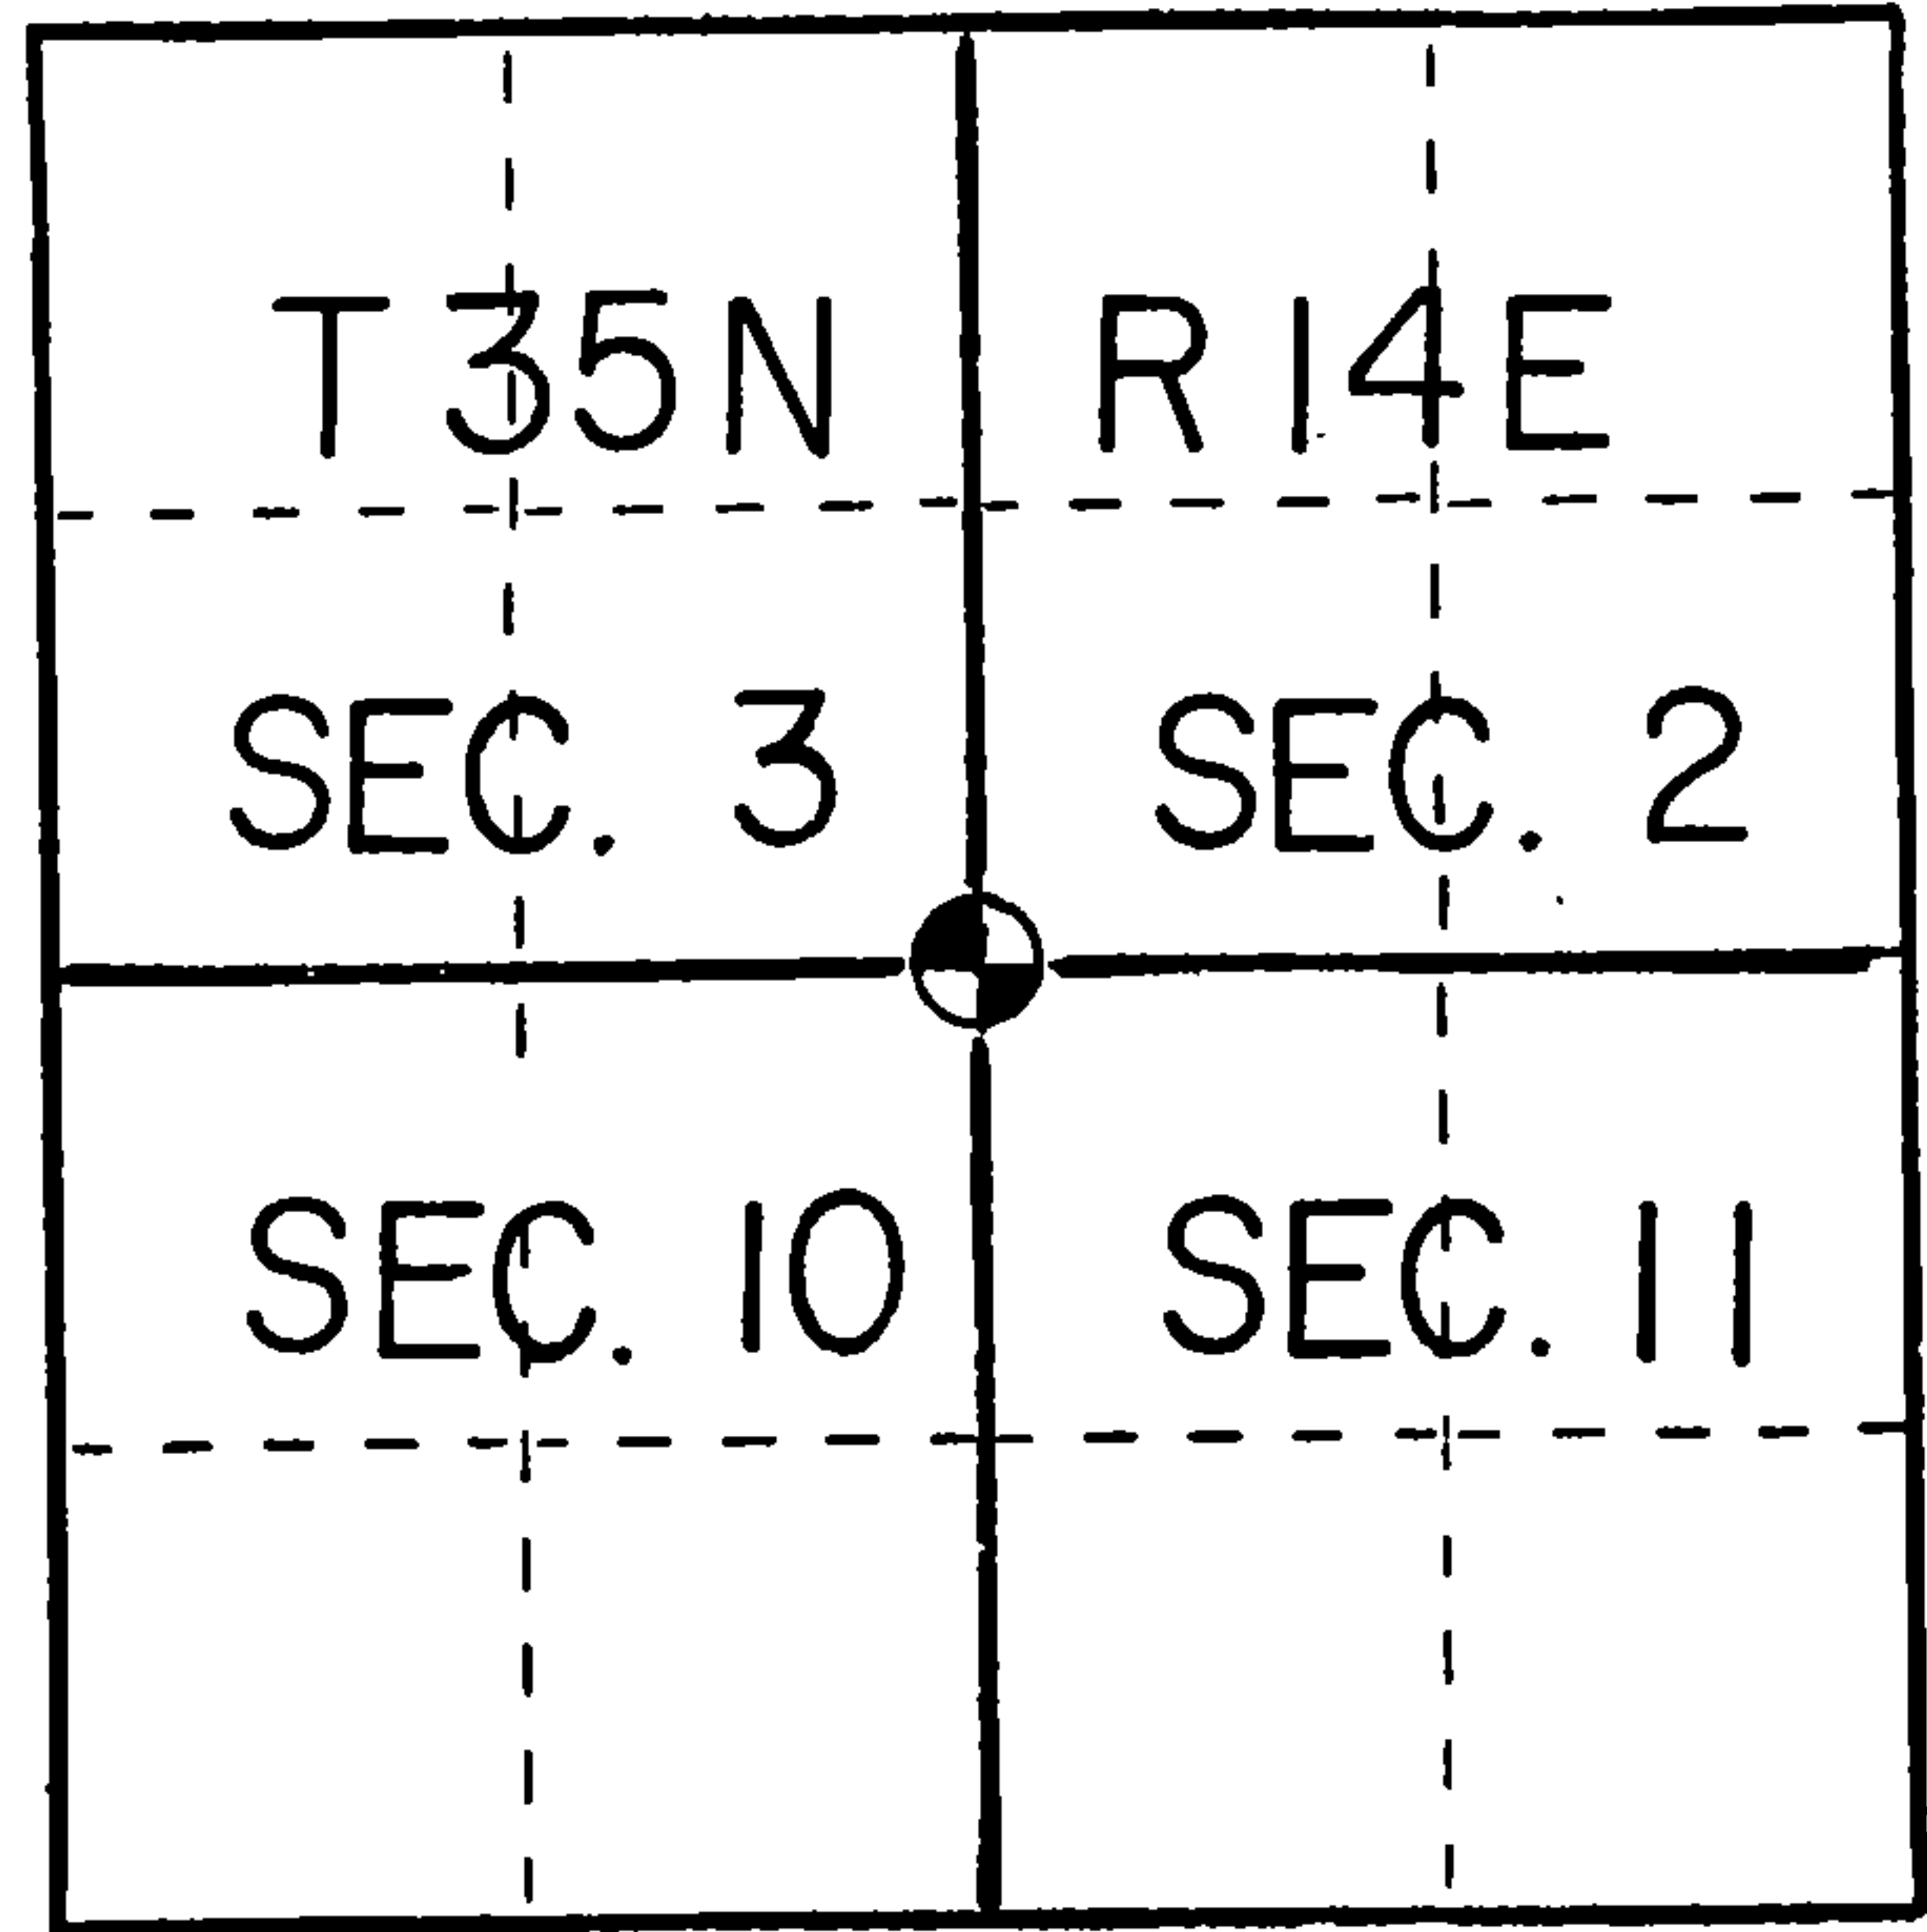

(b) Describe any record evidence, monument evidence, occupational evidence, testimonial evidence or any other material evidence you considered, and whether the monument was found or placed.


In 1859 J McBride set a wood post with:

- Sugar 18" N07W 34 links
- Hemlock 10" N13E 33 links
- Birch 16" S51E 50 links
- Lind 12" S27W 13 links

Found a three way fence intersection used by area landowners as the corner. Computed double proportionate position which fell northeast of this intersection by 100 feet. No bearing tree evidence located. A swamp call would also have had to been made for this double proportioned position. I accepted the fence intersection.

(c) In the plan view drawing below, provide reference ties to at least 4 witness monuments, or, if the location is within a municipality, to at least 2 witness monuments. (Witness monuments shall be made of concrete, natural stone, iron or other equally durable material.) Describe witness monuments.

(d) Show a plan view drawing depicting the relevant monuments and reference ties which is sufficient in detail to enable accurate relocation of the corner monument if the corner monument is disturbed. Indicate north.

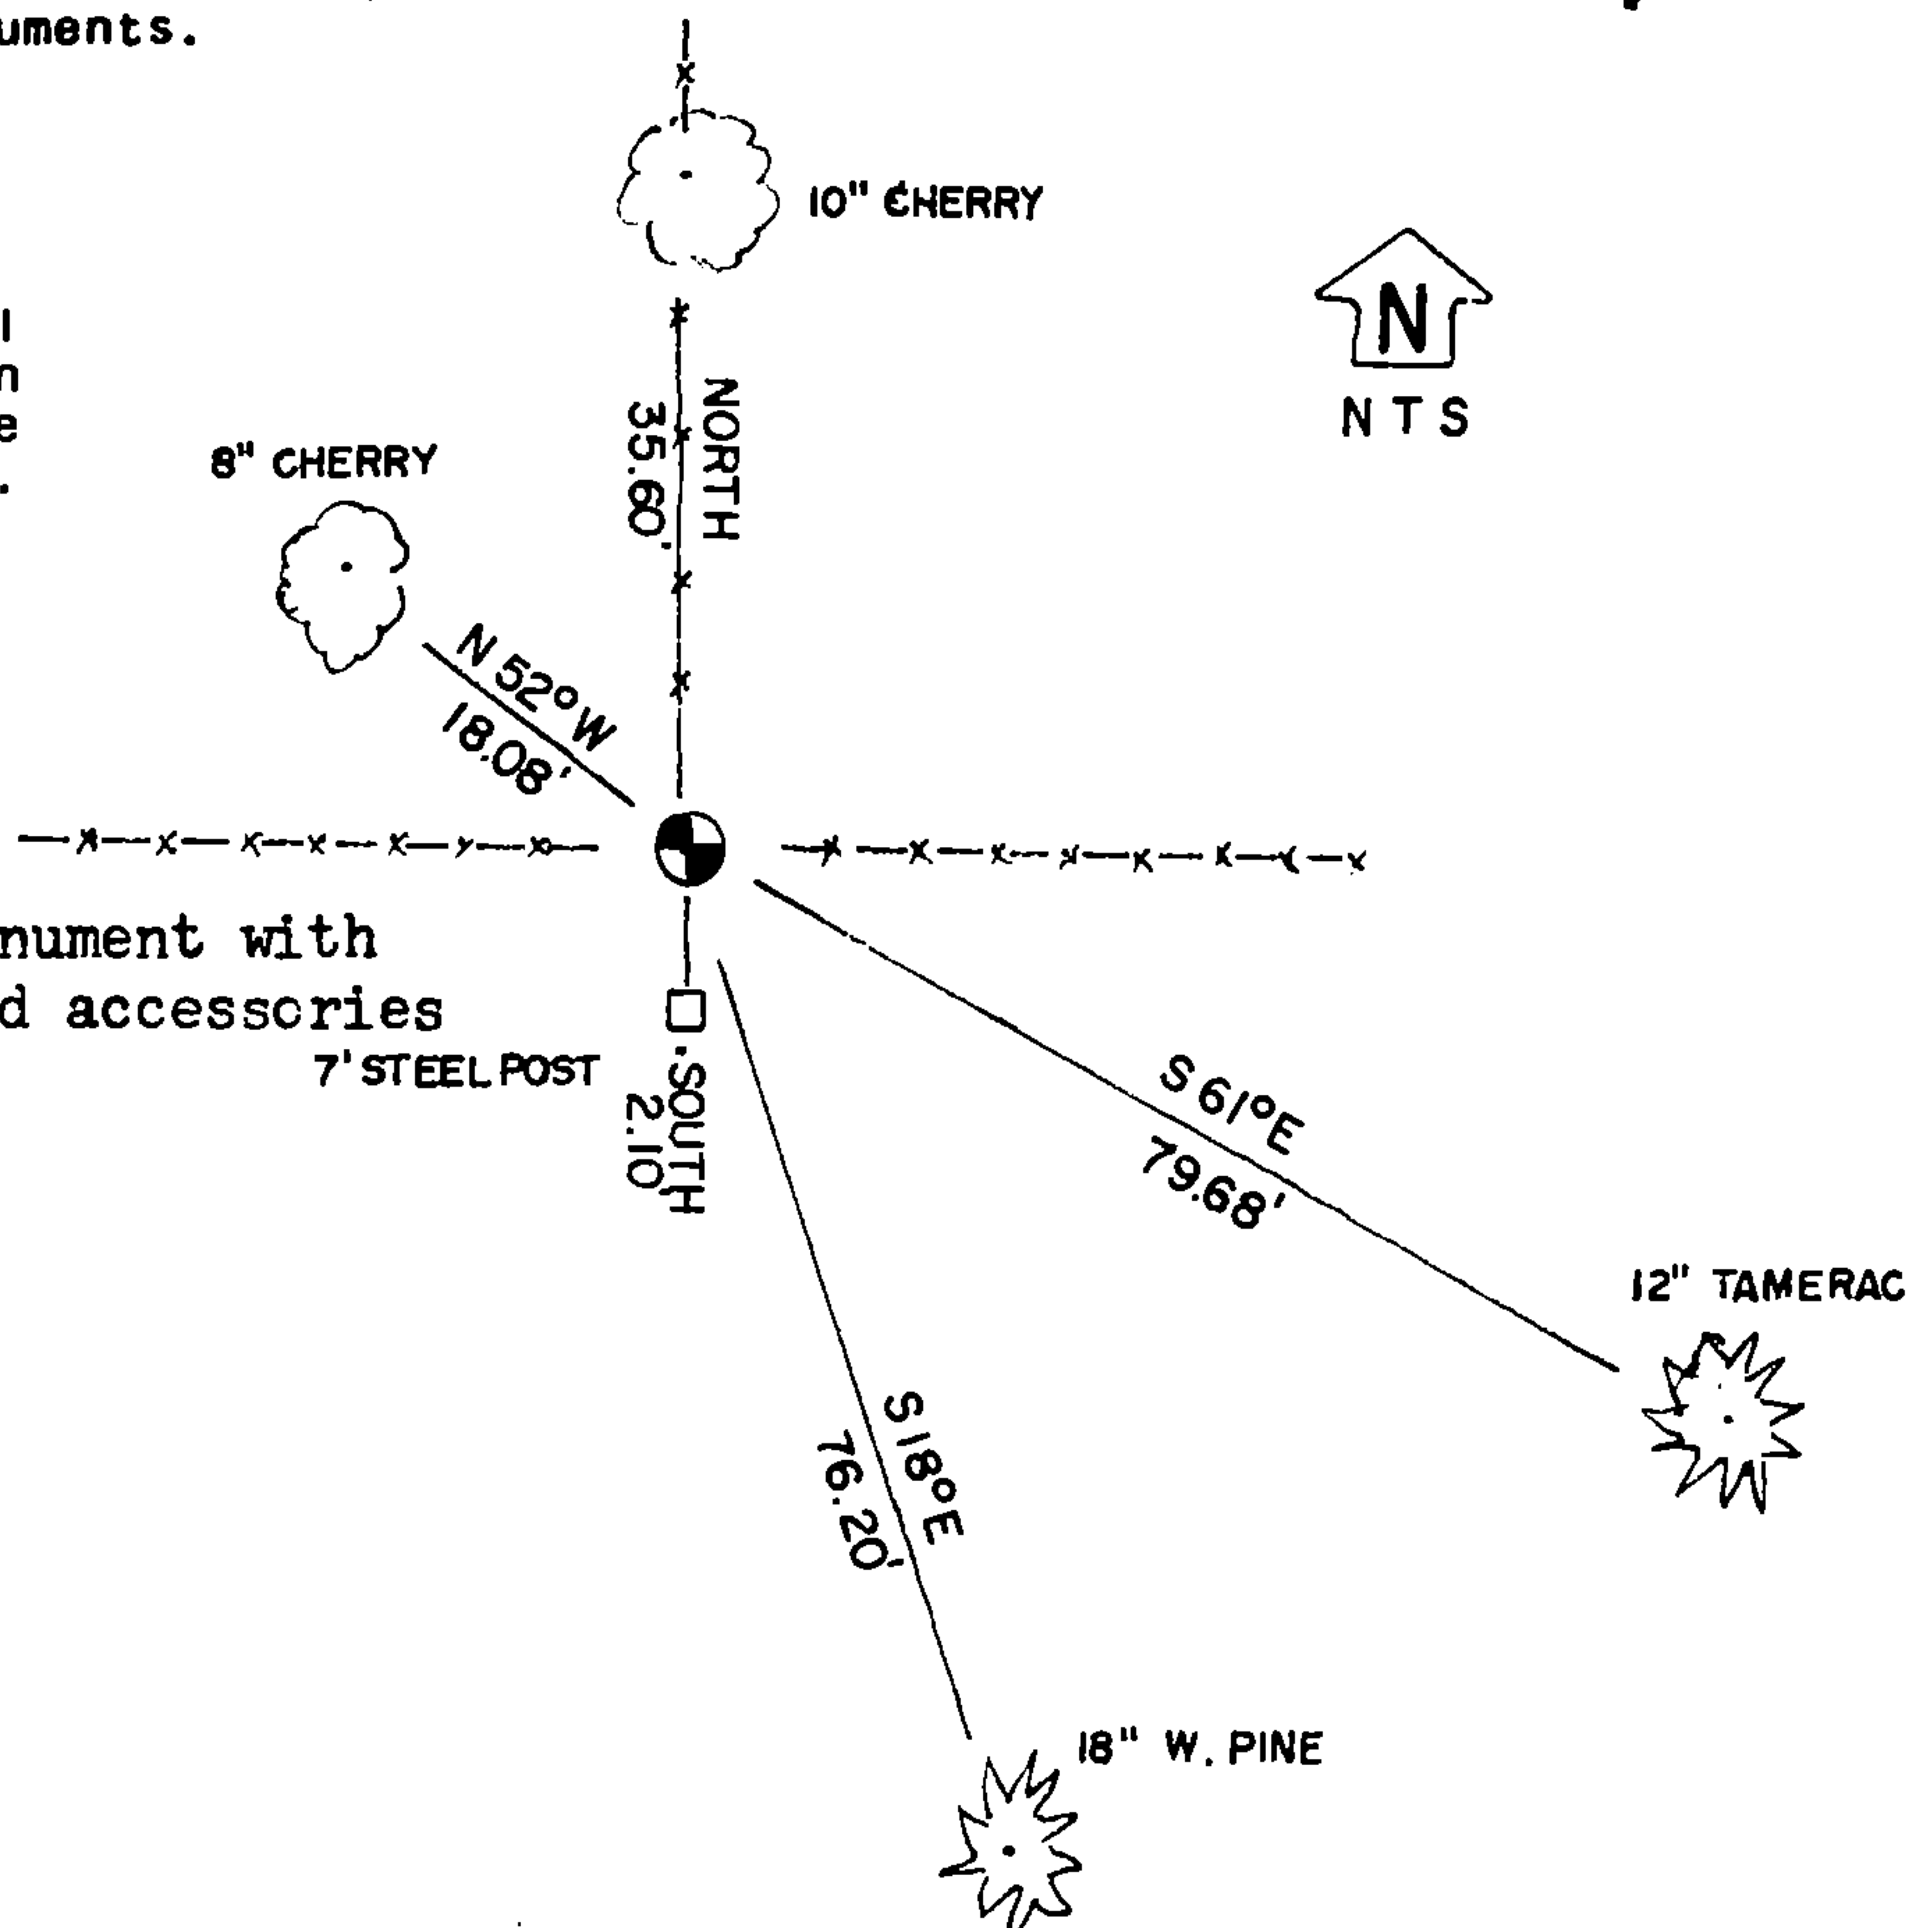

Set a 2"x 30" Aluminum monument with cap stamped for corner and accessories set to USFS standard.  
7' STEEL POST

REGISTER'S OFFICE  
Forest County, Wis.  
Received for record this 7th day  
of August A.D., 1985 at  
3:00 o'clock P.M. and recorded  
in Vol. CORNER RESTORATIONS  
page E-17  
Paul Aschubrenner  
Register of Deeds

INDEX NO.

E-17

(e) Describe any material discrepancy between the location of the corner as restored or reestablished and the location of that corner as previously restored or reestablished by distance and direction. Show the discrepancy on the plan view drawing under (d), above. Show the distances between the corner as previously restored or reestablished and (1) the corner as restored or reestablished, and (2) to at least 2 of the witness monuments shown on the drawing in (d), above.

No discrepancy

(f) Was the corner restored through acceptance of (1) an obliterated evidence location, or, (2) a found perpetuated location?

Found perpetuated location

(g&h) Was the corner reestablished through lost corner proportionate methods? If so, show the method, including the directions and distances to other public land survey corners used as evidence or used for proportioning in determining the corner location?

No

NO

NO

NO

Kim H Pritzlaff

(i) I, Kim H Pritzlaff (type or print name) certify that the corner location shown on this record was determined by me or under my direction and control and that this U.S. Public Land Survey Monument Record is correct and complete to the best of my knowledge and belief.

Signature

Date

*Kim Pritzlaff*

3-27-85

