

CERTIFIED LAND CORNER RESTORATION

State of Wisconsin }
County of Forest } ss.

I Milo E. Stefan, do hereby certify that on the 18th day of November, 19 81, I found evidence of the Northwest corner of Section 23 Township 35 North Range 14 East, Fourth Principal Meridian, as described hereon; and that from this evidence I established a new monument and accessories as described hereon to perpetuate the original location of this corner:

Description of original monument and accessories and subsequent restorations:

Surveyed in 1859 by James McBride
80.00 chains north, set wood post
Tamarack, 8", N12W, 10, 6.6 feet
Sugar, 16", N84E, 62, 40.92 feet
Birch, 15", S56E, 56, 36.96 feet
Lind, 10", S22W, 45, 29.70 feet

Surveyed June 18, 1975, by Forrest Johnson and Jean Resvick. They found 2" iron pipe in mound of rock, F.S. location on poster, N55E, 13 lks.

Description of corner evidence found:

Found 2" iron pipe in mound of rock.

Description of monument and accessories I established to perpetuate the location of this corner:

Placed a 2" x 36" aluminum monument with tablet stamped as follows:

T35N, R14E, S15, S14, S22, S23, 1981, RLS-1558

From which the following bear:

Rock, 4' x 4' x 18", N1E, 60.31 feet

Aspen, 10", N84E, 84.97 feet

Aspen, 6", S30E, 99.66 feet


Rock 3' x 3' x 12", S55W, 40.89 feet

Set steel sign post, north, 2.3 feet

Mound of stone around monument, 4" "x" chisled on top of rocks.

DOCUMENT NO.

124231

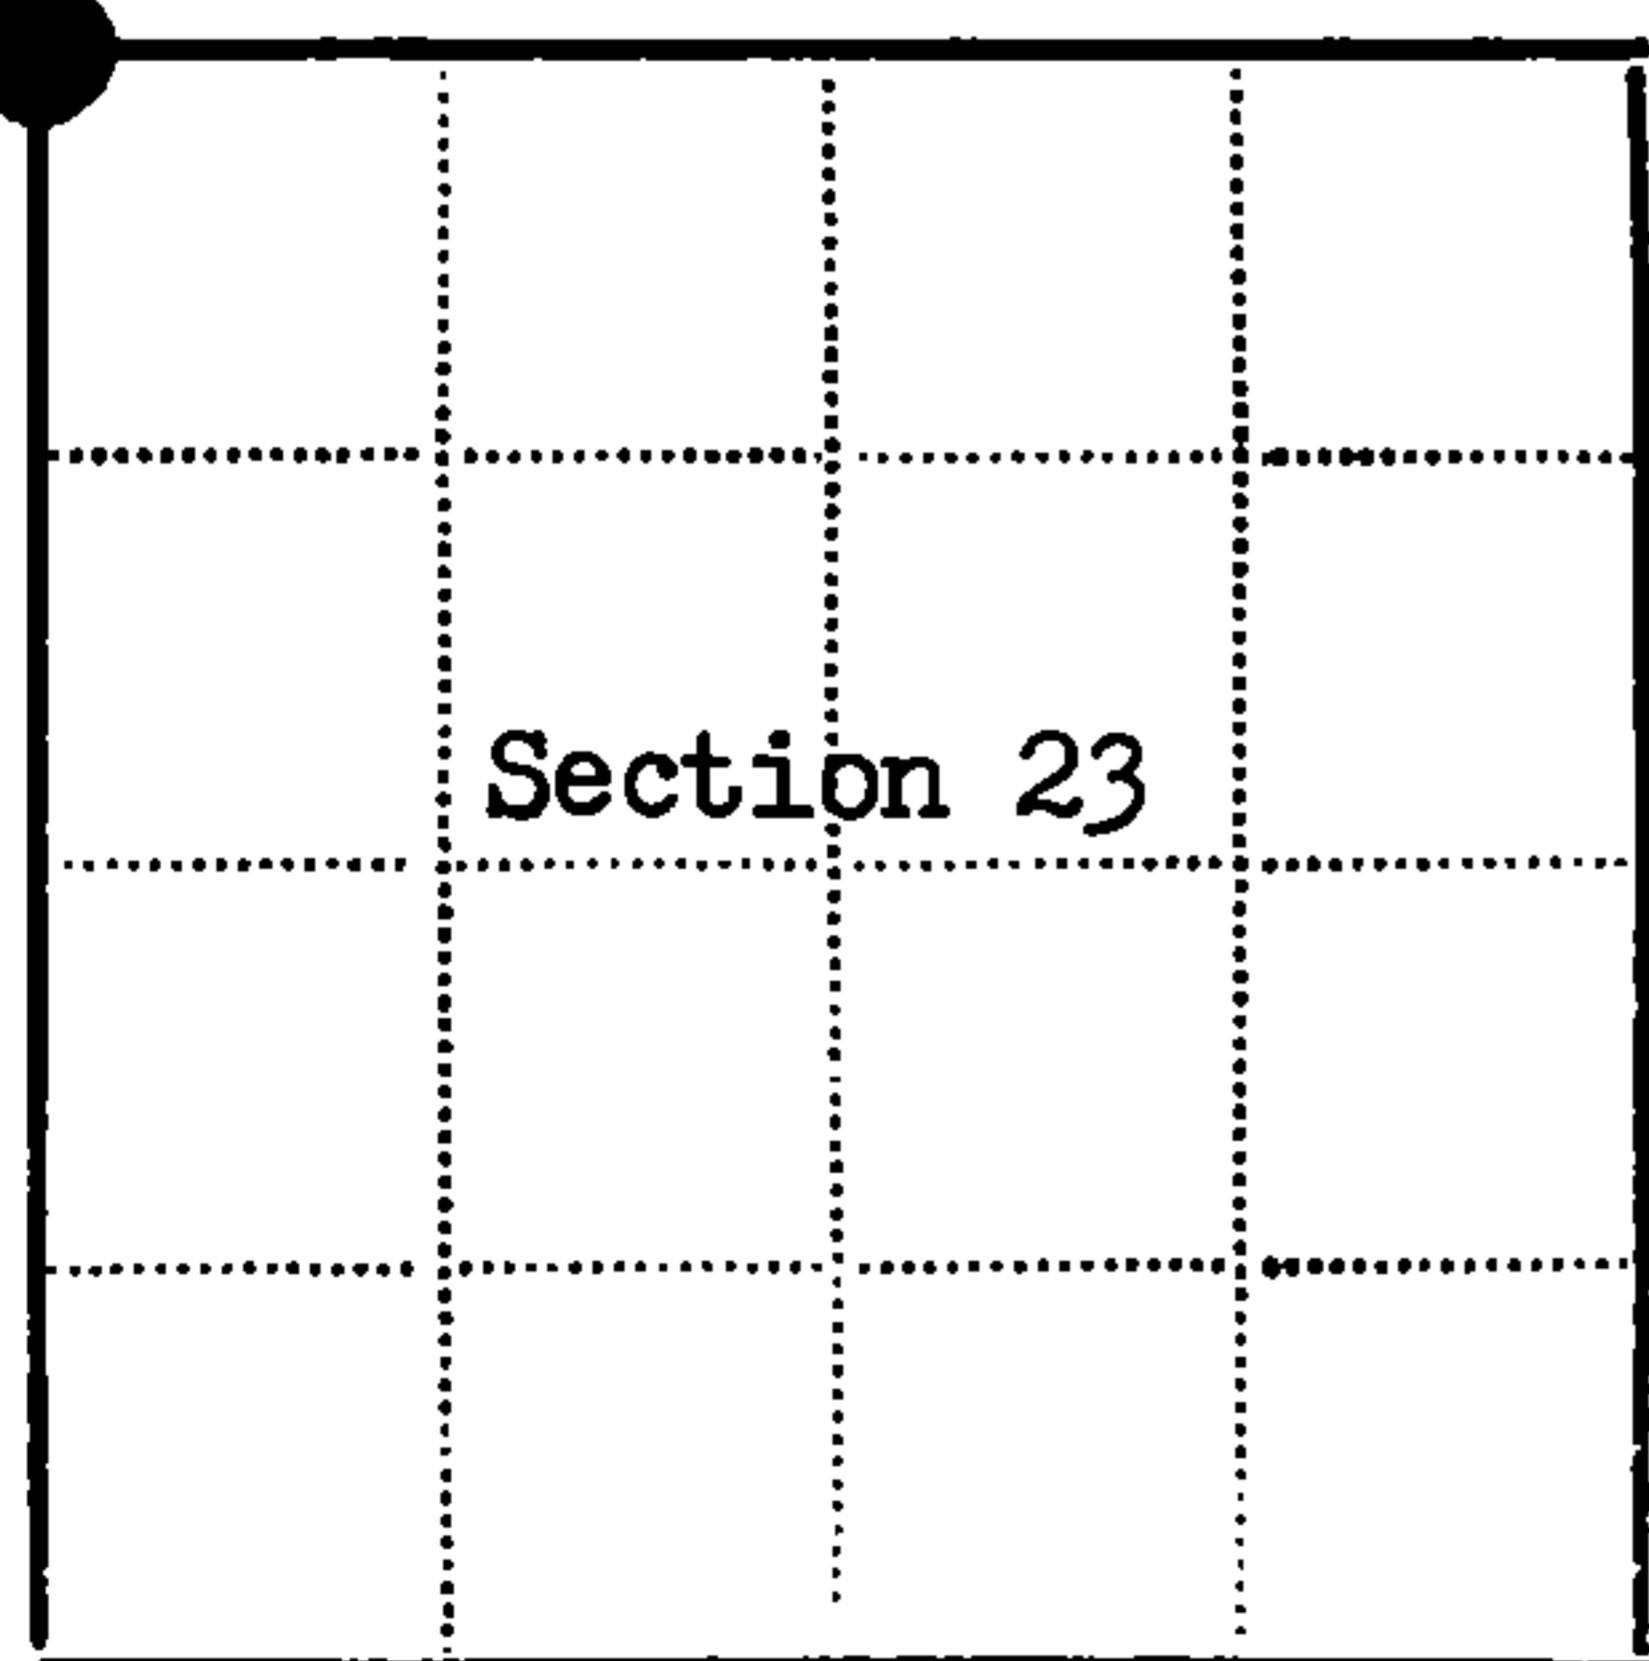

● - Corner monument restored

□ -

Resident witnesses.....

Dated at Rhinelander Wisconsin, this 4 day of MARCH 19 82.

Signature Milo E. Stefan Title Land Surveyor
(County Surveyor, Registered Land Surveyor, or other duly authorized official)

Surveyors Registration No. RLS-1558

Office of Register of Deeds County of Forest

I hereby certify that the within instrument was filed in this office for record on the 15th day of September 19 83, and was filed in Book No. Page No. of County Records.

Signature Eugene Stefany Title Register of Deeds

Township 35 North Range 14 East Section 23 Index No. N-17 Page No. 29