

CERTIFIED LAND CORNER RESTORATION

State of Wisconsin }  
County of Forest } ss.


I Milo E. Stefan, do hereby certify that on the 18th day of November, 1981, I found evidence of the North  $\frac{1}{4}$  corner of Section 22 Township 35 North, Range 14 East, Fourth Principal Meridian, as described hereon; and that from this evidence I established a new monument and accessories as described hereon to perpetuate the original location of this corner:

Description of original monument and accessories and subsequent restorations:  
Surveyed in 1859 by James McBride  
40.00 chains, set wood post  
Tamarack, 8", N40E, 98  
Fir, 7", S70E, 56  
 $\frac{1}{2}$  chain east to edge of swamp  
5 chains west to edge of swamp

Description of corner evidence found:  
Found corner marked by iron pipe, blue paint line east and west, swamp (marsh) calls fit well east and west of iron pipe.

Description of monument and accessories I established to perpetuate the location of this corner:  
Placed a 2" x 60" aluminum pipe with an aluminum cap stamped as follows:  
T35N, R14E,  $\frac{1}{4}$ , S15, S22, 1981, RLS 1558  
From which the following bear:  
W. Pine, 5", S67E, 50.60 feet  
Cedar, 10", S16W, 103.34 feet  
Set steel sign post, north, 0.6 feet

DOCUMENT NO.  
**124230**

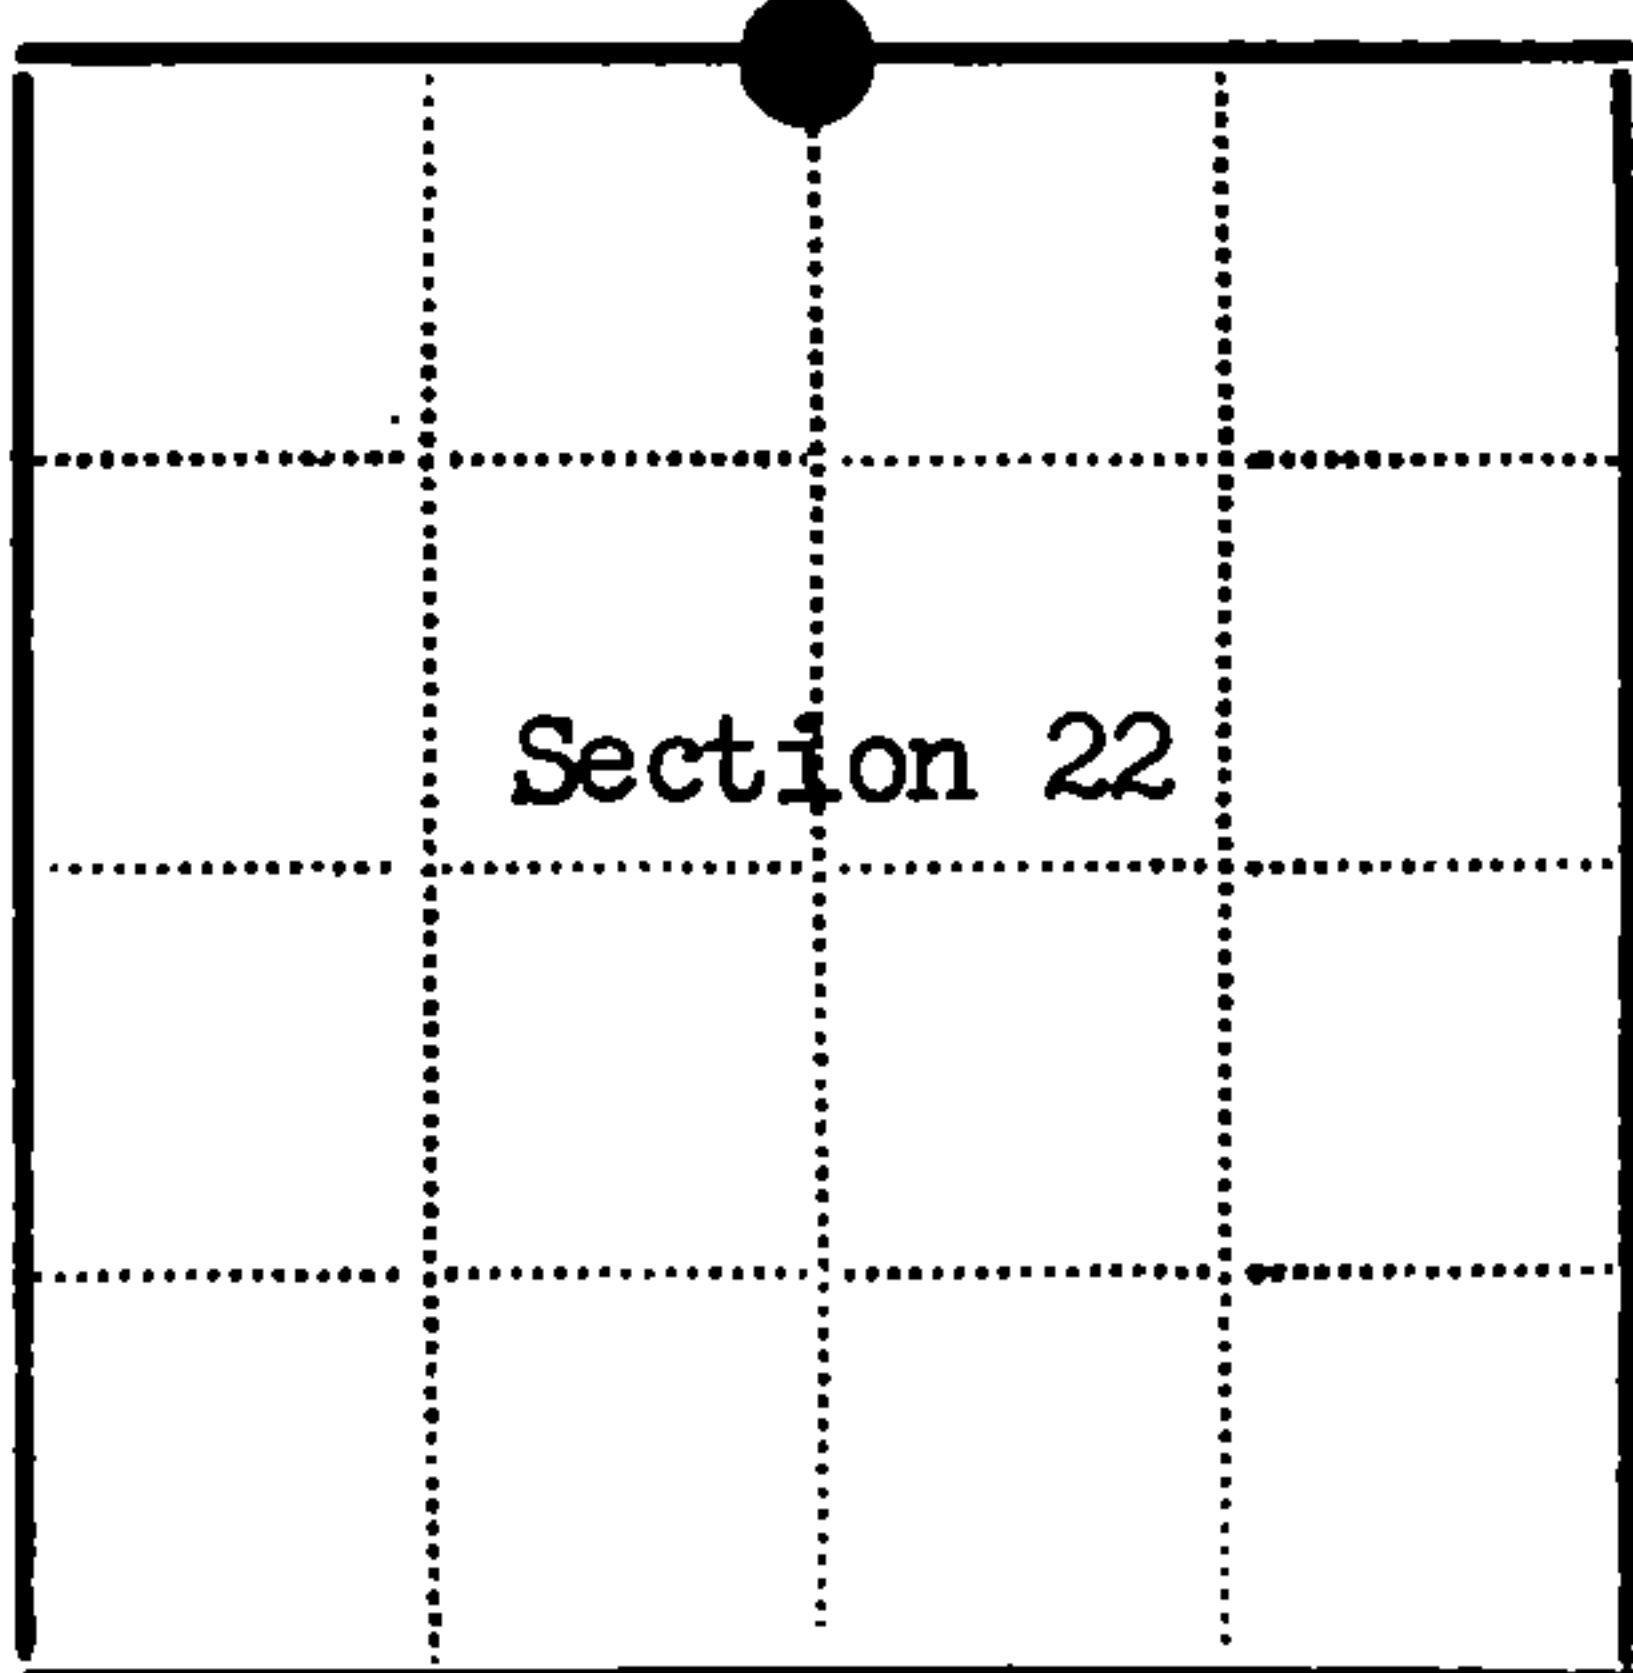

● - Corner monument restored  
□ -

Resident witnesses.....

Dated at Rhinelander Wisconsin, this 4 day of MARCH 1982.

Signature Milo E. Stefan Title Land Surveyor  
(County Surveyor, Registered Land Surveyor, or other duly authorized official)

Surveyors Registration No. RLS-1558

Office of Register of Deeds County of Forest

I hereby certify that the within instrument was filed in this office for record on the 15th day of September 1983, and was filed in Book No. Page No. of County Records.

Signature Eugene Staszewski Title Register of Deeds

Township 35 North, Range 14 East, Section 22, Index No. N-15, Page No. 1

43514150020

N15