

# CERTIFIED LAND CORNER RESTORATION

State of Wisconsin }  
County of Forest } ss.


I Milo E. Stefan, do hereby certify that on the 18th day of November, 1981, I found evidence of the East  $\frac{1}{4}$  corner of Section 15 Township 35 North Range 14 East, Fourth Principal Meridian, as described hereon; and that from this evidence I established a new monument and accessories as described hereon to perpetuate the original location of this corner:

Description of original monument and accessories and subsequent restorations:	
Surveyed in 1859 by James McBride	Surveyed in 1962 by Resvick and Harris
40.00 chains, set wood post	Found $1\frac{1}{2}$ " iron pipe and squared post 16"
Birch, 8", S81W, 14 lks., 9.24 feet	above ground in collar of stone. Squared
Sugar, 6", S54E, 30 lks., 19.8 feet	post with F.S. tag lying on ground.

Description of corner evidence found:  
Found iron pipe, Birch stump rotted to ground line, S81W, 9.24 feet; there is a stump hole, S54W, 20 feet.

Description of monument and accessories I established to perpetuate the location of this corner:  
Placed a 36" x 2" aluminum monument with tablet stamped as follows:  
T35N, R14E, S15,  $\frac{1}{4}$ , S14, 1981, RLS-1558  
Sugar, 12", N14E, 12.79 feet  
Sugar, 14", S58W, 6.20 feet  
Basswood, 12", N50W, 30.75 feet  
Set steel sign post, east, 2.4 feet  
Mound of stone around monument

DOCUMENT NO.  
**124229**

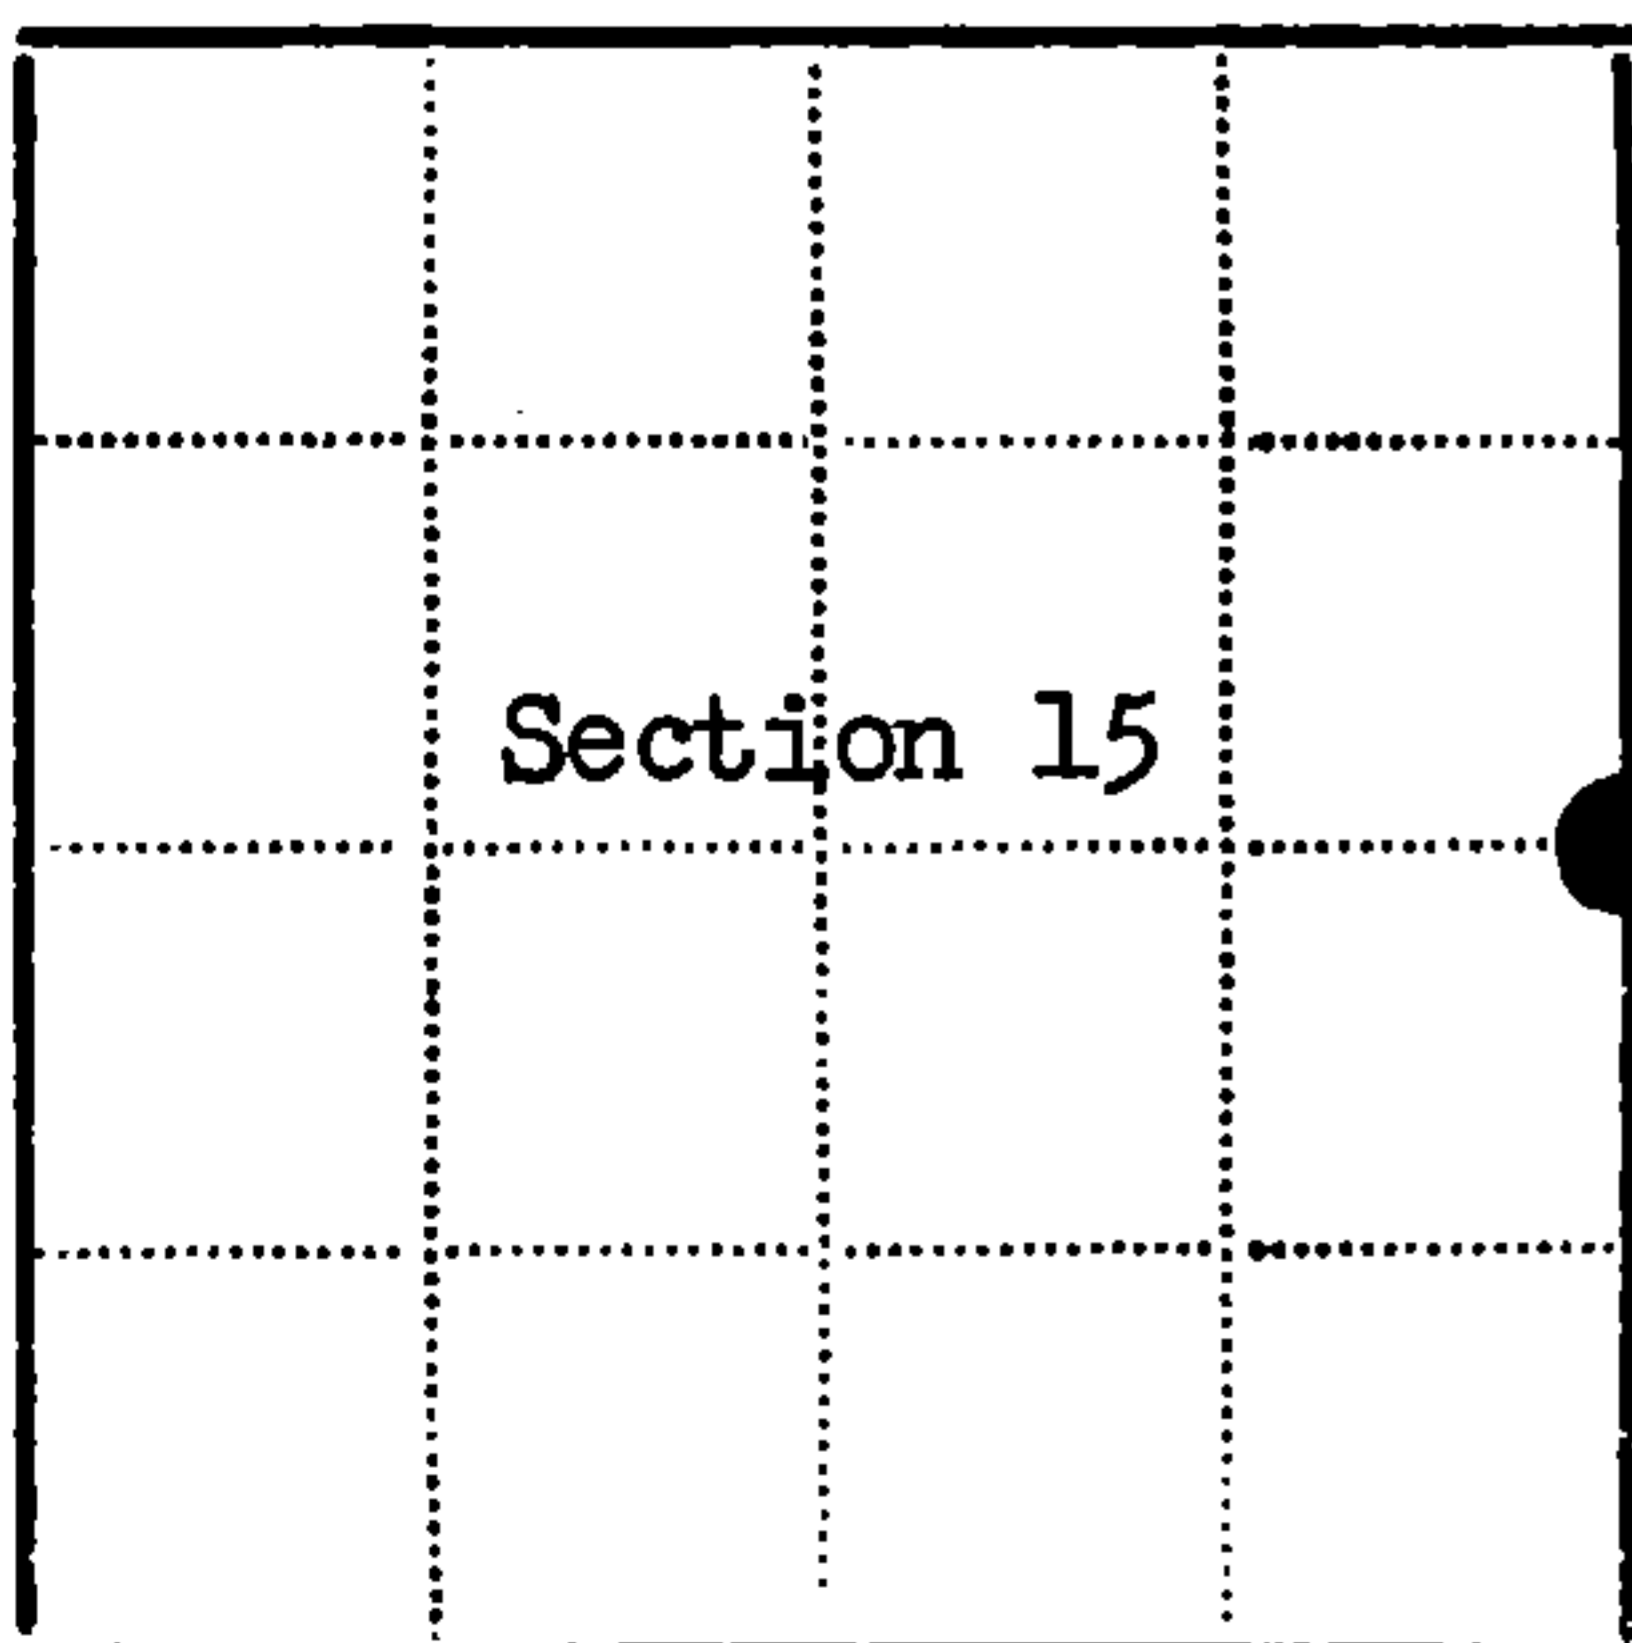

● - Corner monument restored  
□ -

Resident witnesses.....

Dated at Rhineland Wisconsin, this 4 day of March 1982.....

Signature Milo E. Stefan Title Land Surveyor  
(County Surveyor, Registered Land Surveyor, or other duly authorized official)

Surveyors Registration No. RLS-1558

Office of Register of Deeds County of Forest

I hereby certify that the within instrument was filed in this office for record on the 15th day of September 1983, and was filed in Book No. \_\_\_\_\_ Page No. \_\_\_\_\_ of County Records.

Signature Eugene Staszewski Title Register of Deeds

Township 35 North, Range 14 East, Section 15, Index No. L-17, Page No. 27