

CERTIFIED LAND CORNER RESTORATION

State of Wisconsin }
County of Forest } ss.

I Jean F. Resvick, do hereby certify that on the 5th day of August, 1971, I found evidence of the Southeast Section corner of Section 21 Township 35 North, Range 14 East, Fourth Principal Meridian, as described hereon; and that from this evidence I established a new monument and accessories as described hereon to perpetuate the original location of this corner:

Description of original monument and accessories and subsequent restorations:

Survey in 1859 by James McBride. North between Sections 27 and 28 80.00 chains
Set post.
Sugar 15, N66W, 61 lks.
Birch 16, N89E, 44 lks.
Hemlock 15, S67E, 44 lks.
Birch 16, N88W, 50 lks.


Description of corner evidence found:

2 inch inside diameter galvanized wrought iron pipe, 18 inches above ground, with brass cap stamped T35N, R14E, S21, S22, S28, S27, 1961. 4x4 white post set on south side of monument.
N66W, 61 lks. from monument, sugar stump
N89E, 44 lks. from monument, stump hole
S67E, 44 lks. from monument, Hemlock stump
N88W, 50 lks. from monument, stump hole

Description of monument and accessories I established to perpetuate the original location of this corner:

Blazed and scribed the following new bearing trees.
Maple 7, bears N32E, 5.70 feet
White Birch 8, bears S62E, 13.10 feet
Maple 7, bears S13W, 44.50 feet
Maple 7, bears N55W, 45.59 feet

25 feet North to centerline railroad tram, bears NE-SW

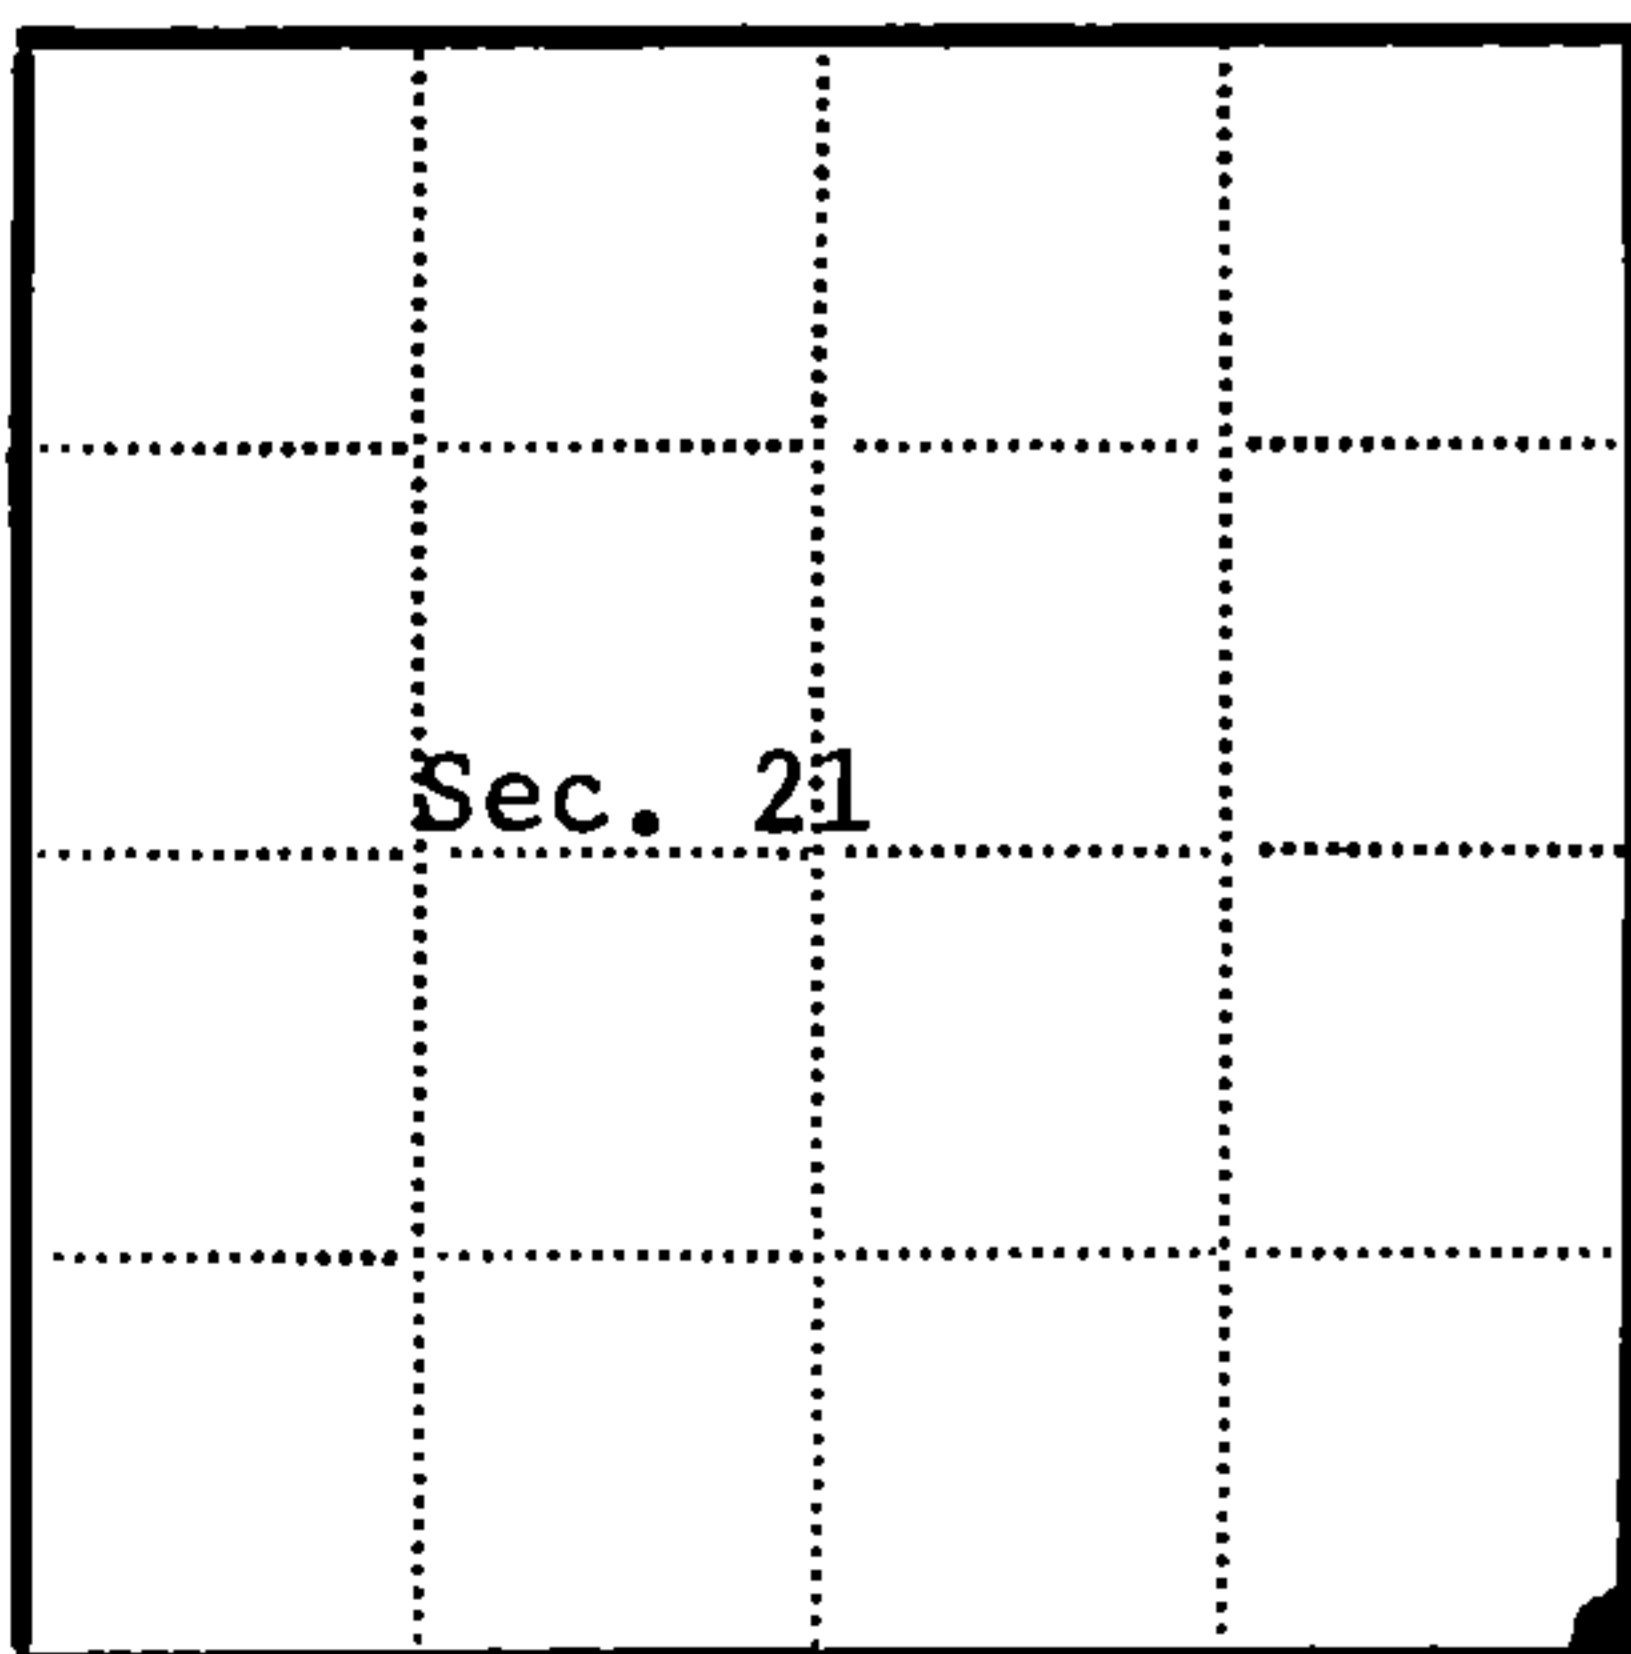

● = Corner monument restored
□ =

Resident witnesses.....

Dated at Rhinelander Wisconsin, this 23rd day of August, 1971.

Signature Jean F. Resvick Title Land Surveyor
(County Surveyor, Registered Land Surveyor, or other duly authorized official)

Surveyors Registration No. S-802 DOCUMENT NO. 101027

Office of Register of Deeds County of Forest

I hereby certify that the within instrument was filed in this office for record on the 20th day of January 1972, and was filed in Book No. Page No. R-13 of County Records.

Signature..... Title Register of Deeds

Township 35 North, Range 14 East, Section 21, Index No. R-13, Page No.

43514210000

R13