


U. S. PUBLIC LAND SURVEY MONUMENT RECORD

INSTRUCTIONS:

This record shall show the location of the corner and shall include all of the following nine elements (a through i).

- (a) Identify the corner by reference to the U.S. public land survey system.  
 ○ = Corner monument restored.

Quarter Corner to Sections 21 and 28, T.35N., R.14E., Forest County, WI.

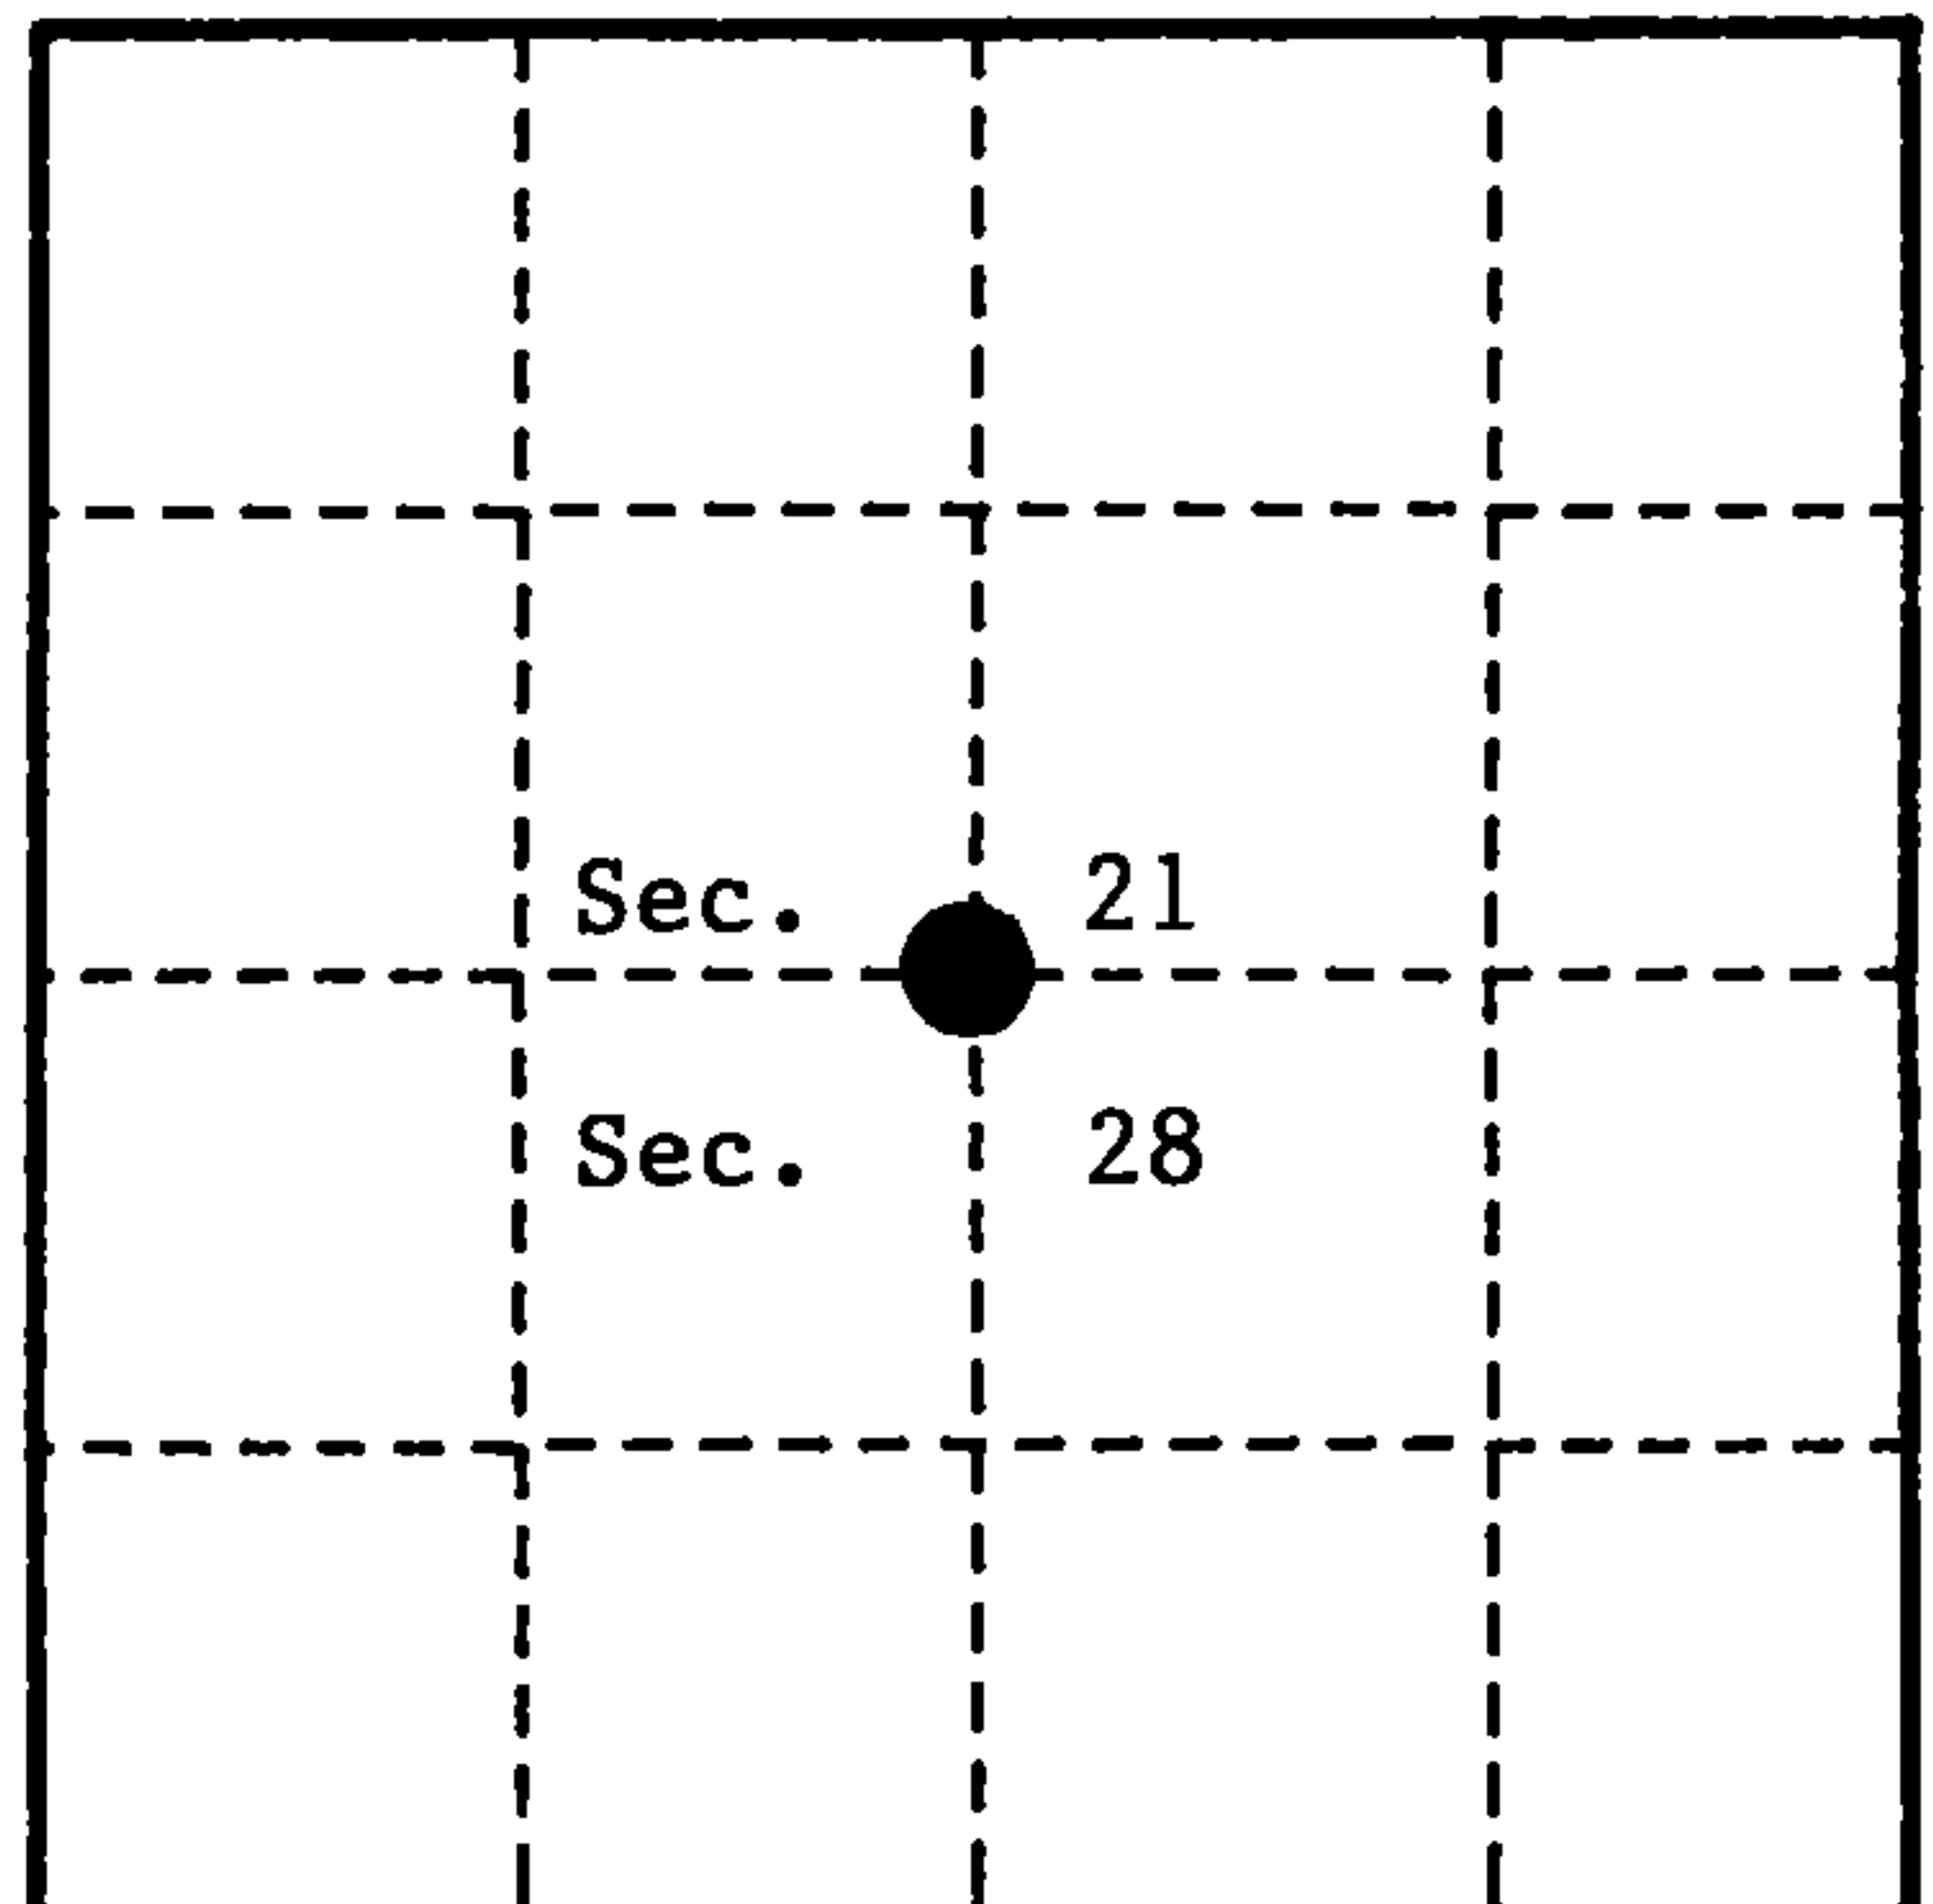

- (b) Describe any record evidence, monument evidence, occupational evidence, testimonial evidence or any other material evidence you considered, and whether the monument was found or placed.

Original survey in 1859 by James McBride. Set wood post and the following bearing trees; Lind, 6", S.17°E., 28 links, (18.48 feet), Aspen, 6", N.34°E., 50 links, (33.00 feet).

On July 27, 1936 A.J.V. Vronch, a compassman with the U.S. Forest Service, found a wood post and the following blazed and scribed bearing trees; Basswood, 14", S.42°E., 9 links (5.94 feet), Basswood, 12", N.30°E., 3 links (1.98 feet), He placed a metal location poster on the Northwest side of the Basswood which bears S.42°E., 5.94 feet from the wood post.


On August 14, 1985 Alan Harrison, R.L.S., found a rock pile with a post point in middle from which an 18" Basswood with location poster bears S.42°E., 5.94 feet this bearing tree has grown over bearing tree and D.B.H. blazes. Also found a 20" wide stump depression, N.30°E., 1.98 feet and a 20" wide stump depression, S.17°E., 18.5 feet which fits for original Linden.

On September 6, 1994, Alan Harrison, R.L.S., found the same evidence as found in 1985. In place of post point set a 2 1/2" x 36" aluminum monument and blazed and scribed 2 new bearing trees as noted below.

- (c) In the plan view drawing below, provide reference ties to at least 4 witness monuments, or, if the location is within a municipality, to at least 2 witness monuments. (witness monuments shall be made of concrete, natural stone, iron or other equally durable material.)

- (d) Show a plan view drawing depicting the relevant monuments and reference ties which is sufficient in detail to enable accurate relocation of the corner monument if the corner monument is disturbed. Indicate north.

1. 2 1/2" x 36" aluminum monument with tablet stamped to identify corner.
2. Sugar, 12", N.25°E., 11.09 feet.
3. Basswood, 18", S.42°E., 5.94 feet.
4. Sugar, 13", S.71°W., 16.36 feet.
5. Steel Sign Post, Northeast, 1.15 feet.

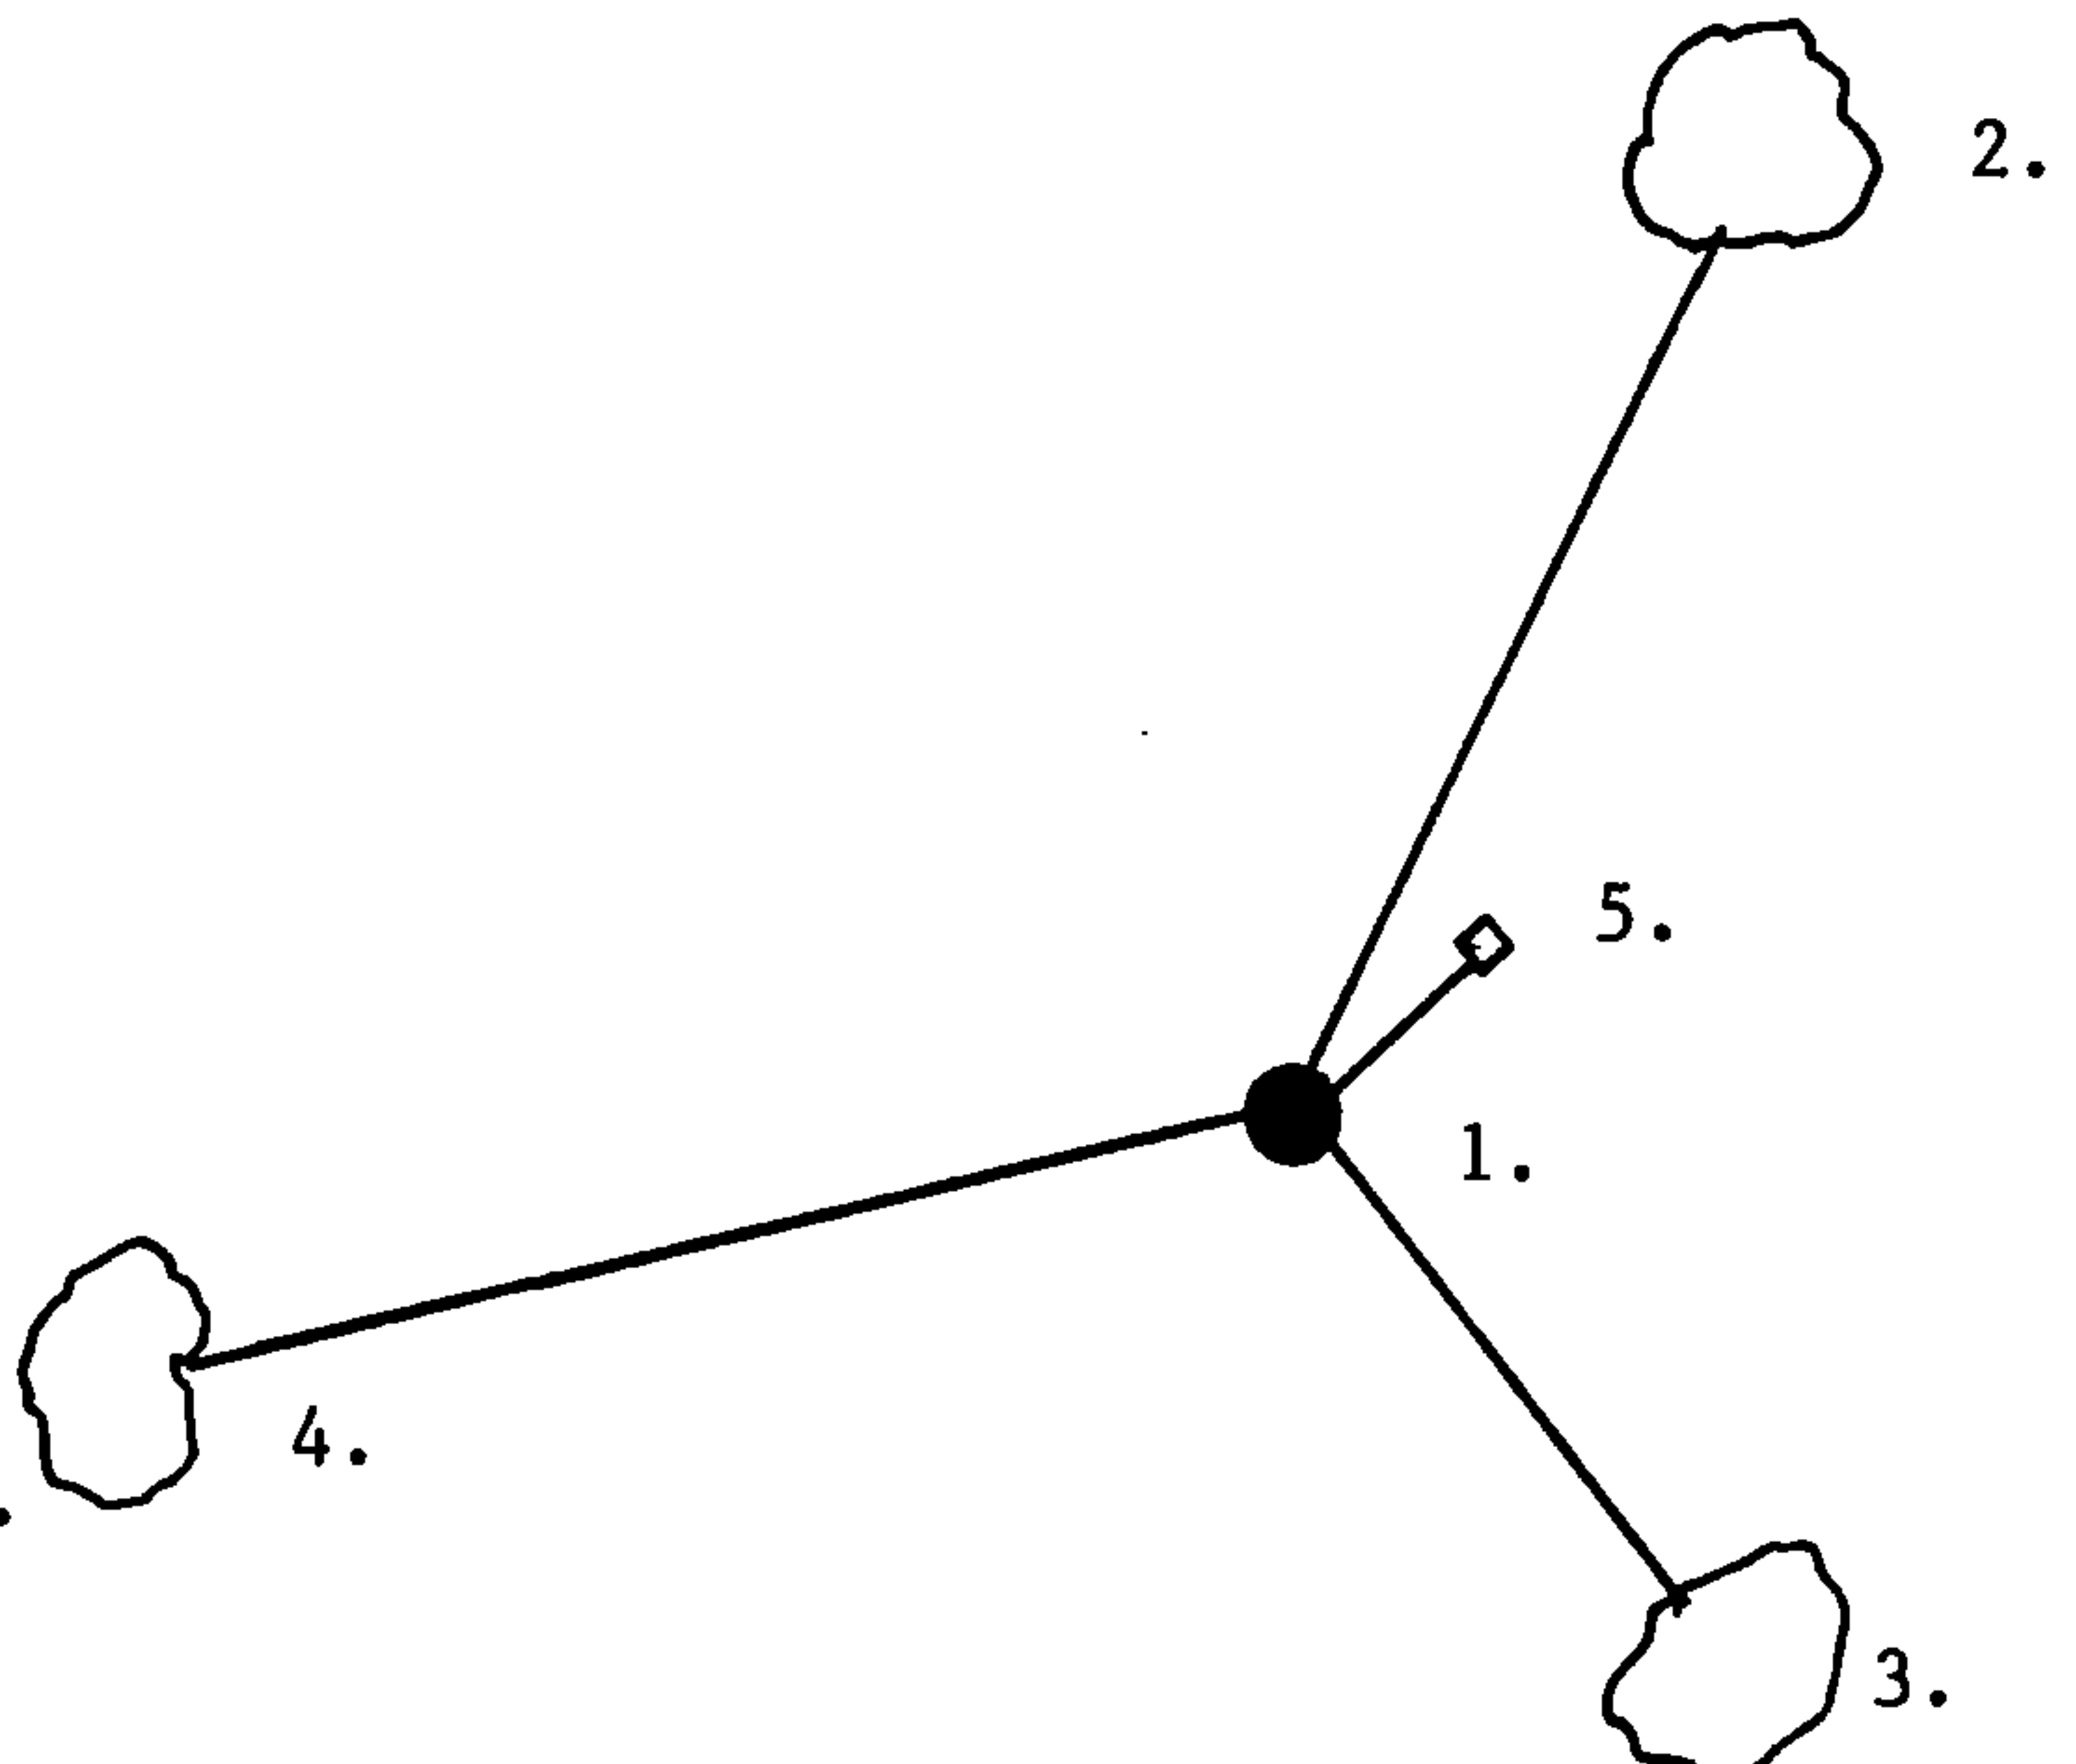

(e) Describe any material discrepancy between the location of the corner as restored or reestablished and the location of that corner as previously restored or reestablished by distance and direction. Show the discrepancy on the plan view drawing under (d), above. Show the distances between the corner as previously restored or reestablished and (1) the corner as restored or reestablished, and (2) to at least 2 of the witness monuments shown on the drawing in (d), above.

None

(f) Was the corner restored through acceptance of (1) an obliterated evidence location, or, (2) a found perpetuated location?

(2)

(g & h) Was the corner reestablished through lost corner proportionate methods? If so, show the method, including the directions and distances to other public land survey corners used as evidence or used for proportioning in determining the corner location?

No

REGISTER'S OFFICE  
Forest County, Wis.  
Received for record this 23rd day  
of November A.D., 1994 at  
9:00 o'clock A.M. and recorded  
in Vol. Cape Restoration  
page 35-N, R-11  
*Paul Chittka, Deputy*  
Register of Deeds

(1) I, Alan D. Harrison

(type or print name) certify that the corner location shown on this record was determined by me or under my direction and control and that this U.S. Public Land Survey Monument Record is correct and complete to the best of my knowledge and belief.

*Alan D. Harrison* 10/31/94  
Signature Date

CERTIFICATE READY FOR FILING:

*Sue Vap*  
District Ranger

