

CERTIFIED LAND CORNER RESTORATION

State of Wisconsin }  
County of Forest } ss.

I Jean F. Resvick, do hereby certify that on the 7 day of April, 1977, I found evidence of the Northeast corner of Section 33 Township 35 North, Range 14 East, Fourth Principal Meridian, as described hereon; and that from this evidence I established a new monument and accessories as described hereon to perpetuate the original location of this corner:

Description of original monument and accessories and subsequent restorations:



Surveyed in 1859 by James McBride  
80.0 chains north between sections 33 and 34, set post  
Birch 16", N58°W, 36 lks.  
Lin. 24", N38°E, 45 lks.  
Birch 30", S32°E, 55 lks.  
Birch 14", S72°W, 42 lks.

Description of corner evidence found:

Found iron pipe in mound of rock  
Distances from corners north, south, and east check.

Description of monument and accessories I established to perpetuate the location of this corner:

Replaced iron pipe with a 2 inch inside diameter galvanized iron pipe, 3 feet long, filled with concrete with a brass cap stamped:  
T35N, R14E, S28, S27, S33, S34, 1977, S-802  
Blazed and scribed the following new bearing trees:  
Cherry 5", N81°E, 34.51 feet  
Cherry 5", S55°W, 26.73 feet  
Set a steel sign post north 0.30 feet

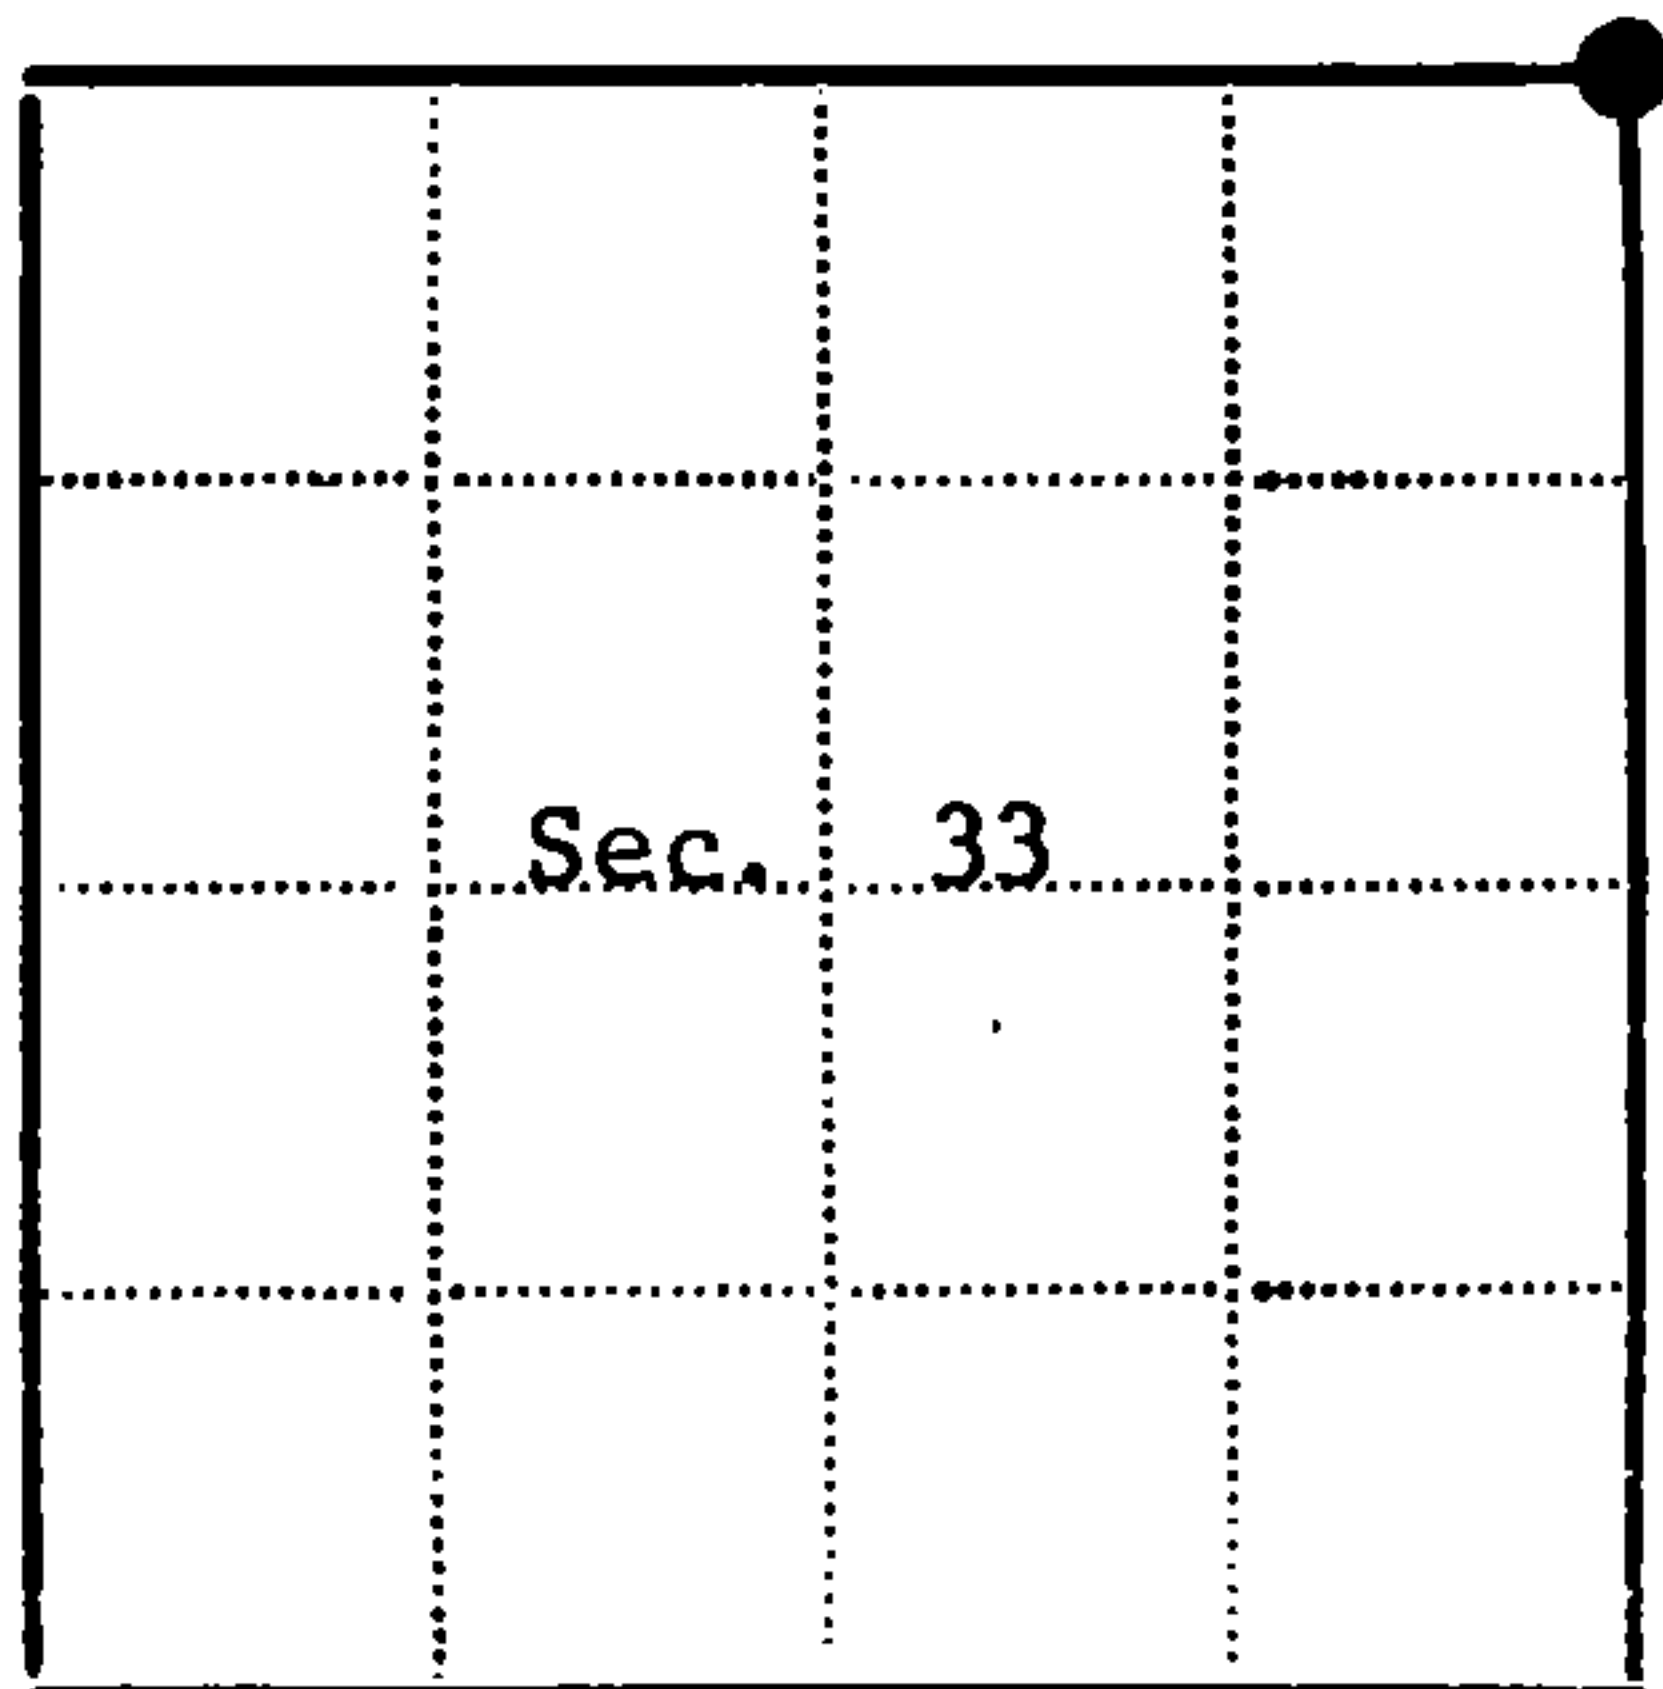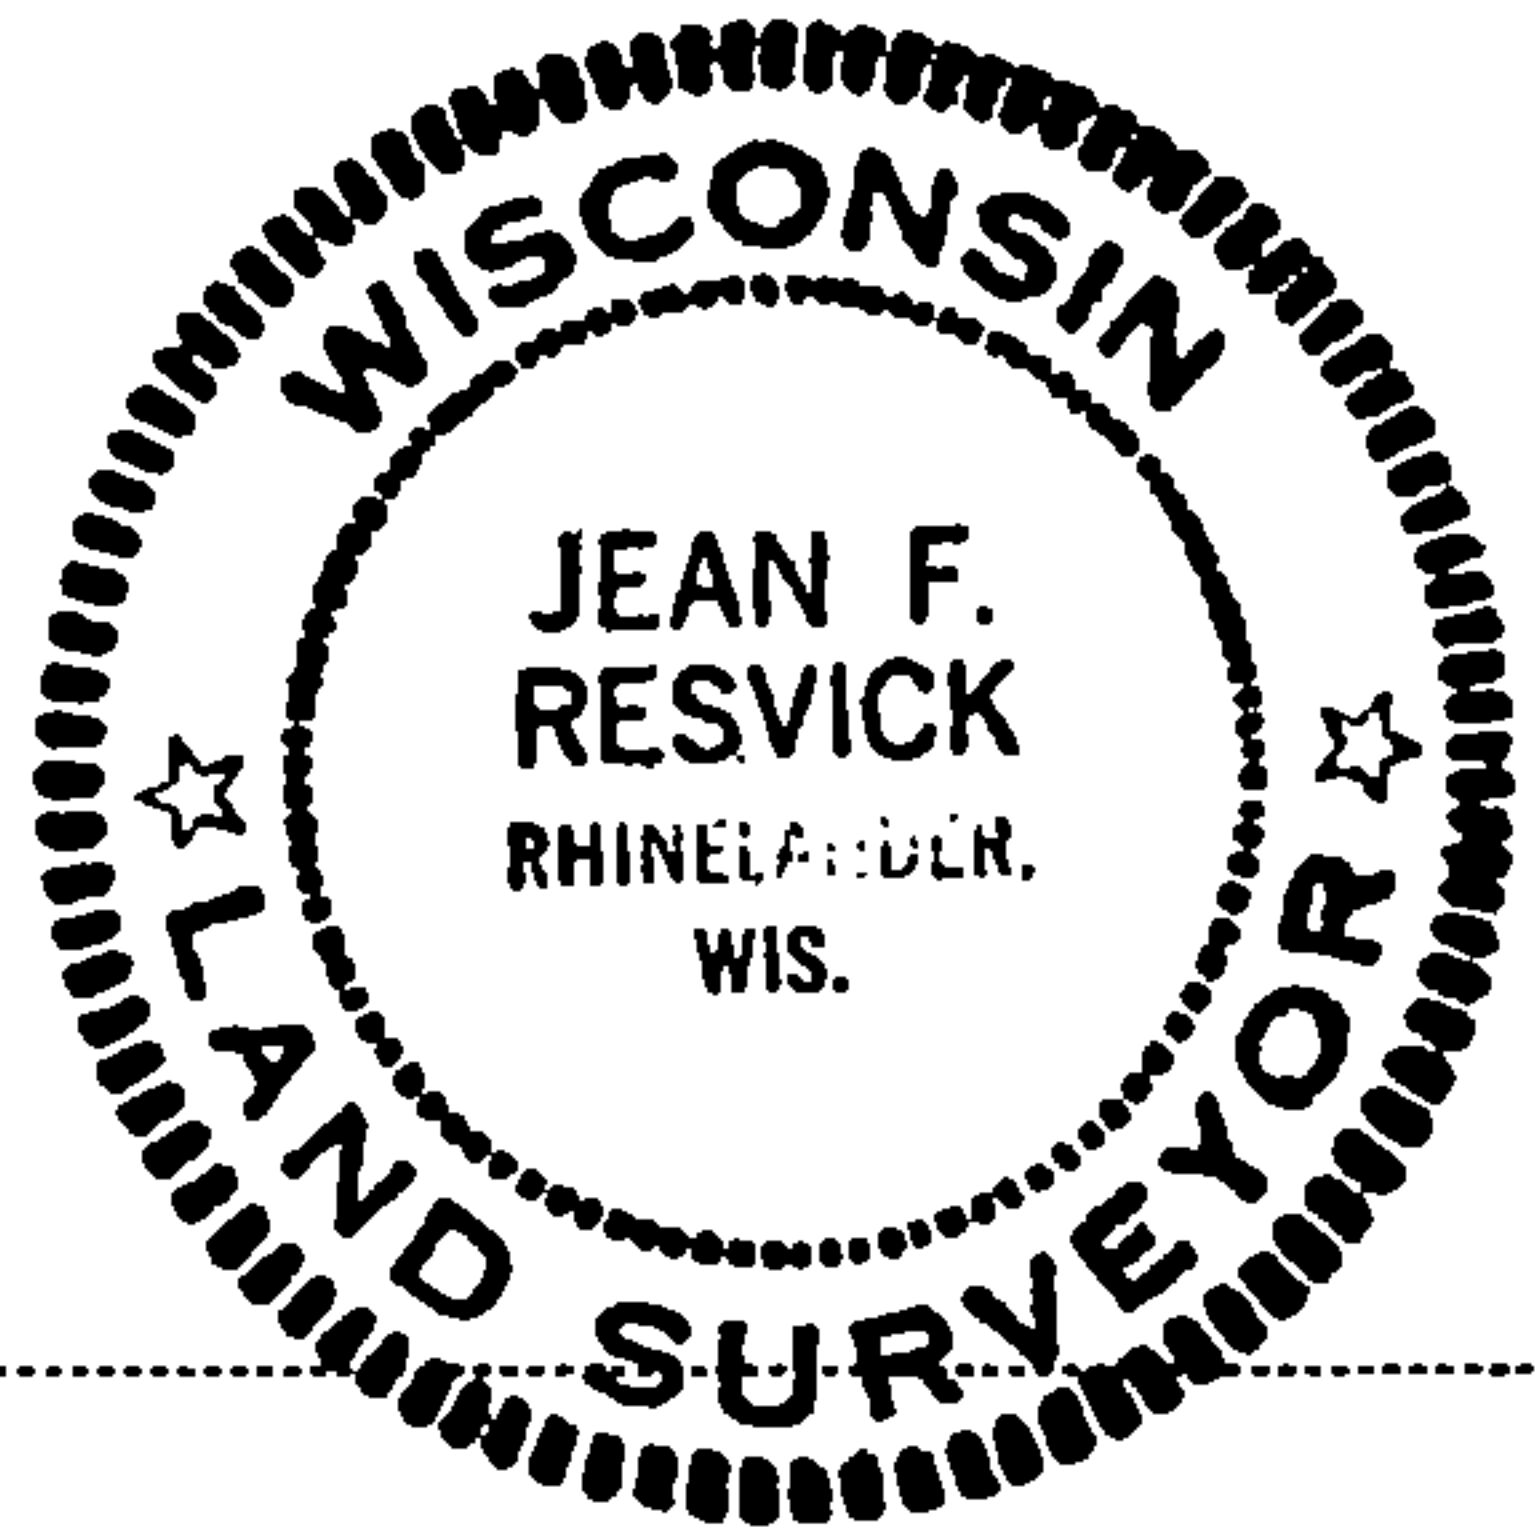

● - Corner monument restored  
□ -

Resident witnesses.....

Dated at Rhinelander Wisconsin, this 21 day of July 1977.

Signature *Jean F. Resvick* Title Land Surveyor  
(County Surveyor, Registered Land Surveyor, or other duly authorized official)

Surveyors Registration No. S-802

DOCUMENT NUMBER  
**113286**

Office of Register of Deeds County of Forest

I hereby certify that the within instrument was filed in this office for record on the 13th day of February 1978, and was filed in Book No. Page No. of County Records.

Signature *Eugene Stutzman* Title Register of Deeds


Township 35 North, Range 14 East, Section 33, Index No. V-13, Page No.

## U. S. PUBLIC LAND SURVEY MONUMENT RECORD

**INSTRUCTIONS:** This record shall show the location of the corner and shall include all of the following nine elements (a through i).

- (a) Identify the corner by reference to the U.S. public land survey system.  
 ○ = Corner monument restored.

Section corner to Sections 27-28-33-34,  
 T.35N., R.14E., Forest County, Wisconsin.

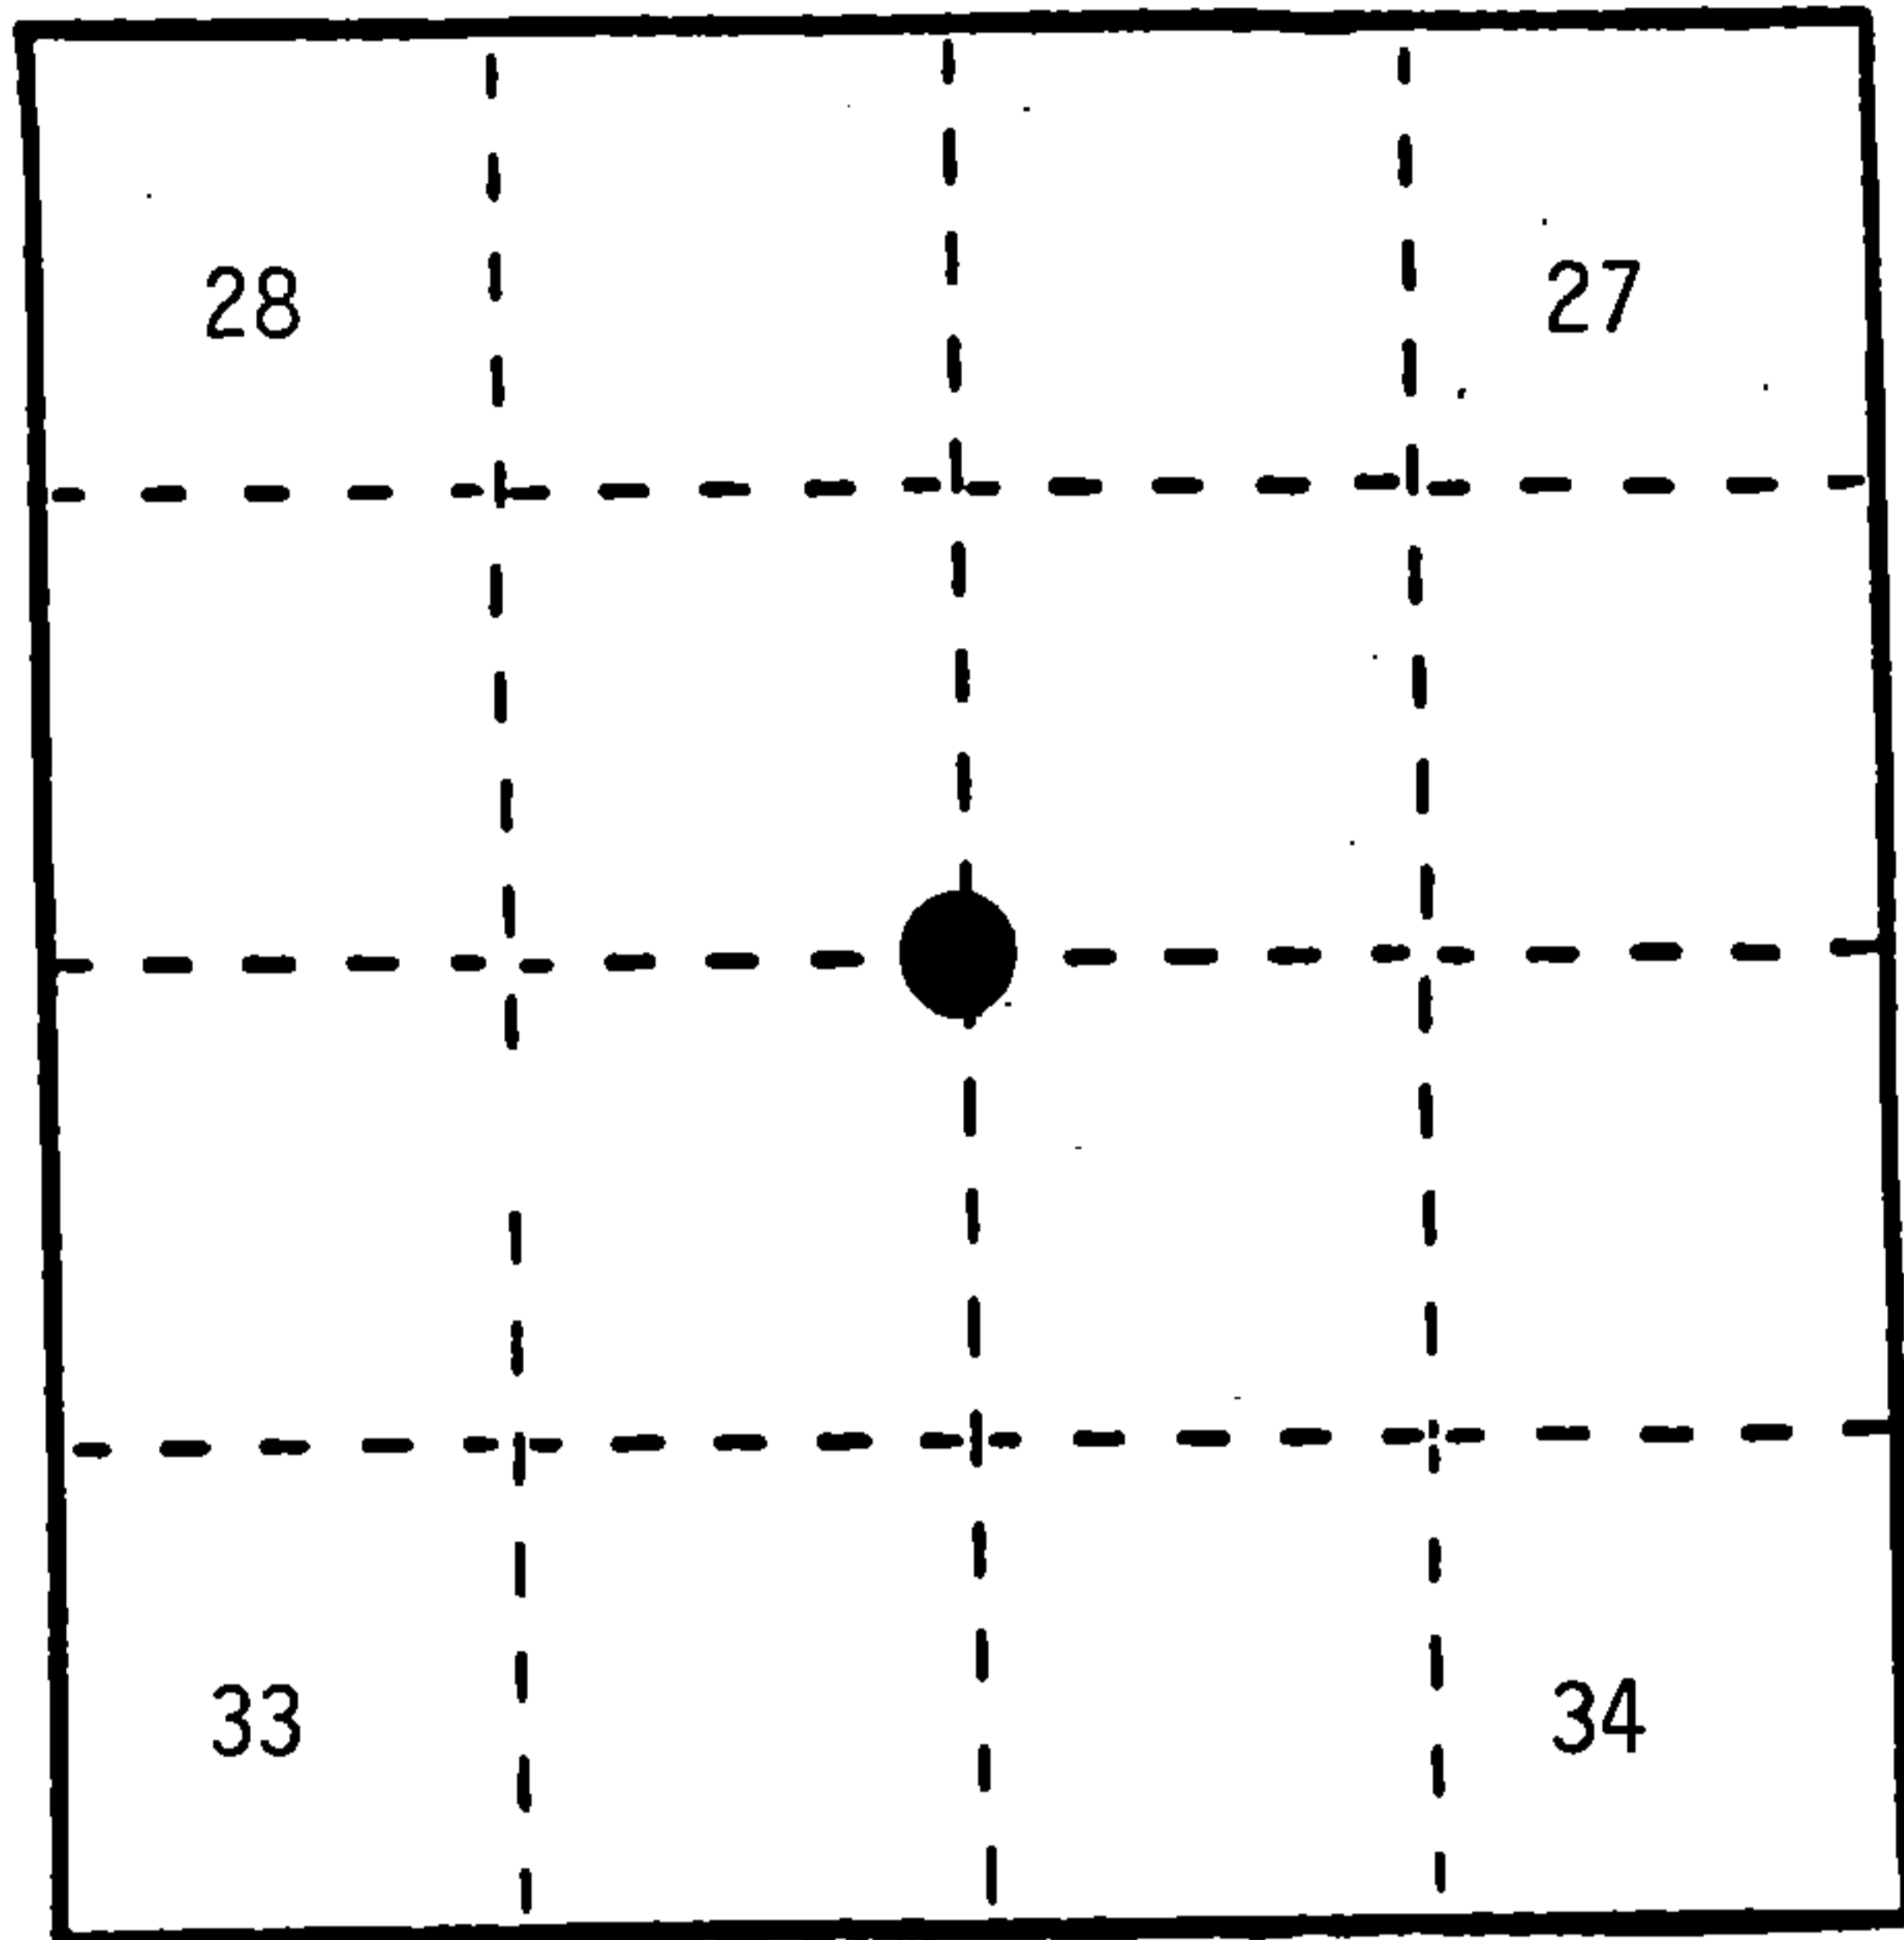

REGISTER'S OFFICE  
 Forest County, Wis.  
 Received for record this 10<sup>th</sup> day  
 of May A.D., 1989 at  
9:35 o'clock A.M. and recorded  
 in Vol. CORNER RESTORATIONS  
 page V-13

Register of Deeds

- (b) Describe any record evidence, monument evidence, occupational evidence, testimonial evidence or any other material evidence you considered, and whether the monument was found or placed.

In 1859, James McBride set a wood post and made the following BTs: Birch, 16", N.58W., 36 links; Lynn, 24", N.38E., 45 links; Birch, 30", S.32E., 55 links; Birch, 14", S.72W., 42 links.


In 1972, Jean Resvick found an iron pipe in a mound of rock and in 1977 he measured distances from corners North, South and East and found them to check. He replaced iron pipe with a 2"x 36" galvanized iron pipe, filled with concrete with a brass cap stamped to identify the corner.

In 1988, Al Harrison found the corner as per Jean Resvick and added new references to it.

- (c) In the plan view drawing below, provide reference ties to at least 4 witness monuments, or, if the location is within a municipality, to at least 2 witness monuments. (Witness monuments shall be made of concrete, natural stone, iron or other equally durable material.) Describe witness monuments.

- (d) Show a plan view drawing depicting the relevant monuments and reference ties which is sufficient in detail to enable accurate relocation of the corner monument if the corner monument is disturbed. Indicate north.

1. 2"x 36" galvanized iron pipe filled with concrete with brass tablet stamped to identify the corner.
2. Cherry, 7", N.81E., 34.51 feet
3. Cherry, 7", S.13E., 21.81 feet
4. Cherry, 7", S.55W., 26.73 feet
5. Cherry, 5", N.72W., 43.60 feet
6. Steel Sign Post, North, 0.30 feet
7. Steel Sign Post, 6', South, 2.98 feet

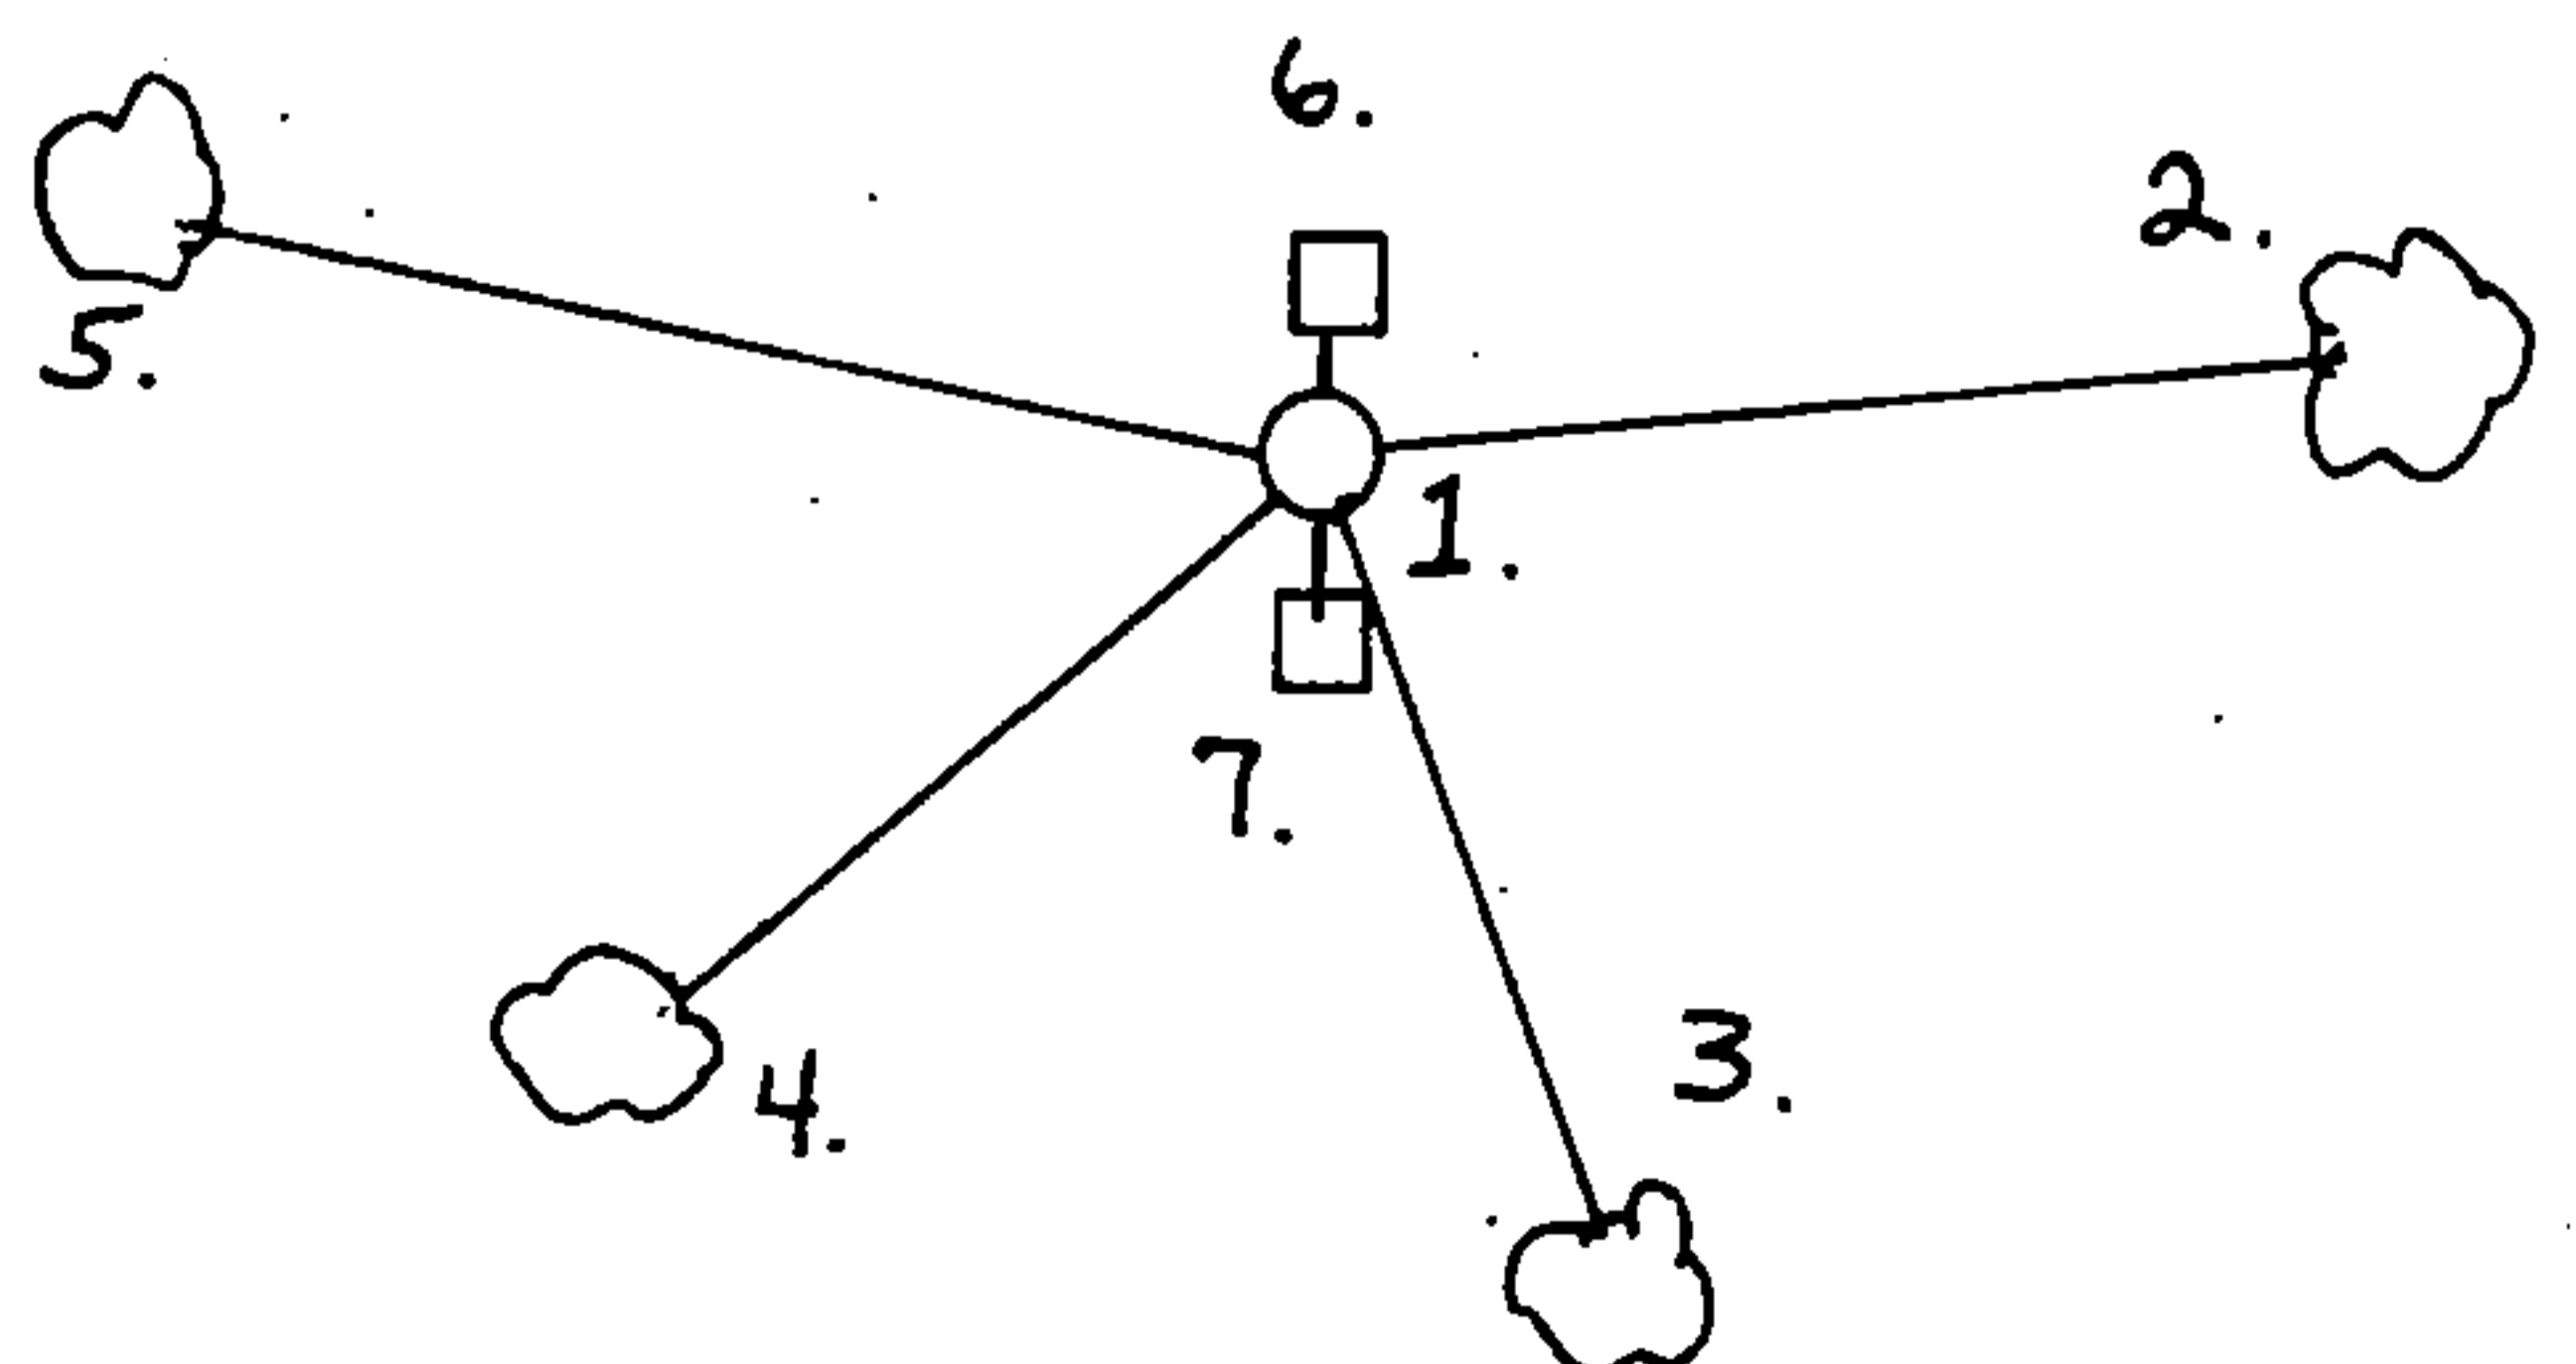

(e) Describe any material discrepancy between the location of the corner as restored or reestablished and the location of that corner as previously restored or reestablished by distance and direction. Show the discrepancy on the plan view drawing under (d), above. Show the distances between the corner as previously restored or reestablished and (1) the corner as restored or reestablished, and (2) to at least 2 of the witness monuments shown on the drawing in (d), above.


None.

(f) Was the corner restored through acceptance of (1) an obliterated evidence location, or, (2) a found perpetuated location?

a found perpetuated location.

(g&h) Was the corner reestablished through lost corner proportionate methods? If so, show the method, including the directions and distances to other public land survey corners used as evidence or used for proportioning in determining the corner location?

No.

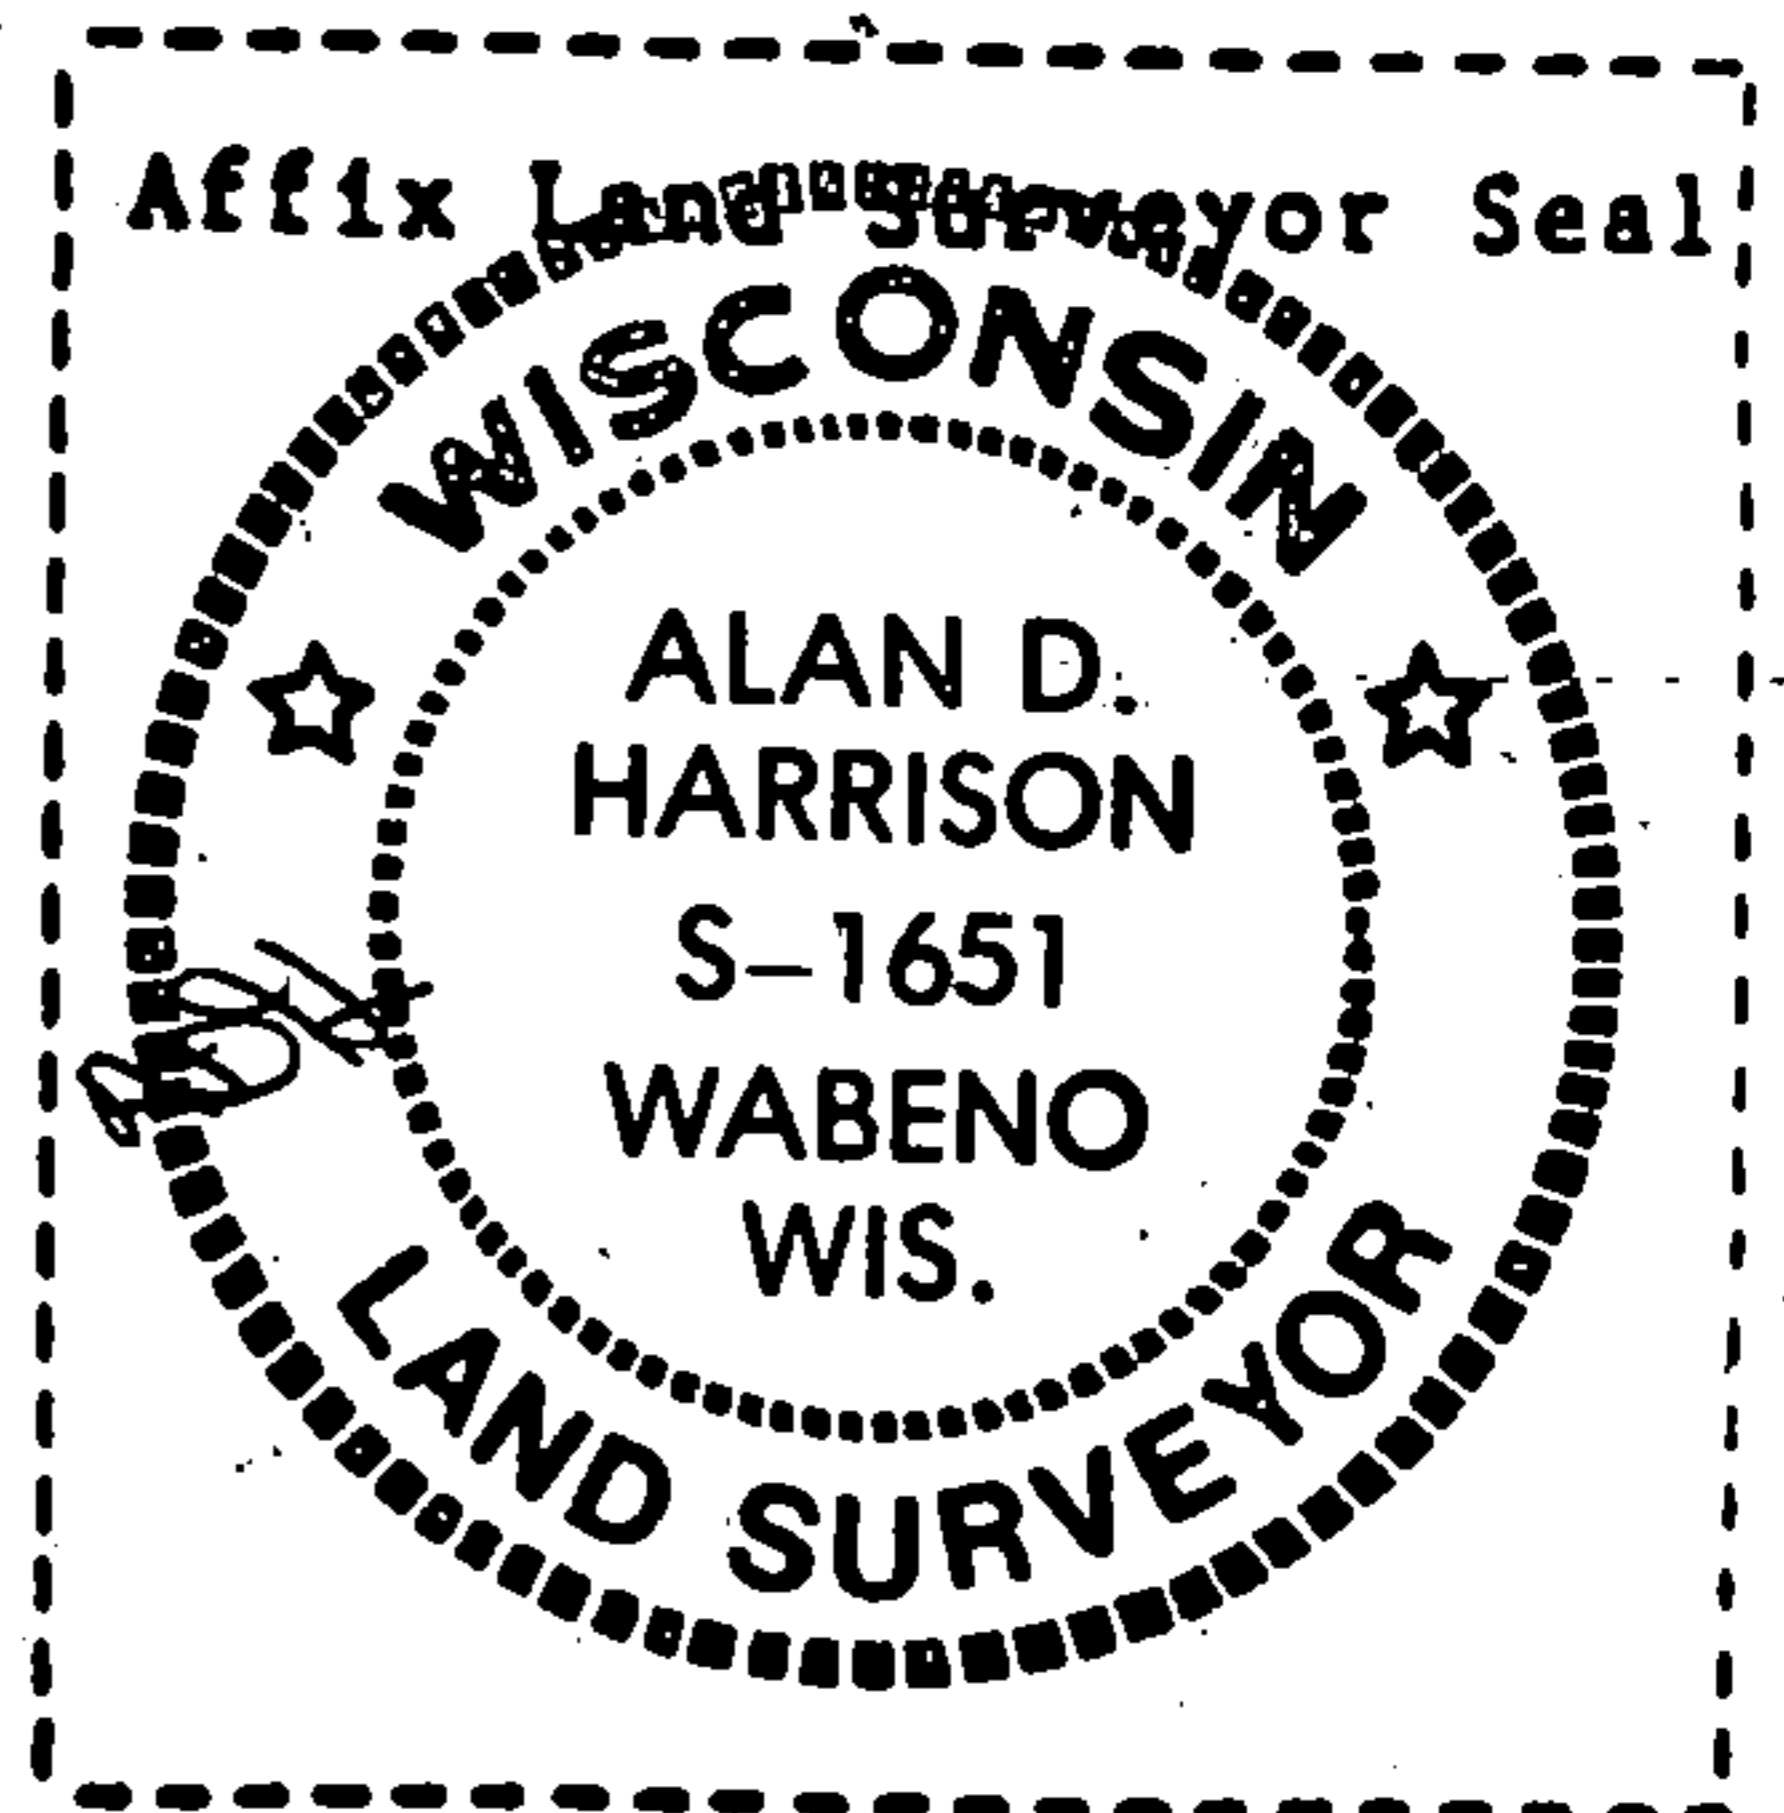

(1) I, Alan D. Harrison  
(type or print name) certify that the corner location shown on this record was determined by me or under my direction and control and that this U.S. Public Land Survey Monument Record is correct and complete to the best of my knowledge and belief.

Alan D. Harrison 4/27/89  
Signature Date

Certificate ready for filing. Dale S. Stage  
District Ranger