

CERTIFIED LAND CORNER RESTORATION

State of Wisconsin }
County of Forest } ss.

I Jean F. Resvick, do hereby certify that on the 10 day of May, 1977, I found evidence of the North quarter corner of Section 3 Township 34 North, Range 14 East, Fourth Principal Meridian, as described hereon; and that from this evidence I established a new monument and accessories as described hereon to perpetuate the original location of this corner:

Description of original monument and accessories and subsequent restorations:



Surveyed in 1854 by Alfred Millard
40 chains west between Sections 3 and 34, set post
Tamarack 7, N55W, 34 links
Tamarack 10, S27E, 42 links
14.0 ch. east leave open swamp bears SE-NW
11.5 ch. west, tamarack 18"
30.0 ch. west leave swamp bears SE-NW

Description of corner evidence found:

Tamarack stump, cut off above DBH blaze, scribing visible, was 10" when scribed.
At N27W, 42 links from stump found post point under moss and small spruce
11.5 ch. west fallen 18" tamarack
14 ch. east leave swamp
30 ch. west leave swamp

Description of monument and accessories I established to perpetuate the location of this corner:

Replaced post point with a 2 inch inside diameter galvanized iron pipe, 3 feet long, filled with concrete with another 3 foot section of 2 inch pipe threaded on the bottom with standard pipe coupling, with brass cap stamped: T35N R14E, S34, 1/4, S3, T34N, 1977, S-802
Blazed and scribed the following new bearing trees:
Tamarack 5, N69E, 9.66 ft.
Tamarack 7, S48E, 18.85 ft.
Tamarack 5, S44W, 14.16 ft.
Set steel sign post on east side monument

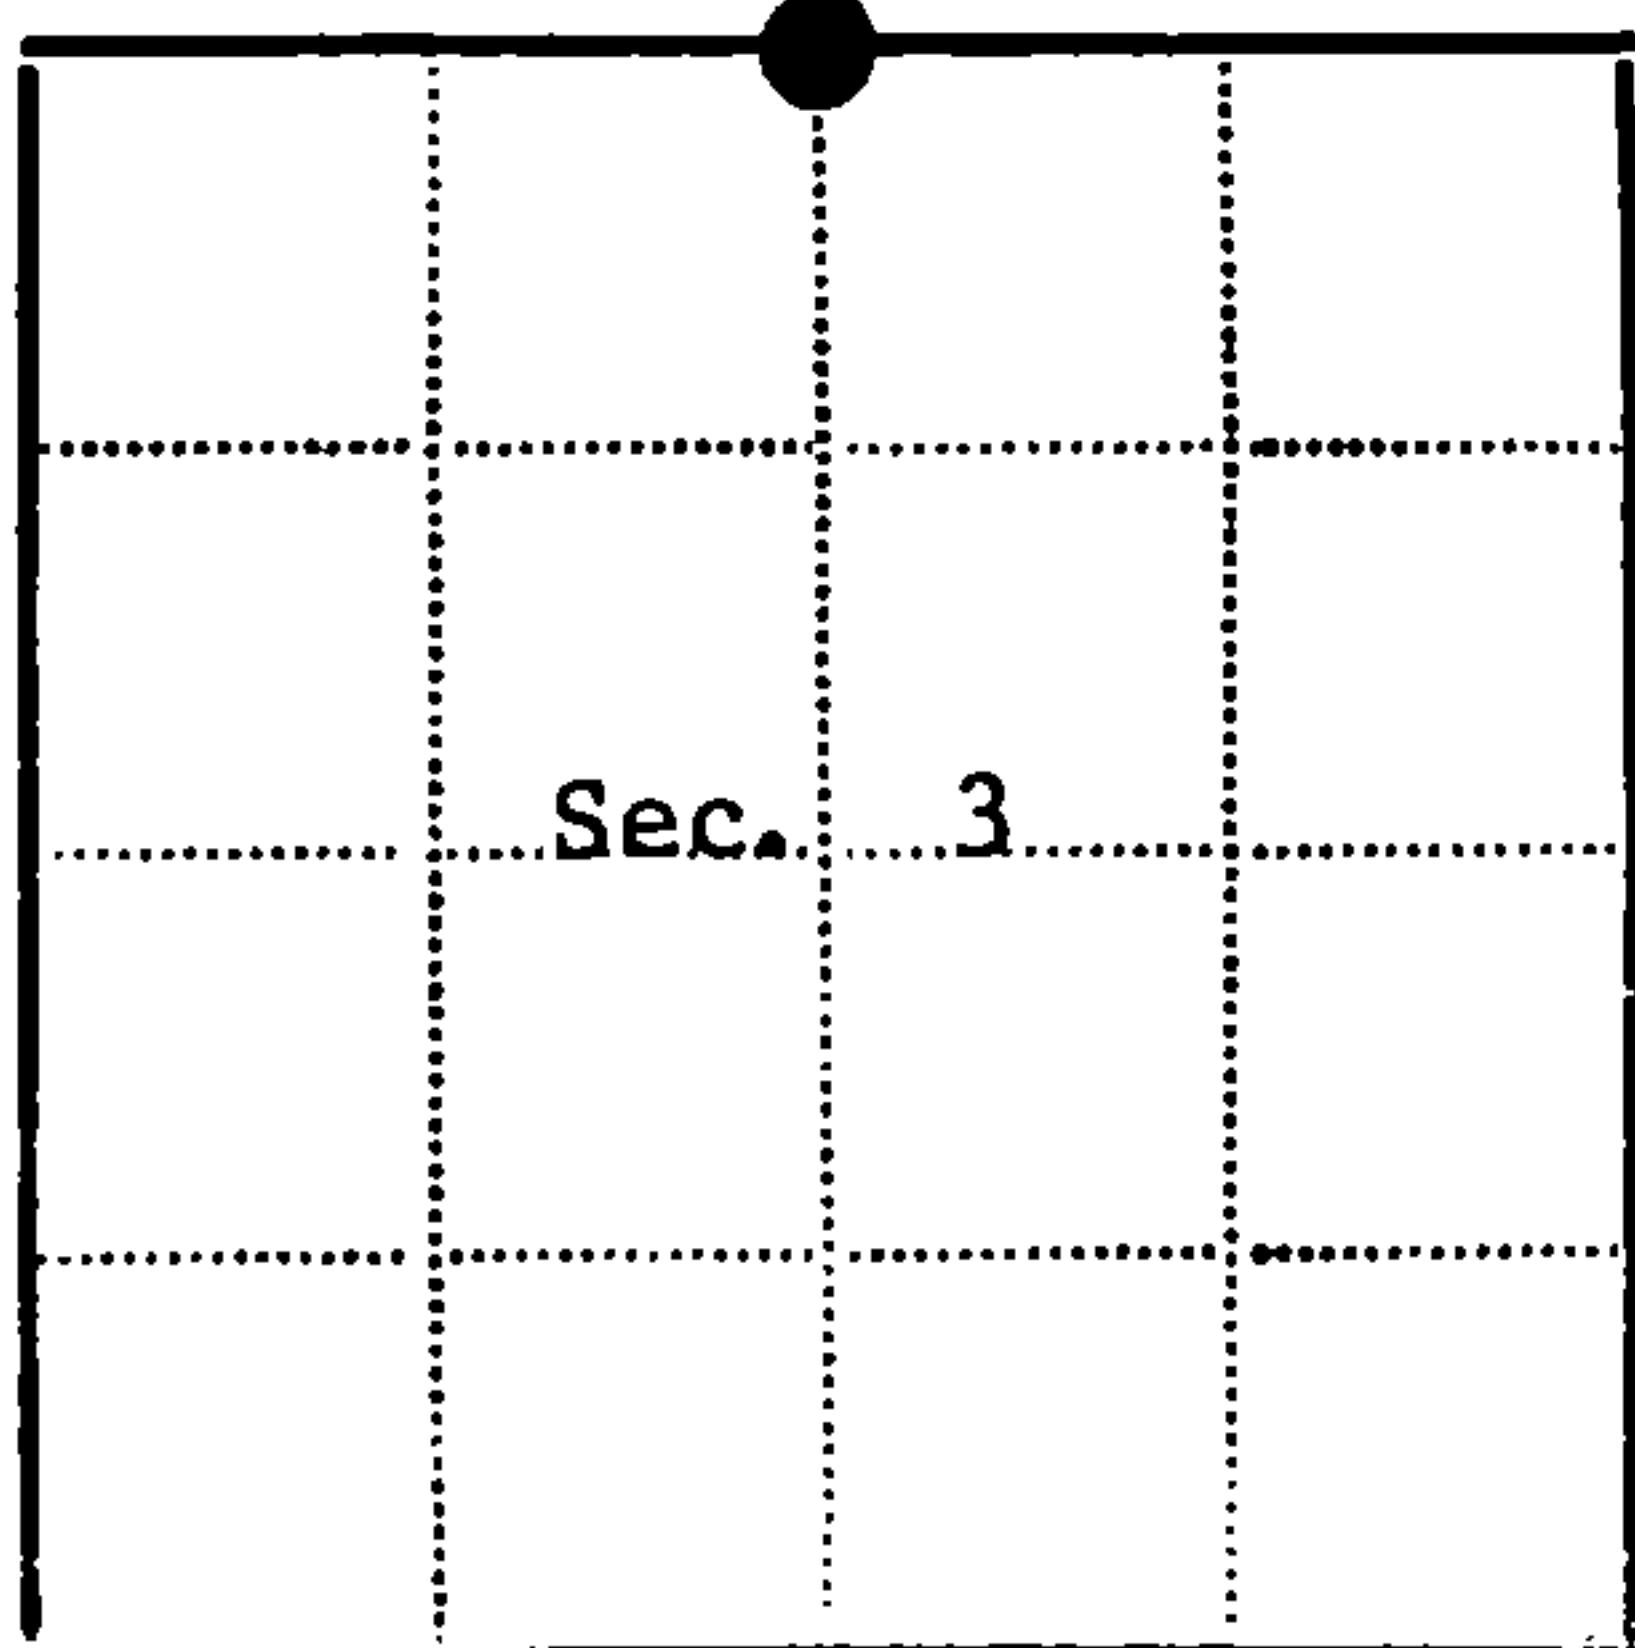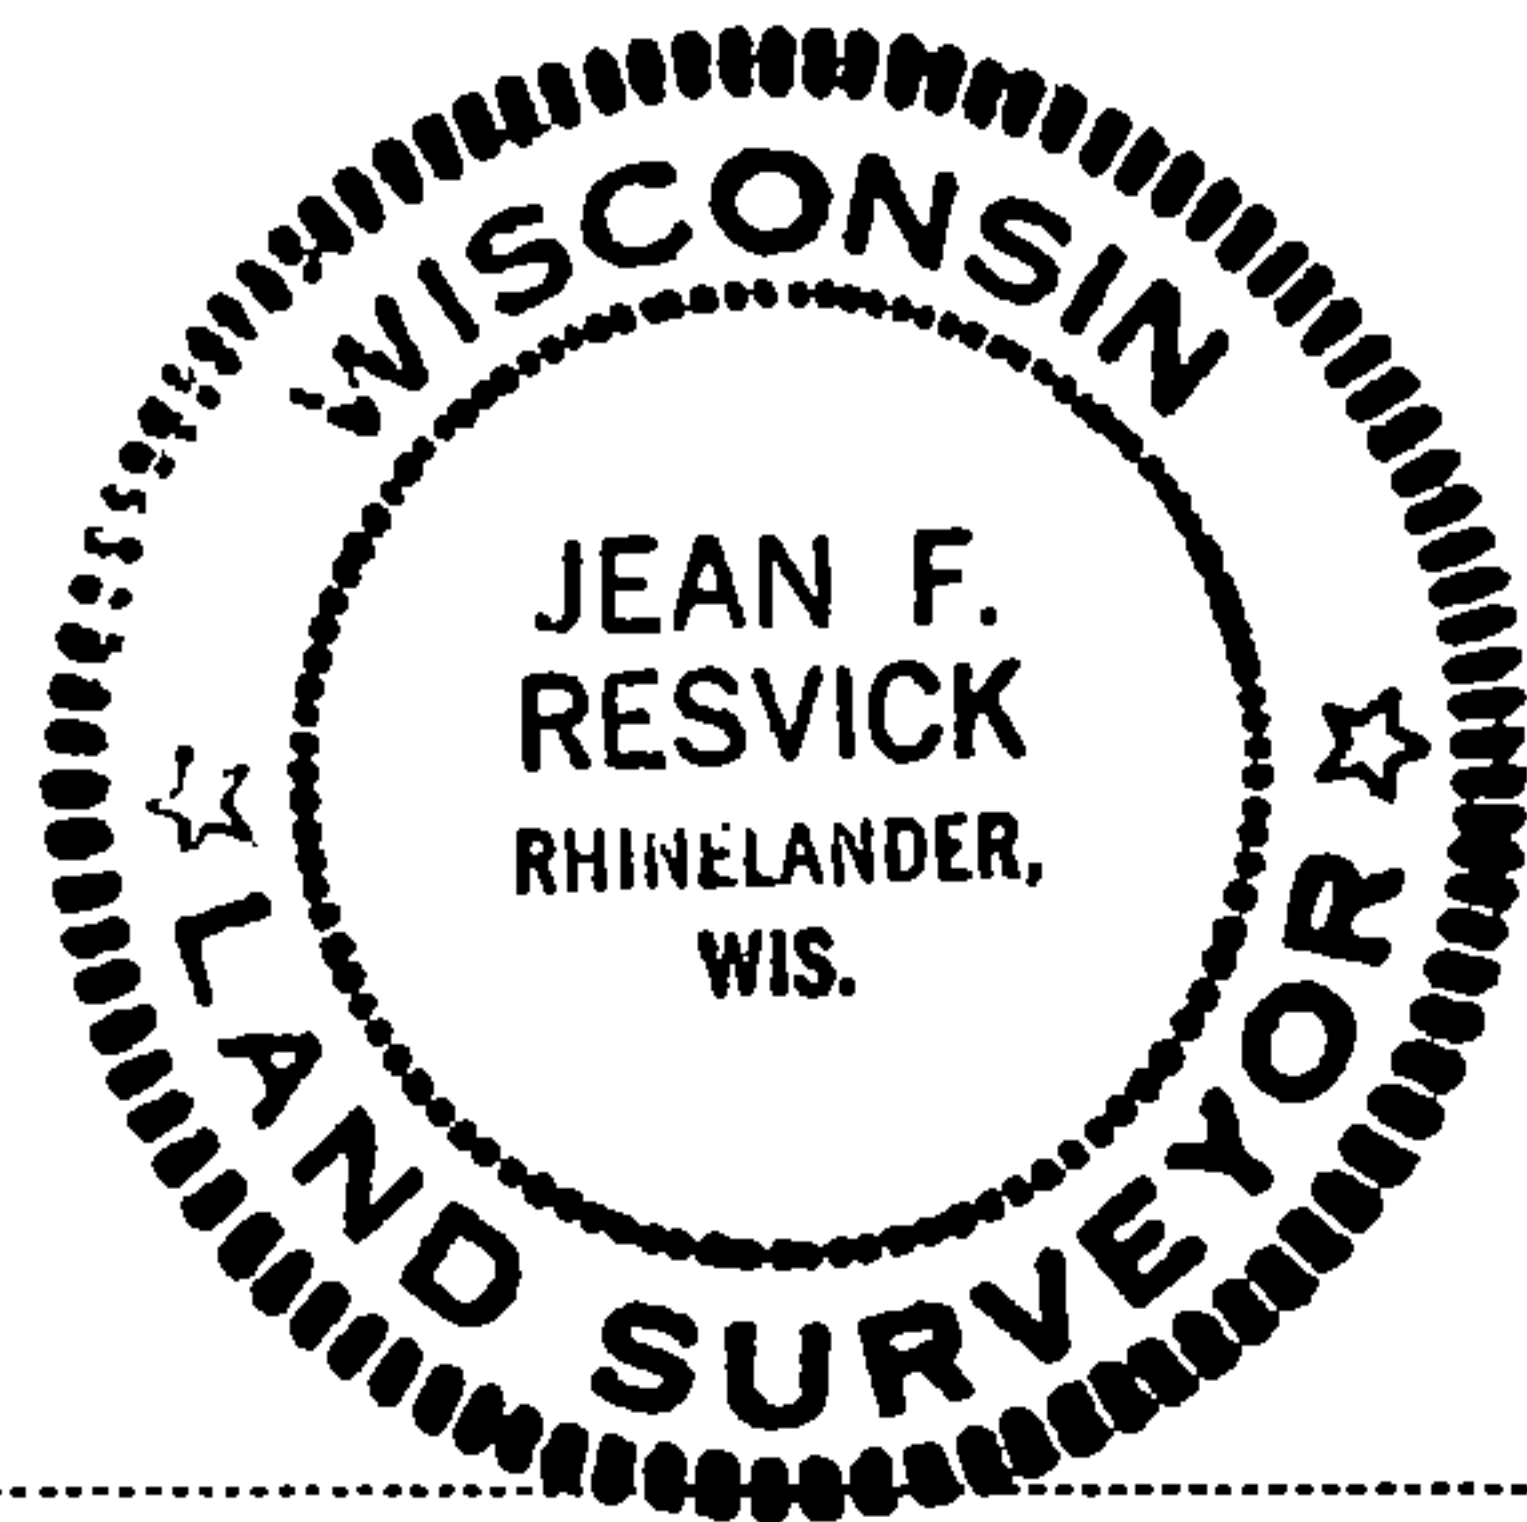

● - Corner monument restored
□ -

Resident witnesses.....

Dated at Rhinelander Wisconsin, this 9 day of August 1977.

Signature *Jean F. Resvick* Title Land Surveyor
(County Surveyor, Registered Land Surveyor, or other duly authorized official)

Surveyors Registration No. S-802 DOCUMENT NUMBER 113281

Office of Register of Deeds County of Forest

I hereby certify that the within instrument was filed in this office for record on the 13th day of February 1978, and was filed in Book No. Page No. of County Records.

Signature *Eugene Statorny* Title Register of Deeds

Township 34 North, Range 14 East, Section 3, Index No. A-15, Page No.

43514340020

A
15