


U. S. PUBLIC LAND SURVEY MONUMENT RECORD

INSTRUCTIONS:

This record shall show the location of the corner and shall include all of the following nine elements (a through i).

- (a) Identify the corner by reference to the U.S. public land survey system.
 ○ = Corner monument restored.

Section Corner to Sections 1, 2, 11 & 12,
 T.35N., R.15E., Forest County, Wisconsin.

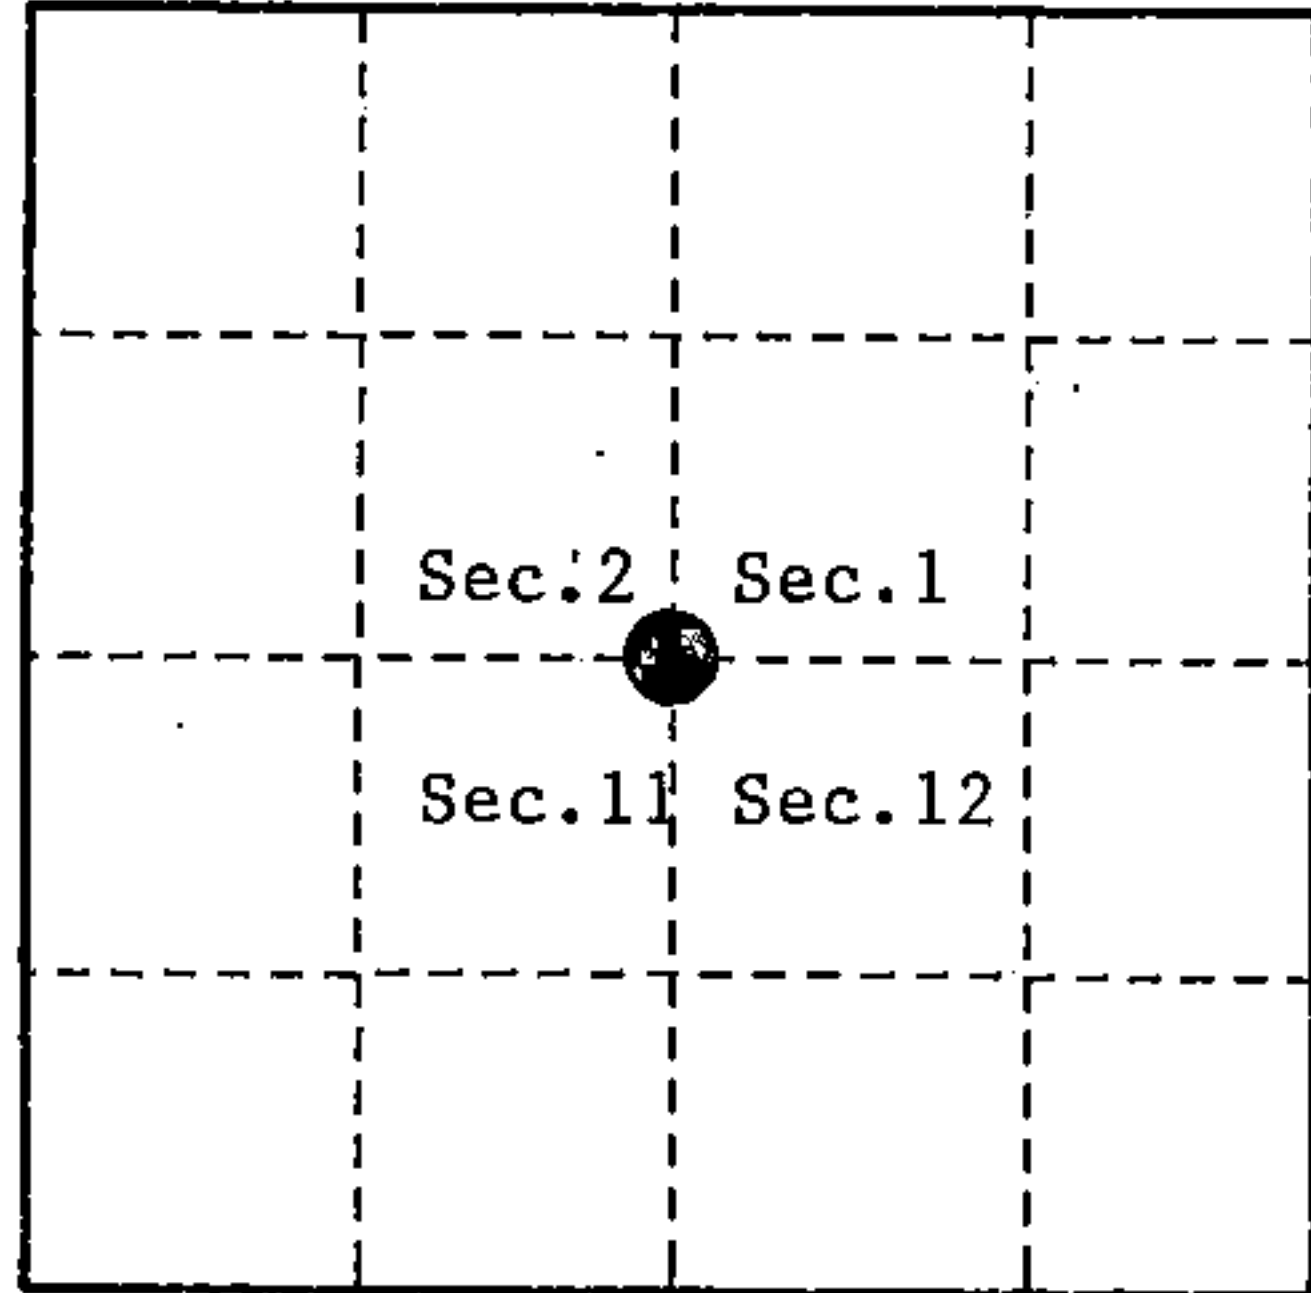

State Plane Coordinates
 Wisconsin North Zone
 137770.25668-N
 2334349.65012-E

Geographic Coordinates
 45-32-07.69045-N
 088-34-20.26291-W

- (b) Describe any record evidence, monument evidence, occupational evidence, testimonial evidence or any other material evidence you considered, and whether the monument was found or placed.

Original survey in 1859 by James McBride. Set wood post and the following bearing trees; Hemlock, 14", N.48°W., 42 links, Sugar, 14", N.60°E., 25 links, Sugar, 12", S.48°E., 11 links, Sugar, 16", S.51°W., 10 links.


In 1905 Nathan SMith, RLS, was at this corner, surveying in Sections 1 and 11. No new bearing trees were made.

In 1982, Milo Stefan, RLS, retraced Nathan Smith's survey through this corner area along Section Lines. Found post point on North edge of old grade. Distances fit with Smith's surveys. Set a 2" x 36" Aluminum Monument with tablet stamped to identify corner. Made new bearing trees; Basswood, 10", N.53°E., 8.47 feet, Sugar, 8", S.35°E., 45.90 feet, Sugar, 6", S.39°W., 39.60 feet, Sugar, 4", N.22°W, 60.35 feet, Steel Sign Post, North, 1.80 feet.

On 12-14-93, Alan Harrison, RLS, found the monument and bearing trees as set in 1982. Cut down the Northeast Basswood bearing tree for G.P.S. observations. Made a new bearing tree; Basswood, 10", N.25°E., 23.40 feet.

- (c) In the plan view drawing below, provide reference ties to at least 4 witness monuments, or, if the location is within a municipality, to at least 2 witness monuments. (witness monuments shall be made of concrete, natural stone, iron or other equally durable material.)

- (d) Show a plan view drawing depicting the relevant monuments and reference ties which is sufficient in detail to enable accurate relocation of the corner monument if the corner monument is disturbed. Indicate north.
1. 2" x 36" Aluminum Monument with tablet stamped to identify corner.
 2. Basswood, 10", N.25°E., 23.40 feet.
 3. Sugar, 8", S.35°E., 45.90 feet.
 4. Sugar, 6", S.39°W., 39.60 feet.
 5. Sugar, 4", N.22°W., 60.35 feet.
 6. Steel Sign Post, North, 1.80 feet.

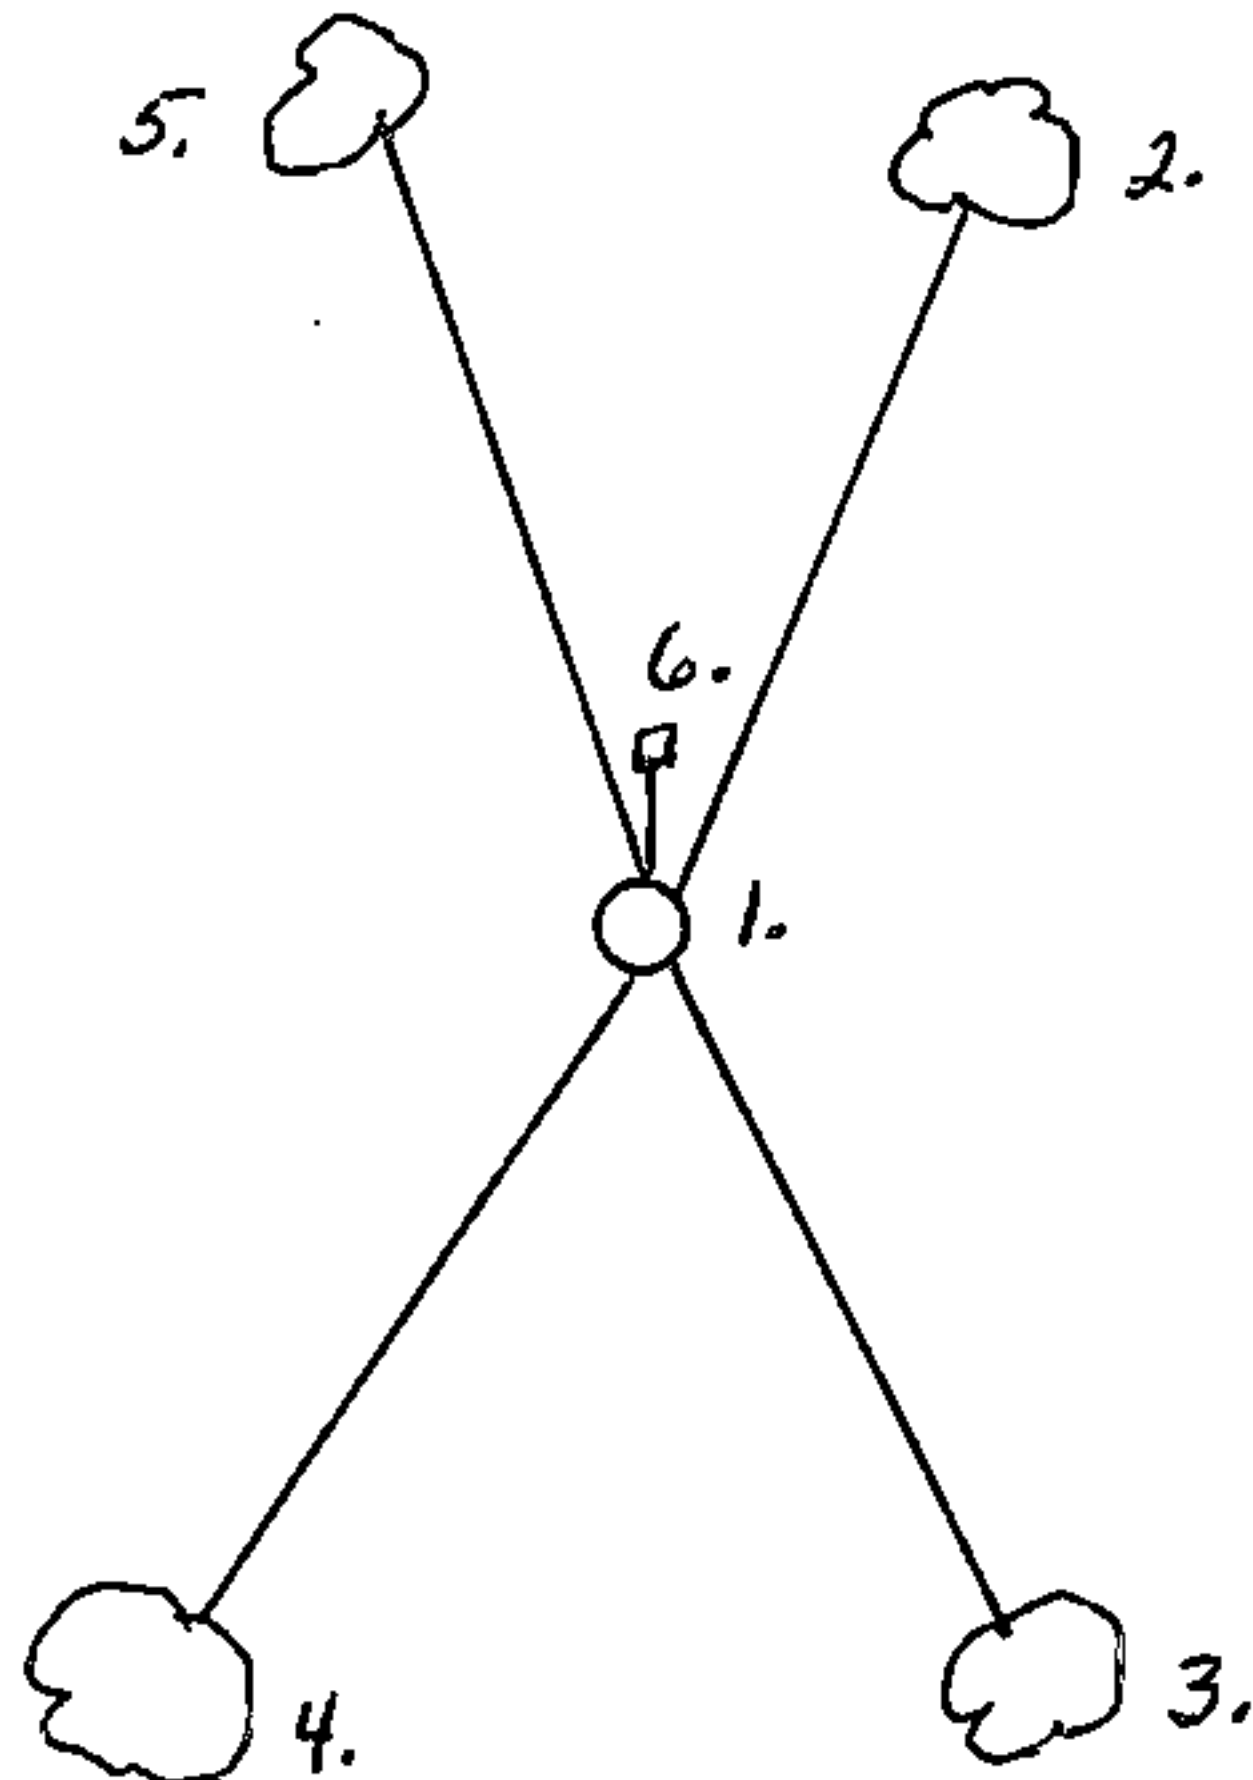

(e) Describe any material discrepancy between the location of the corner as restored or reestablished and the location of that corner as previously restored or reestablished by distance and direction. Show the discrepancy on the plan view drawing under (d), above. Show the distances between the corner as previously restored or reestablished and (1) the corner as restored or reestablished, and (2) to at least 2 of the witness monuments shown on the drawing in (d), above.

None.

(f) Was the corner restored through acceptance of (1) an obliterated evidence location, or, (2) a found perpetuated location?

(2)


(g & h) Was the corner reestablished through lost corner proportionate methods? If so, show the method, including the directions and distances to other public land survey corners used as evidence or used for proportioning in determining the corner location?

No.

REGISTER'S OFFICE
Forest County, Wis.

Received for record this 23rd day
of March, A.D., 1994 at
9:00 o'clock A.M. and recorded
in Vol. Casey Restorations
page 35-15-E-7

Paul C. Little, Deputy
Register of Deeds

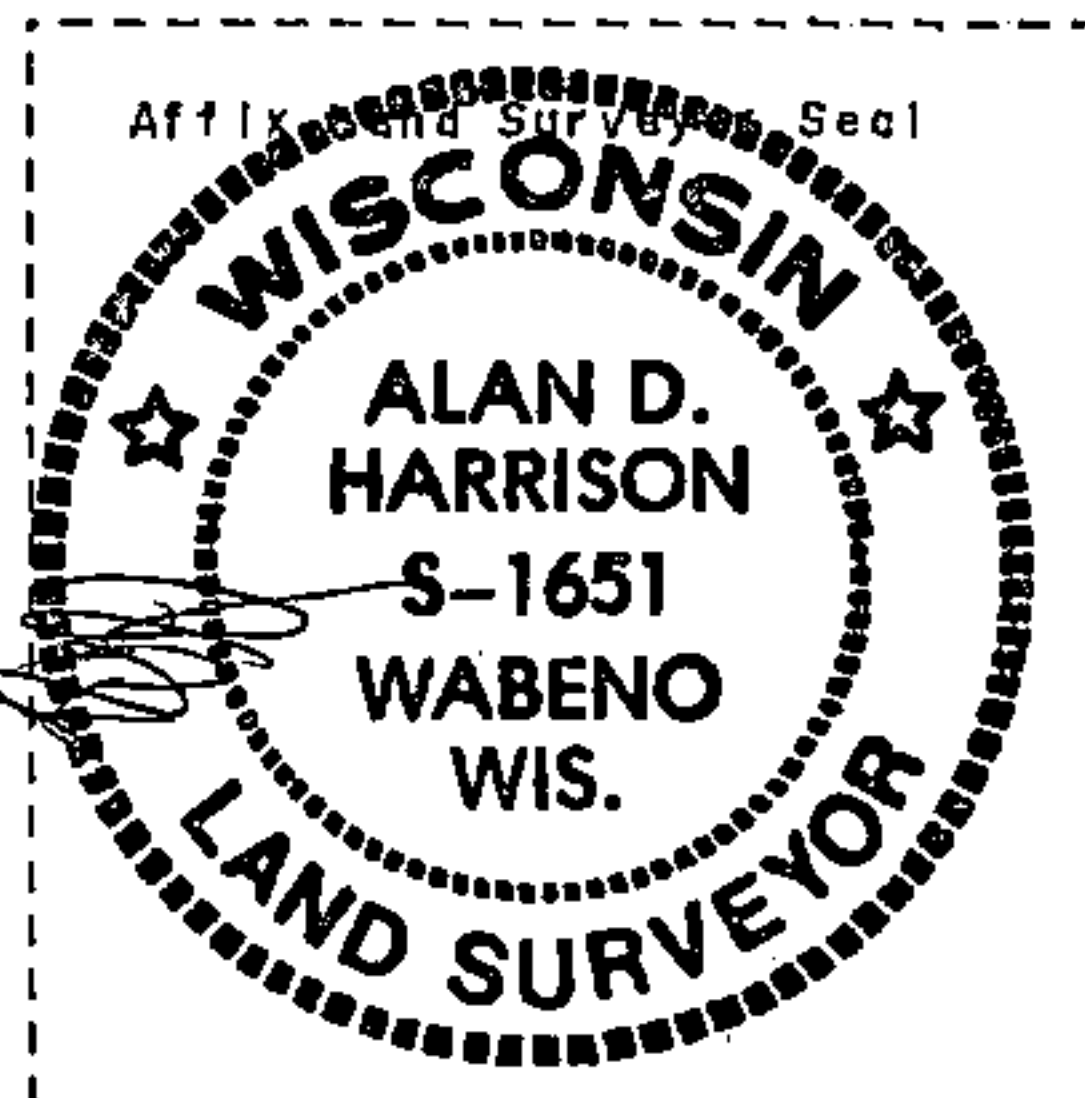

(1) I, Alan D. Harrison

(type or print name) certify that the corner location shown on this record was determined by me or under my direction and control and that this U.S. Public Land Survey Monument Record is correct and complete to the best of my knowledge and belief.

Alan D. Harrison 10/26/94
Signature Date

CERTIFICATE READY FOR FILING:


Sue Vap
District Ranger

U. S. PUBLIC LAND SURVEY MONUMENT RECORD

INSTRUCTIONS: This record shall show the location of the corner and shall include all of the following nine elements (a through i).

- (a) Identify the corner by reference to the U.S. public land survey system.
- = Corner monument restored.

Corner to Sections 1, 2, 11, and 12, T.35N., R.15E.

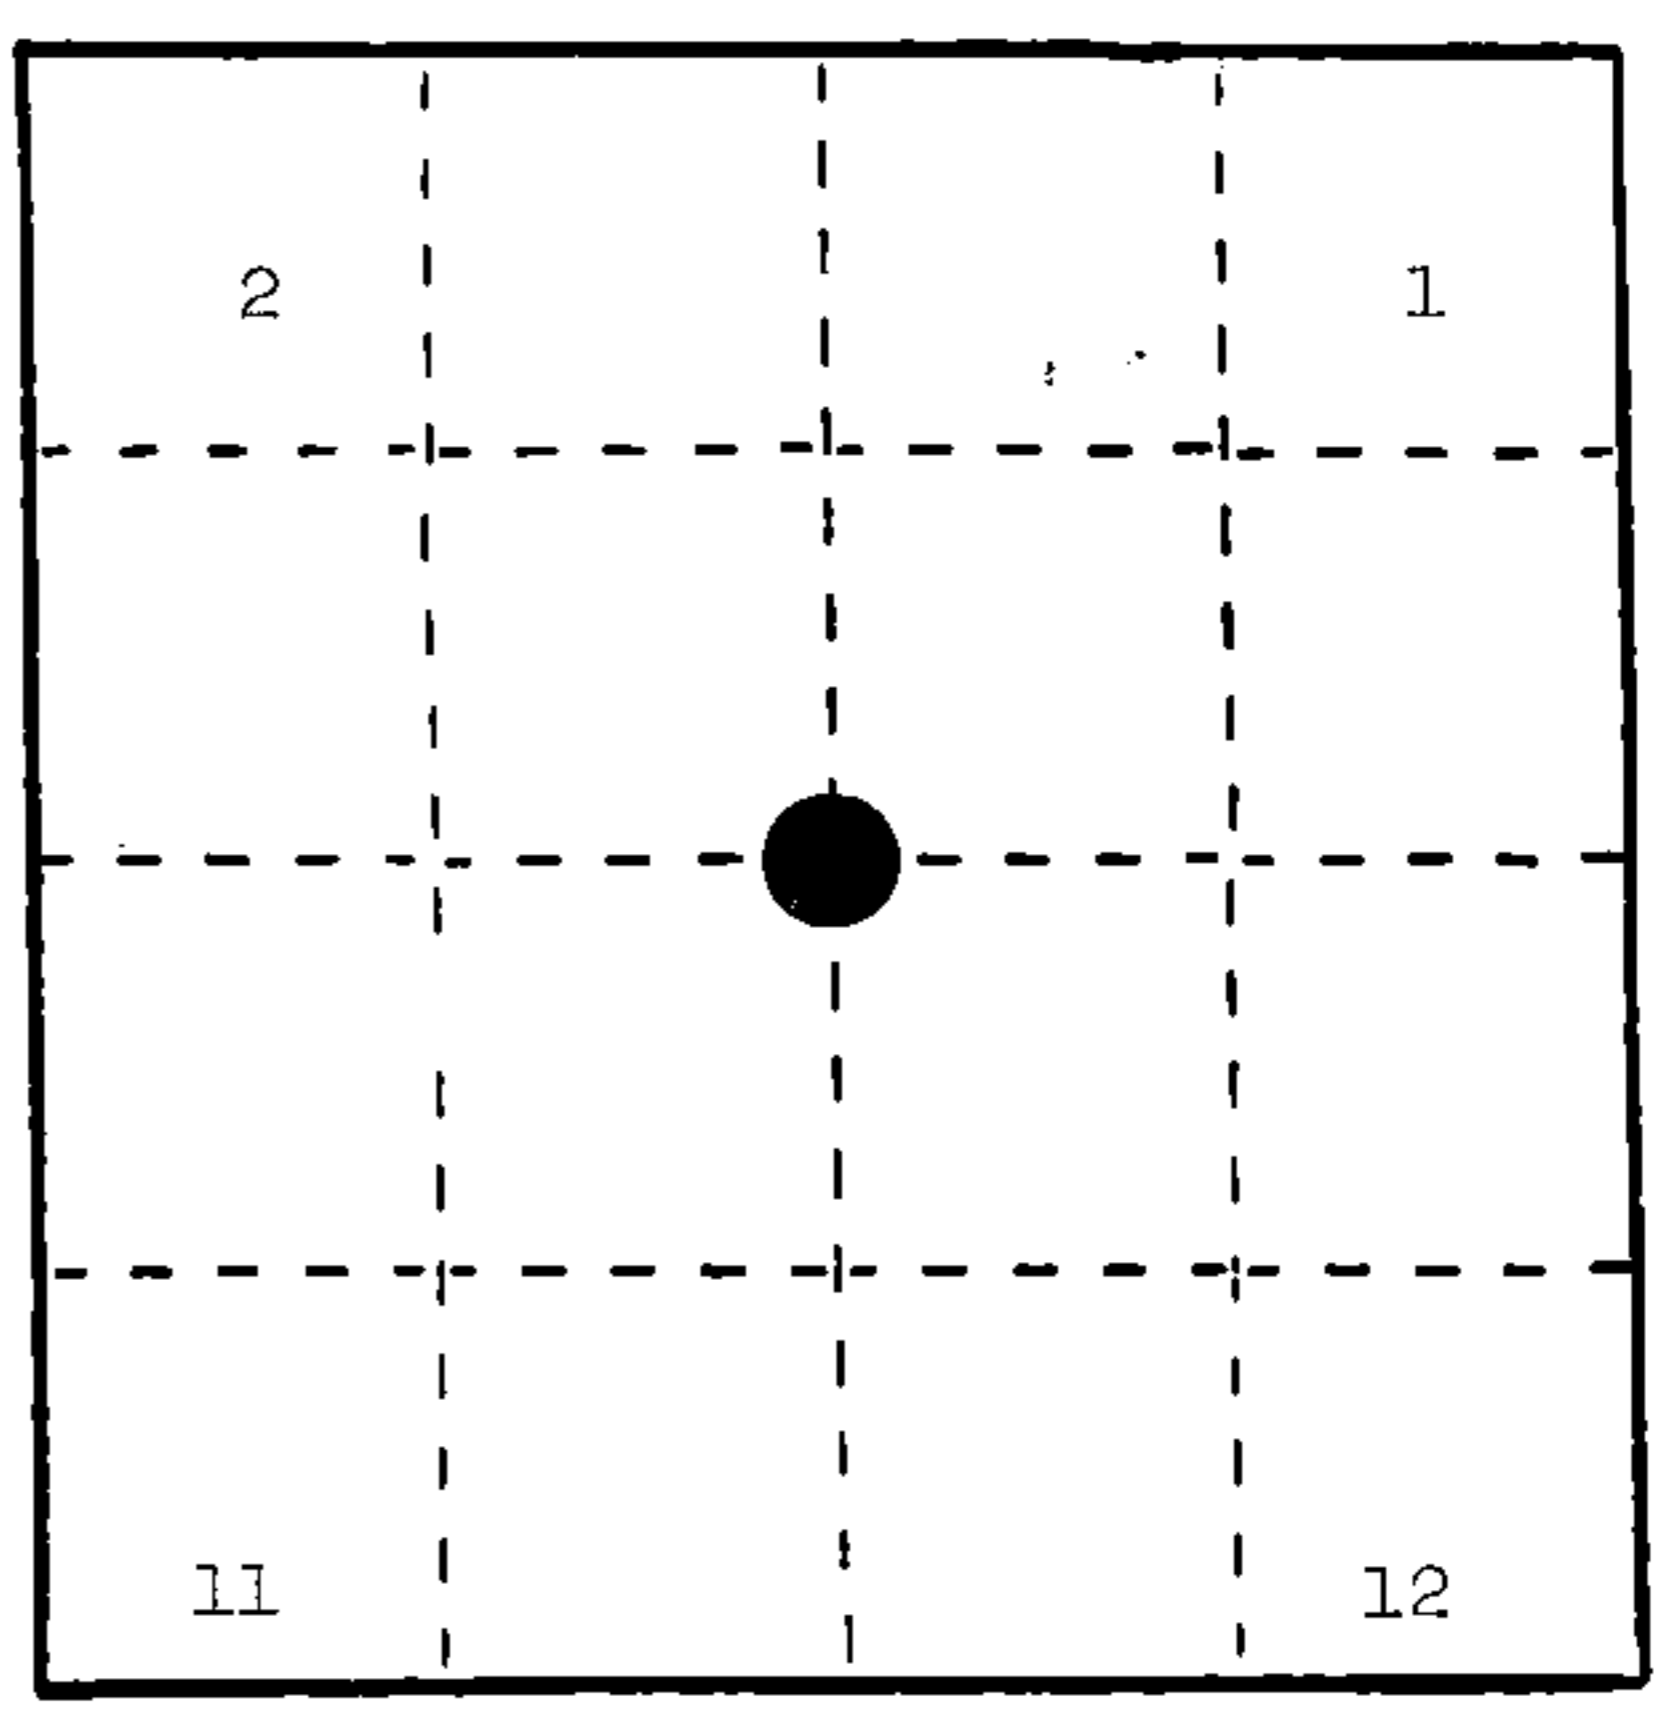

REGISTER'S OFFICE }
 Forest County, Wis. }
 Received for record this 14th day
 of March A.D., 1986 at
10:25 o'clock A.M. and recorded
 in Vol. CORNER RESTORATIONS
 page E-21
Paul Aschenbrenner
 Register of Deeds

(b) Describe any record evidence, monument evidence, occupational evidence, testimonial evidence or any other material evidence you considered, and whether the monument was found or placed.


In 1859, James McBride set wood post and made the following BTs: Hemlock, 14", N.48°W., 42 links; Sugar, 14", N.60°E., 25 links; Sugar, 12", S.48°E., 11 links; Sugar, 16", S.51°W., 10 links.

In 1905, N. Smith was at this corner when surveying in Sections 1 and 11. No new BTs added.

In 1982, Milo Stefan retraced Smith's survey through this corner area along section lines. Found post point on north edge of old grade. Distances fit with Smith's surveys. Set monument and made references.

(c) In the plan view drawing below, provide reference ties to at least 4 witness monuments, or, if the location is within a municipality, to at least 2 witness monuments. (Witness monuments shall be made of concrete, natural stone, iron or other equally durable material.) Describe witness monuments.

- (d) Show a plan view drawing depicting the relevant monuments and reference ties which is sufficient in detail to enable accurate relocation of the corner monument if the corner monument is disturbed. Indicate north.
1. 2" x 36" aluminum monument stamped to identify the corner location.
 2. Basswood, 10", N.53°E., 8.47 feet
 3. Sugar, 8", S.35°E., 45.90 feet
 4. Sugar, 6", S.39°W., 39.60 feet
 5. Sugar, 4", N.22°W., 60.35 feet
 6. Steel Sign Post, North, 1.80 feet

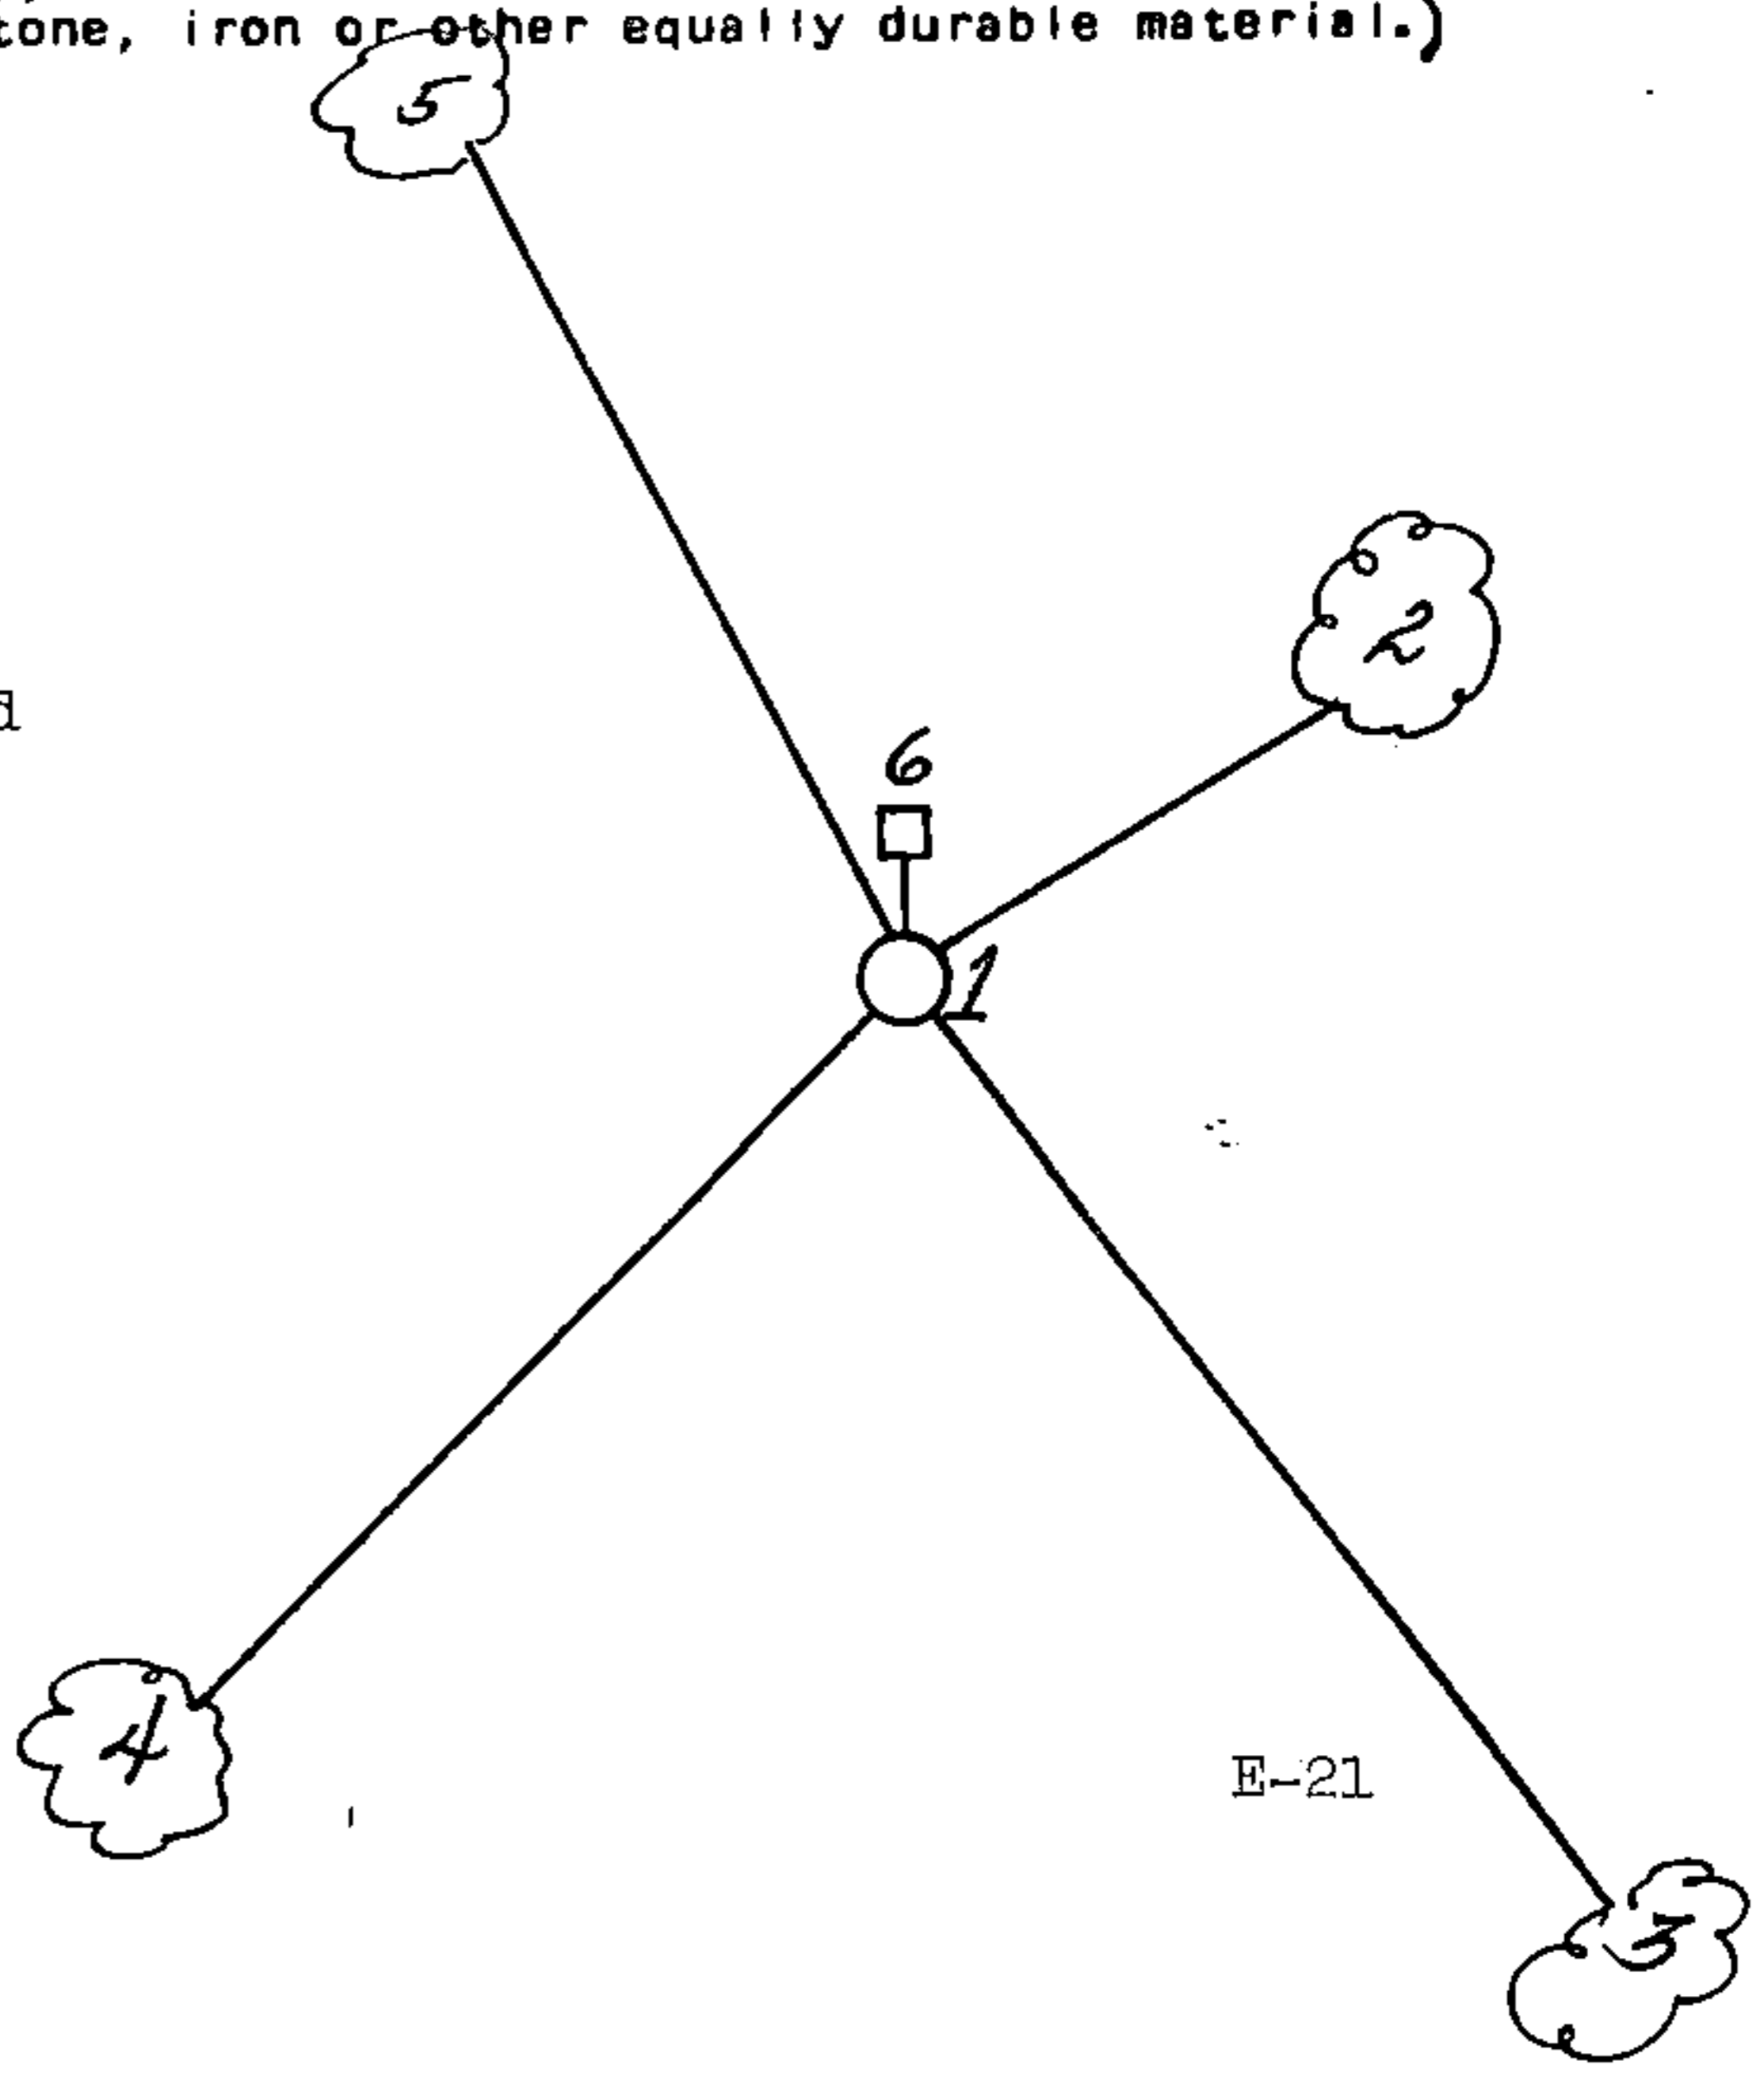

(e) Describe any material discrepancy between the location of the corner as restored or reestablished and the location of that corner as previously restored or reestablished by distance and direction. Show the discrepancy on the plan view drawing under (d), above. Show the distances between the corner as previously restored or reestablished and (1) the corner as restored or reestablished, and (2) to at least 2 of the witness monuments shown on the drawing in (d), above.

None.

(f) Was the corner restored through acceptance of (1) an obliterated evidence location, or, (2) a found perpetuated location?

(1) an obliterated evidence location.

(g&h) Was the corner reestablished through lost corner proportionate methods? If so, show the method, including the directions and distances to other public land survey corners used as evidence or used for proportioning in determining the corner location?

No.

Affix Land Surveyor Seal



(i) I, Milo E. Stefan
(type or print name) certify that the corner location shown on this record was determined by me or under my direction and control and that this U.S. Public Land Survey Monument Record is correct and complete to the best of my knowledge and belief.

Milo E. Stefan
Signature

3/11/86
Date