

138178


U. S. PUBLIC LAND SURVEY MONUMENT RECORD

INSTRUCTIONS : This record shall show the location of the corner and shall include all of the following nine elements (a through i).

(a) Identify the corner by reference to the U.S. public land survey system.

● = Corner monument restored.

Section Corner common to Sections 7, 8, 17 & 18, T35N, R15E, 4th P.M.

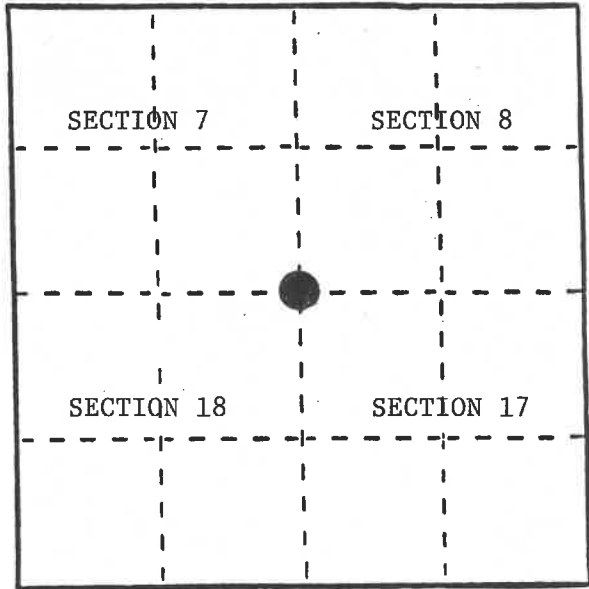

REGISTER'S OFFICE
Forest County, Wis.
Received for record this 16th day
of Sept. A.D., 1989 at
10:25 o'clock A.M. and recorded
in Vol. J-5 **CORNER RESTORATIONS**
page 5-5
Paul Ackenhauer
Register of Deeds

(b) Describe any record evidence, monument evidence, occupational evidence, testimonial evidence or any other material evidence you considered, and whether the monument was found or placed.

In 1859, James McBride established this corner and set a wood post and BTs:
8" Cedar, N17°E, 34 links 12" Sugar, S47°E, 30 links
12" Sugar, S8°W, 45 links 18" Hemlock, N82°W, 25 links


6/8/34 - 874 calls old snag with marking and placed a location poster on fence post. No information on where snag was or where corner may have been from location poster.

4/18/89 - Milo E. Stefan searched area of road intersection and came up with the 1934 location poster with fence northerly, all down now. Old roads east, west and south. I accept the road centerline and intersection of the old fence line northerly as the best evidence remaining of this corner location and restore this corner.

(c) In the plan view drawing below, provide reference ties to at least 4 witness monuments, or, if the location is within a municipality, to at least 2 witness monuments. (Witness monuments shall be made of concrete, natural stone, iron or other equally durable material.) Describe witness monuments.

(d) Show a plan view drawing depicting the relevant monuments and reference ties which is sufficient in detail to enable accurate relocation of the corner monument if the corner monument is disturbed. Indicate north.

- 1) 3/4" x 24" Steel Bar, 8" below surface of road.
- 2) 6" Basswood, S78°E, 96.88'
- 3) 5" White Birch, S52°W, 45.14'
- 4) 14" Red Pine, N69°W, 138.94'
- 5) 14" Red Pine, N11°W, 172.43'
- 6) 2 1/2" x 36" Aluminum Monument for Witness Corner
- 7) Steel Sign Post, NW of W.C. .65'

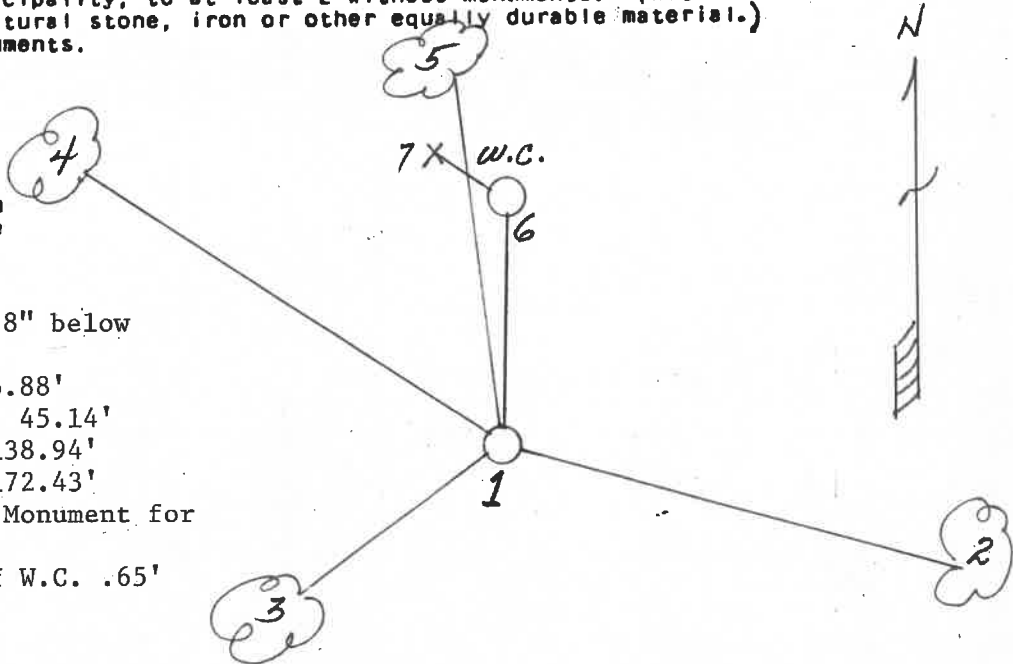

43515070000

(e) Describe any material discrepancy between the location of the corner as restored or reestablished and the location of that corner as previously restored or reestablished by distance and direction. Show the discrepancy on the plan view drawing under (d), above. Show the distances between the corner as previously restored or reestablished and (1) the corner as restored or reestablished, and (2) to at least 2 of the witness monuments shown on the drawing in (d), above.

None

(f) Was the corner restored through acceptance of (1) an obliterated evidence location, or, (2) a found perpetuated location?

An obliterated location.

(g&h) Was the corner reestablished through lost corner proportionate methods? If so, show the method, including the directions and distances to other public land survey corners used as evidence or used for proportioning in determining the corner location?

Affix Land Surveyor Seal



Milo E. Stefan

(i) I, Milo E. Stefan
(Type or print name) certify that the corner location shown on this record was determined by me or under my direction and control and that this U.S. Public Land Survey Monument Record is correct and complete to the best of my knowledge and belief.

Milo E. Stefan
Signature

6/24/89
Date

Certificate ready for filing:

Dale S. Staeger
District Ranger