

U. S. PUBLIC LAND SURVEY MONUMENT RECORD

INSTRUCTIONS:


This record shall show the location of the corner and shall include all of the following nine elements (a through i).

- (a) Identify the corner by reference to the U.S. public land survey system.  
 ○ = Corner monument restored.

Quarter Corner between Sections 11 and 12,  
 T.35N., R15E., Forest County, Wisconsin

State Plane Coordinates  
 Wisconsin North Zone  
 N - 135163.35417  
 E - 2334402.00403

Geographic Coordinates  
 N - 45 - 31 - 41.94811  
 W - 088 - 34 - 20.18582

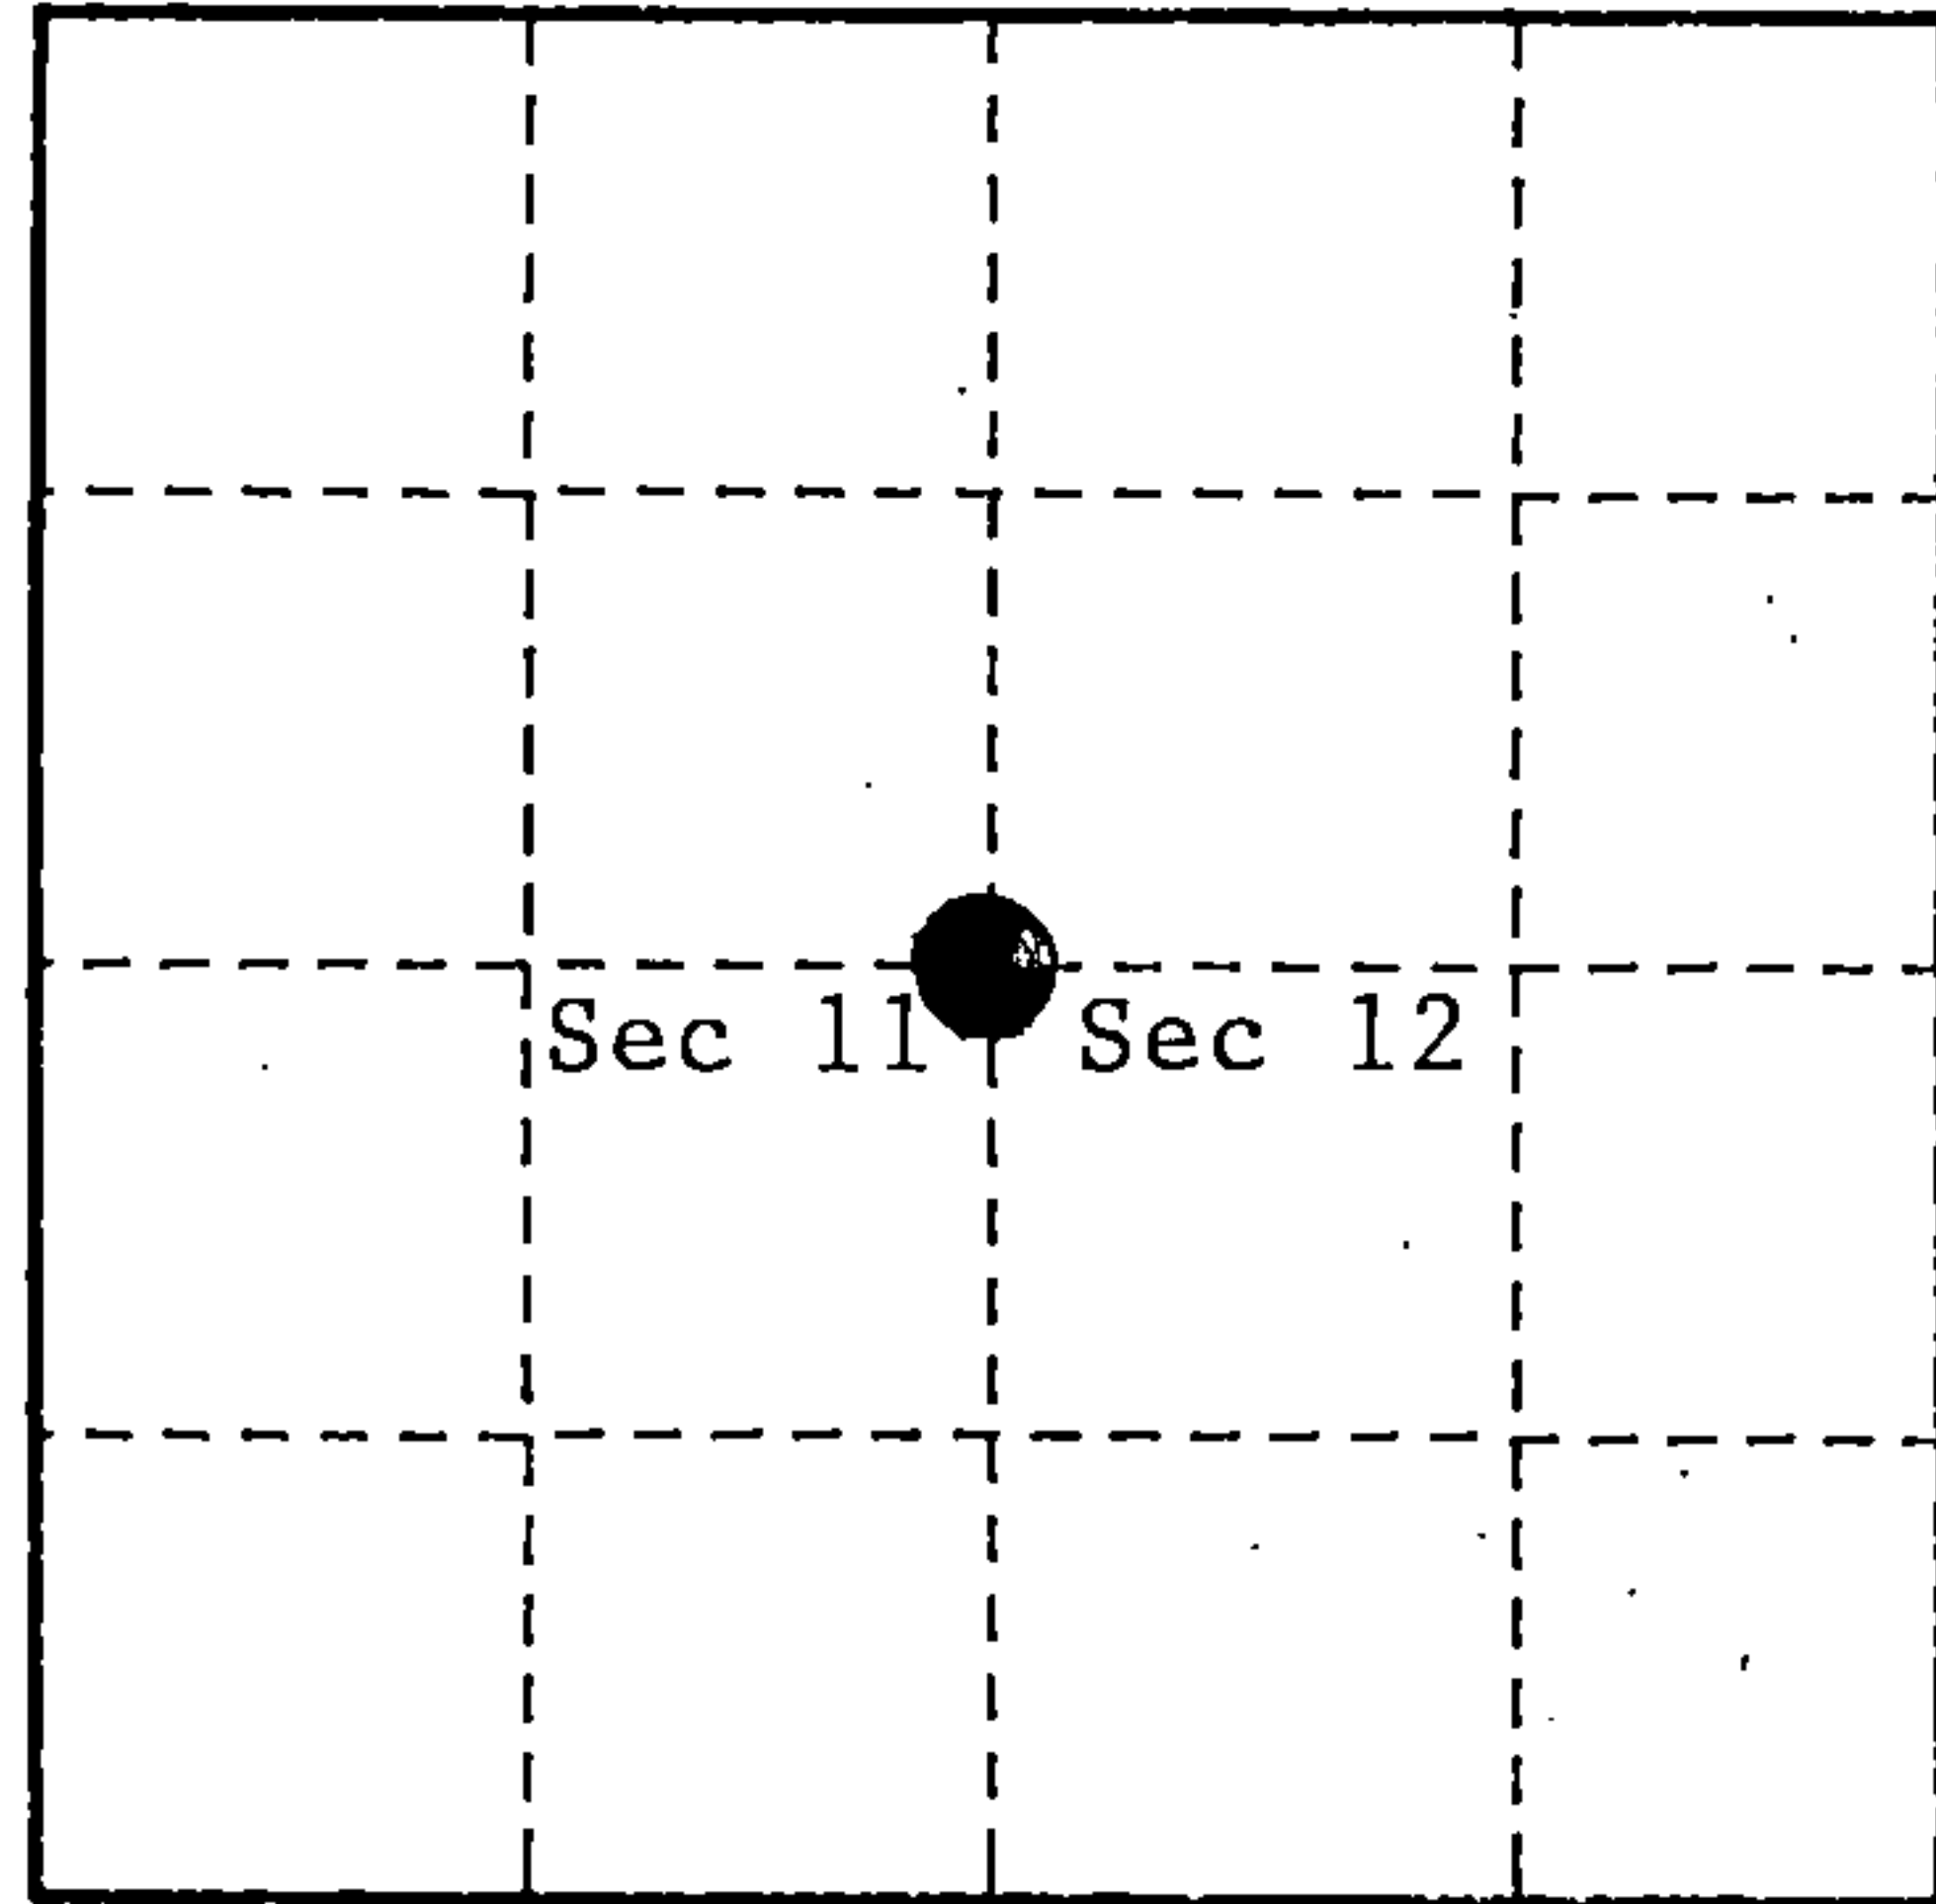

- (b) Describe any record evidence, monument evidence, occupational evidence, testimonial evidence or any other material evidence you considered, and whether the monument was found or placed.

Original Survey in 1859 by James McBride. Set wood post and the following B.T.'s; Sugar, 16", N.51°E., 13 lks., Sugar, 24", S.50°W., 20 lks.

In 1904 Nathan Smith found an original B.T. broken off. Marks plain. He measured 39.74½ chains from the SE Section Corner of Section 11.


In 1982 Milo Stefan, RLS, found a mound of stone at the corner area. No other evidence located.

In 1984, Alan Harrison, RLS, found mound of stone as found by Stefan in 1982. According to Phil Gentz, adjacent landowner, the rock pile has been there for many years and used as the corner. Distance from rock pile South to Section Corner is 39.61 chains vs. 39.74½ chains measured by Nathan Smith in 1904. In center of rock pile set a 2" X 36" aluminum monument and made bearing trees as noted below.

- (c) In the plan view drawing below, provide reference ties to at least 4 witness monuments, or, if the location is within a municipality, to at least 2 witness monuments. (witness monuments shall be made of concrete, natural stone, iron or other equally durable material.)

- (d) Show a plan view drawing depicting the relevant monuments and reference ties which is sufficient in detail to enable accurate relocation of the corner monument if the corner monument is disturbed. Indicate north.

1. 2½" X 36" aluminum monument with tablet stamped to identify corner.
2. Basswood, 14", N.13°E., 35.19 feet.
3. Sugar, 13", S.52°E., 30.91 feet.
4. Sugar, 11", S.83°W., 38.86 feet.
5. Steel Sign Post, Northeast, 1.90 feet.

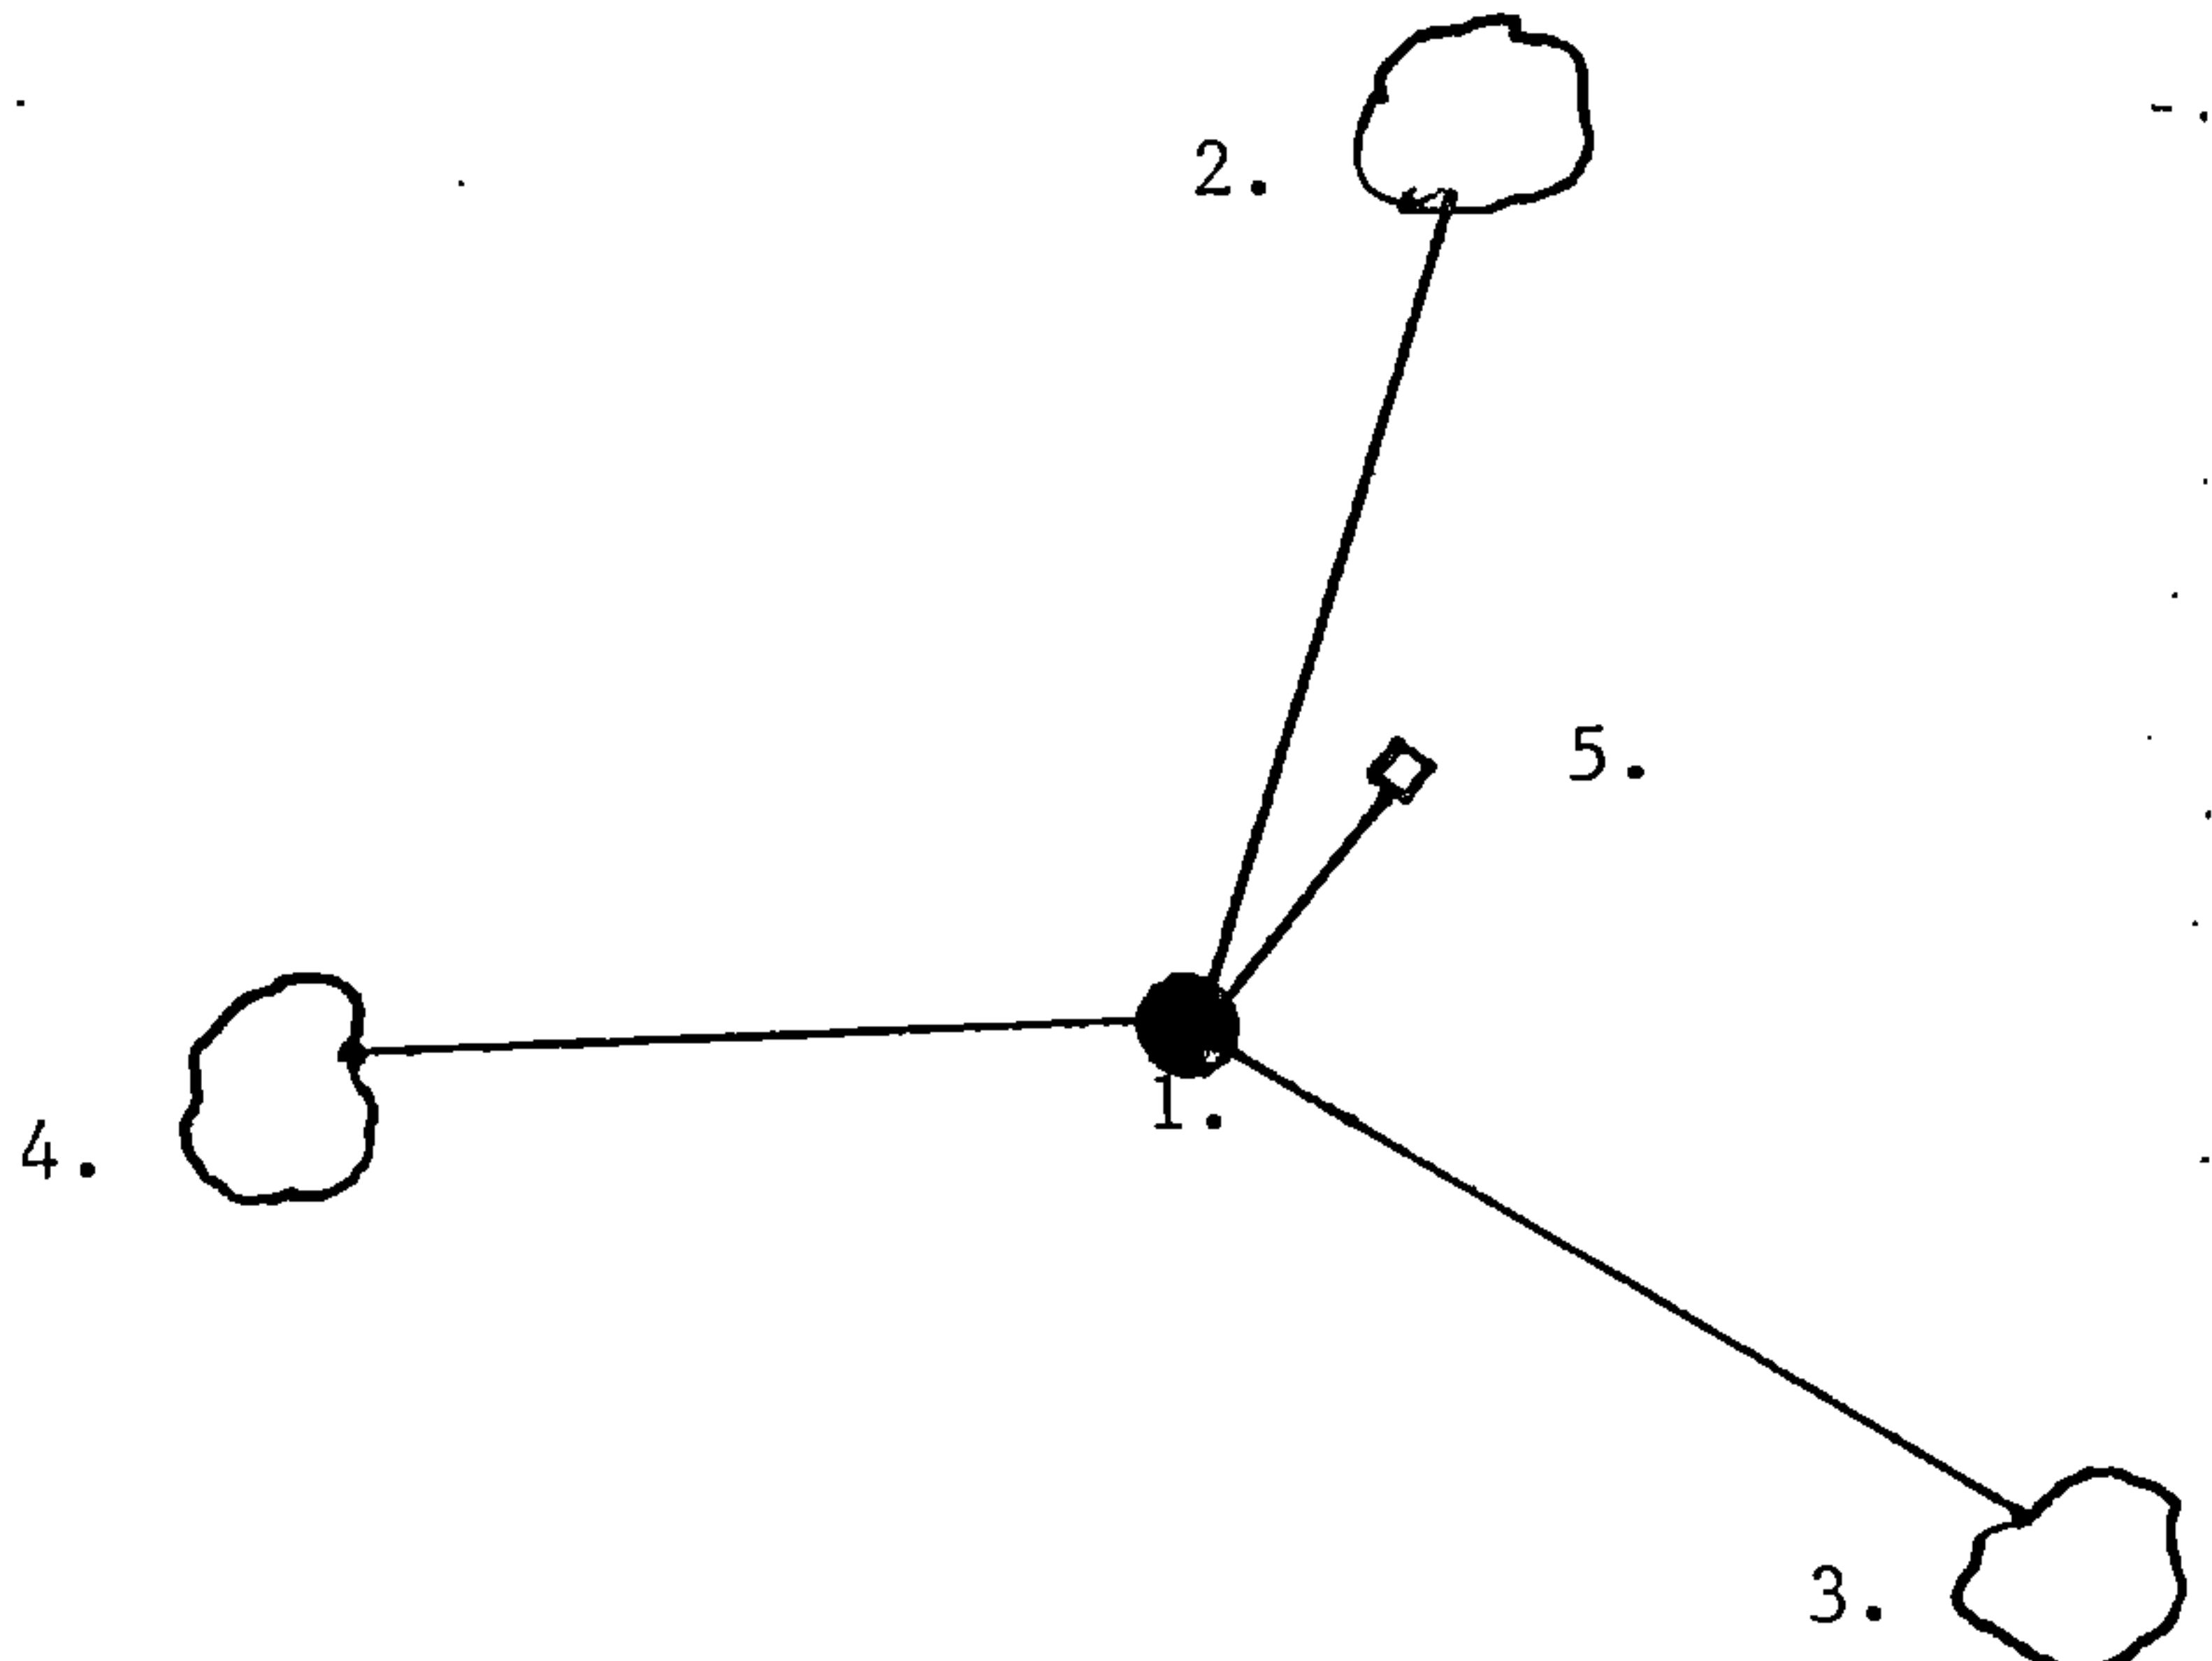

(e) Describe any material discrepancy between the location of the corner as restored or reestablished and the location of that corner as previously restored or reestablished by distance and direction. Show the discrepancy on the plan view drawing under (d), above. Show the distances between the corner as previously restored or reestablished and (1) the corner as restored or reestablished, and (2) to at least 2 of the witness monuments shown on the drawing in (d), above.


None

(f) Was the corner restored through acceptance of (1) an obliterated evidence location, or, (2) a found perpetuated location?


(1.)

(g & h) Was the corner reestablished through lost corner proportionate methods? If so, show the method, including the directions and distances to other public land survey corners used as evidence or used for proportioning in determining the corner location?

No

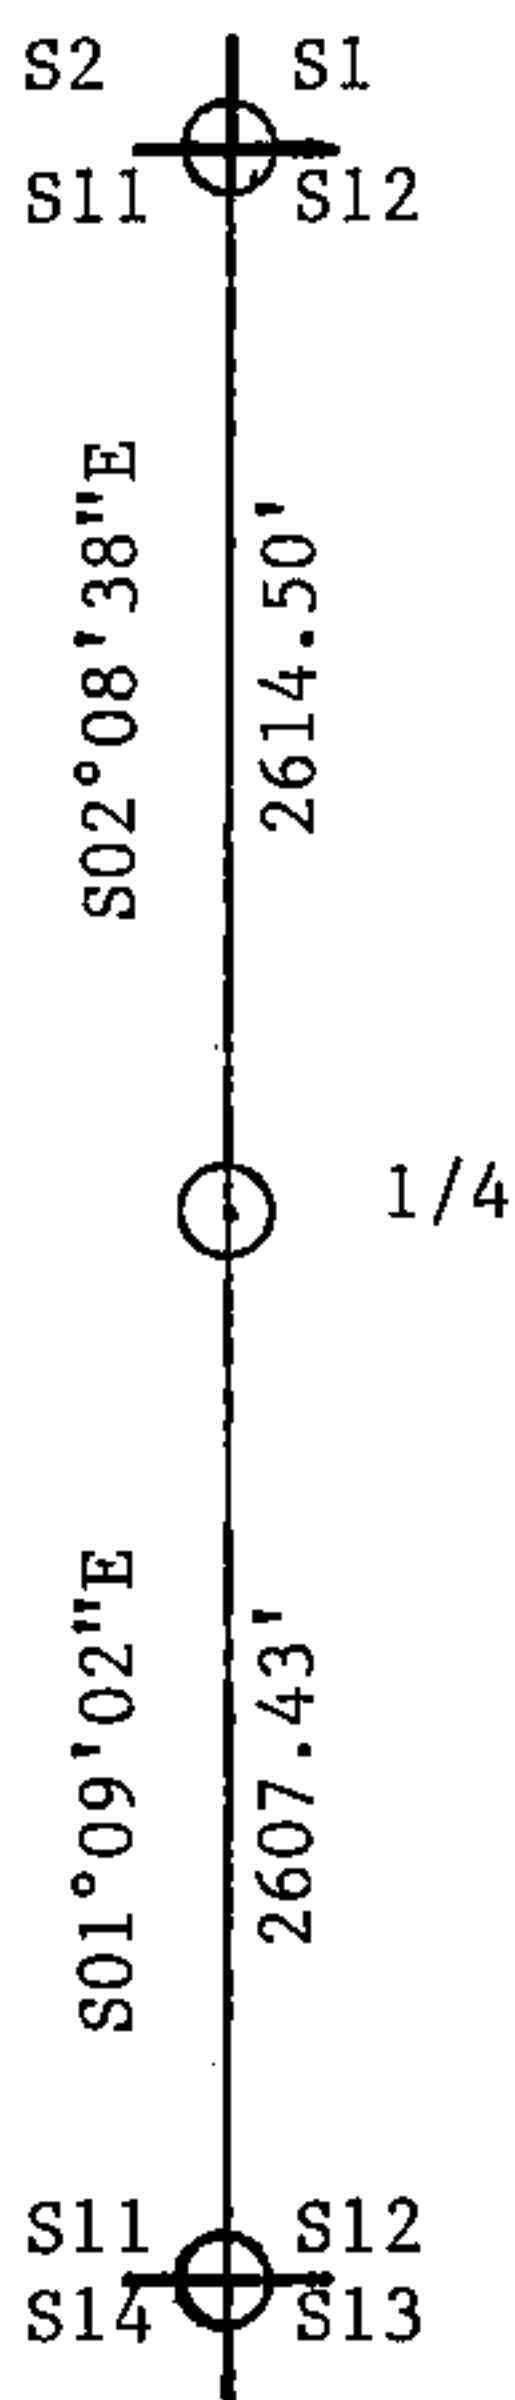

REGISTER'S OFFICE  
 Forest County, Wis.  
 Received for record this 10<sup>th</sup> day  
 of May A.D., 19 95 at  
8:30 o'clock A.M. and recorded  
 in Vol Case Restorations  
 page 55-15, 6-21  
*Paul Chittenden*  
 Register of Deeds

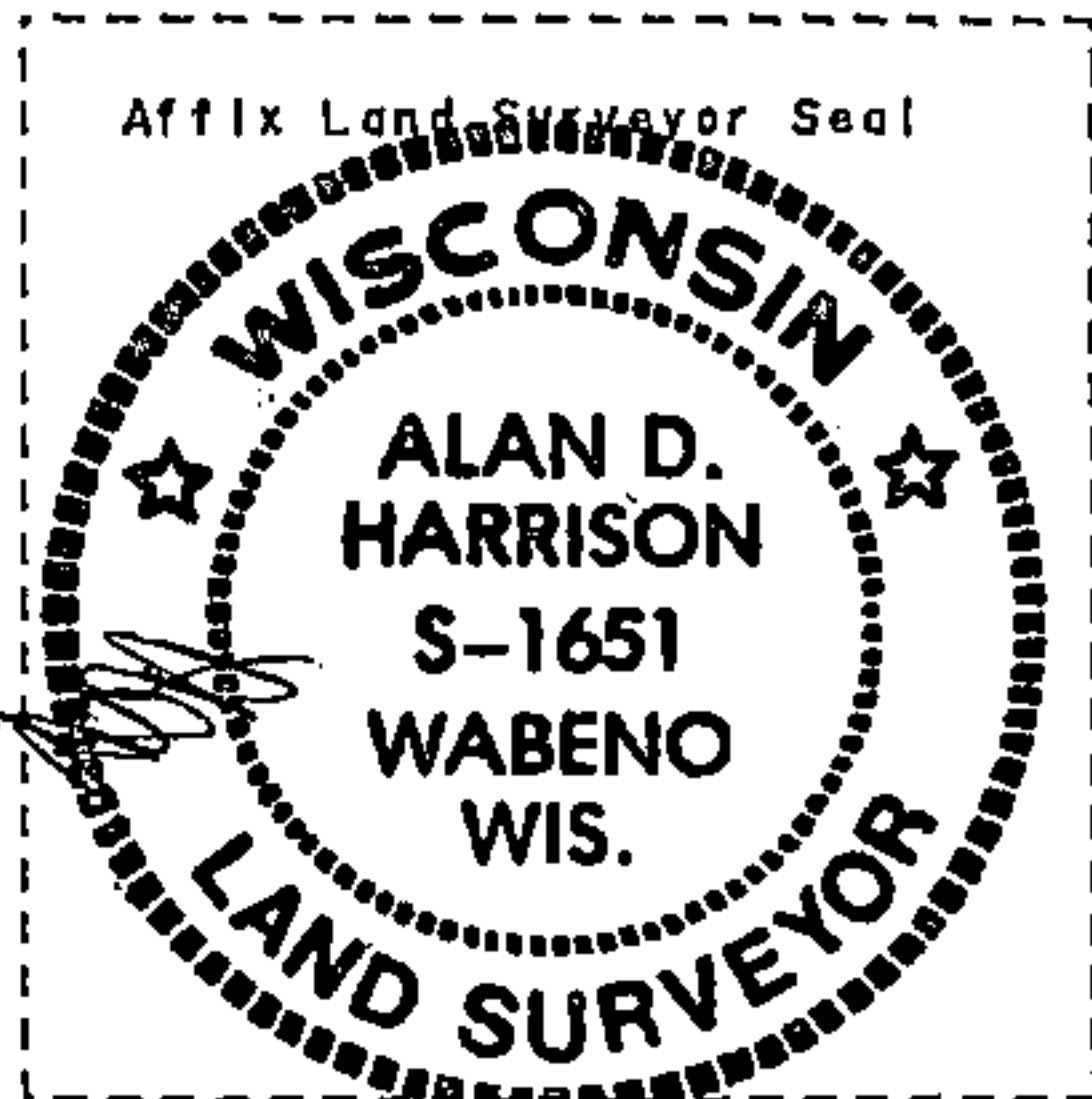

(1) I, Alan D. Harrison  
 (type or print name) certify that the corner location shown  
 on this record was determined by me or under my direction and  
 control and that this U.S. Public Land Survey Monument Record is  
 correct and complete to the best of my knowledge and belief.

*Alan D. Harrison* \_\_\_\_\_ 4/25/95  
 Signature Date

CERTIFICATE READY FOR FILING: *Tom Shecker* \_\_\_\_\_  
 District Ranger