

CERTIFIED LAND CORNER RESTORATION

State of Wisconsin

County of Forest

ss.

I Jean F. Resvick, do hereby certify that on the 3rd day of May, 1977, I found evidence of the Northeast Section corner of Section 13 Township 35 North, Range 15 East, Fourth Principal Meridian, as described hereon; and that from this evidence I established a new monument and accessories as described hereon to perpetuate the original location of this corner:



Description of original monument and accessories and subsequent restorations:

Surveyed in 1857 by Artemas Curtis  
80.0 chains North between sections 13 and 18, set post  
Yellow birch 12, S44W, 29 links  
Yellow birch 10, N68W, 40 links  
Yellow birch 9, N72E, 28 links  
Hemlock 14, S68E, 20 links  
4.00 chains South leave swamp  
15.00 chains North leave swamp  
2.00 chains West enter swamp  
8.30 chains West, stream 15 links  
15.00 chains West, leave swamp  
28.00 chains, East enter swamp  
Description of corner evidence found:

Iron pipe 12 feet North of road at 571 feet east of stream at road crossing.  
Distance North and South to quarter corners indicates that the section corner should be South and iron pipe found is a witness corner.  
Iron pipe found as North one sixteenth corner between sections 13 and 18 indicates that iron pipe was used as a witness.  
I accept iron pipe as being on line and 16 feet North of section corner.  
The evidence found is accepted over proportional measurement.  
Section corner thus located is S0°05'W, 2639.74 feet from quarter corner between Sections 7 and 12 and N0°17'W, 2631.88 feet from quarter corner between Sections 13 and 18.

Description of monument and accessories I established to perpetuate the location of this corner:

At the corner position set a 2 inch inside diameter galvanized iron pipe, 3 feet long, filled with concrete with brass cap stamped:  
T35N, R15E, S12, S7, S13, S18, 1977, S-802  
From which the following blazed and scribed bearing trees bear  
Spruce 10, S44E, 75.17 feet  
Hemlock 19, S14W, 93.22 feet  
Spruce 22, N68W, 131.84 feet  
Corner buried in road

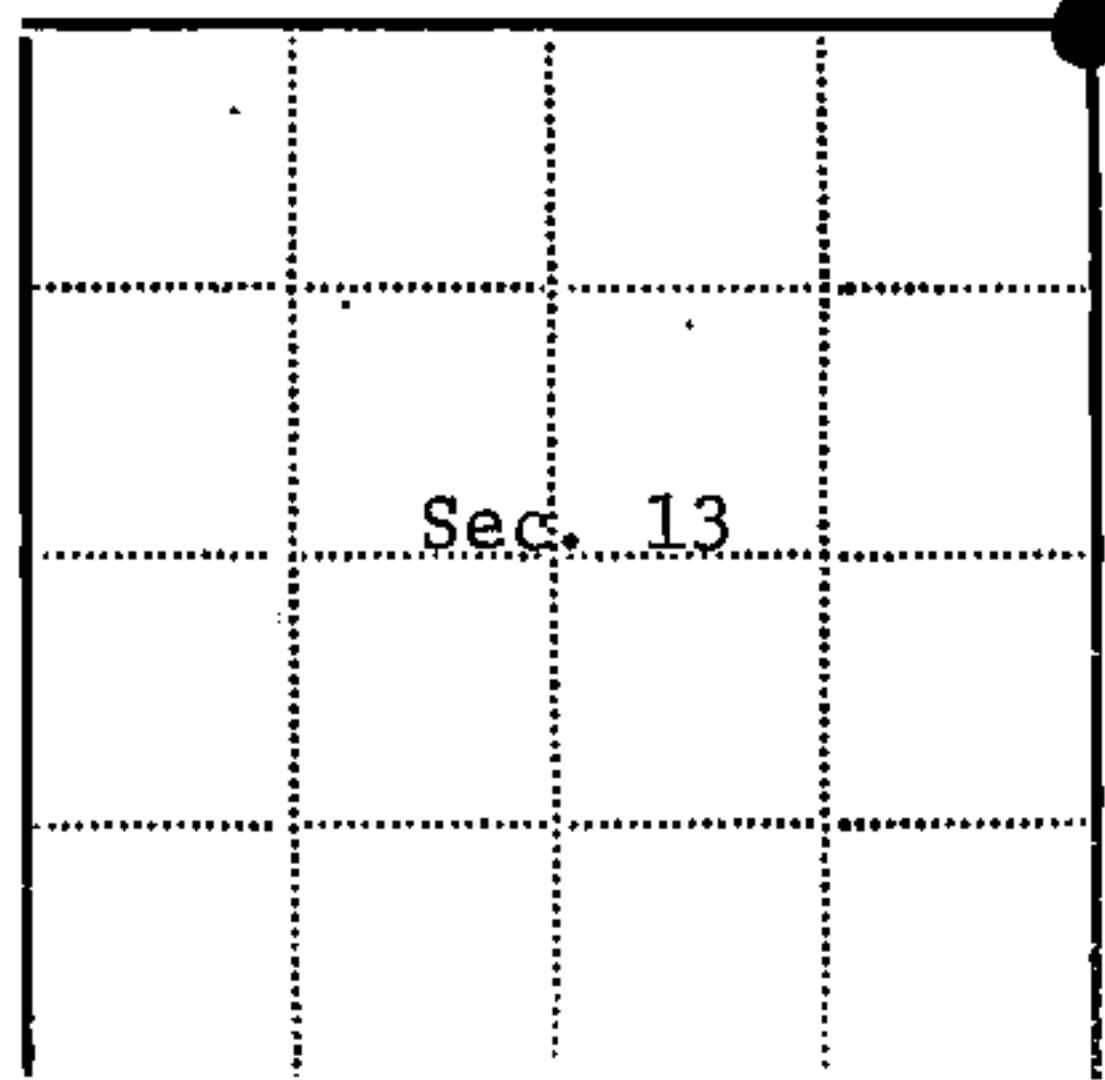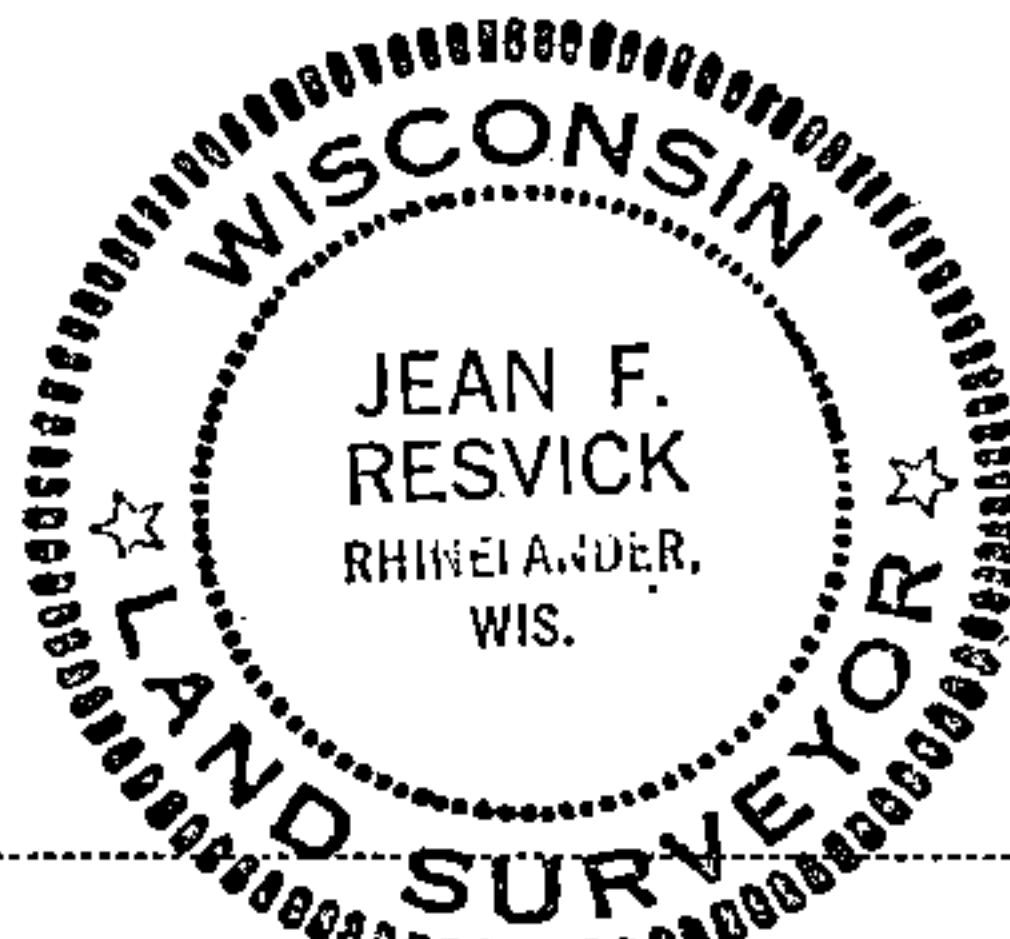

● - Corner monument restored  
□ -

Resident witnesses

Dated at Rhinelander Wisconsin, this 26 day of September 19 77.

Signature Jean F. Resvick Title Land Surveyor  
(County Surveyor, Registered Land Surveyor, or other duly authorized official)

Surveyors Registration No. S-802 DOCUMENT NUMBER 113291

Office of Register of Deeds County of Forest

I hereby certify that the within instrument was filed in this office for record on the 13th day of February 19 78, and was filed in Book No. Page No. of County Records.

Signature Eugene Stutz Title Register of Deeds

Township 35 North, Range 15 East, Section 13, Index No. J-25, Page No.