

## U. S. PUBLIC LAND SURVEY MONUMENT RECORD

INSTRUCTIONS: This record shall show the location of the corner and shall include all of the following nine elements (a through i).

- (a) Identify the corner by reference to the U.S. public land survey system.

● = Corner monument restored.


Quarter Corner to Sections 16 & 17,  
T35N, R15E, 4th P.M.

REGISTER'S OFFICE  
Forest County, Wis.

Received for record this 6<sup>th</sup> day  
of Sept. A.D., 1989 at

10:25 o'clock A.M. and recorded  
in Vol. CORNER RESTORATIONS  
page L-9

Paul Achenbrenner  
Register of Deeds

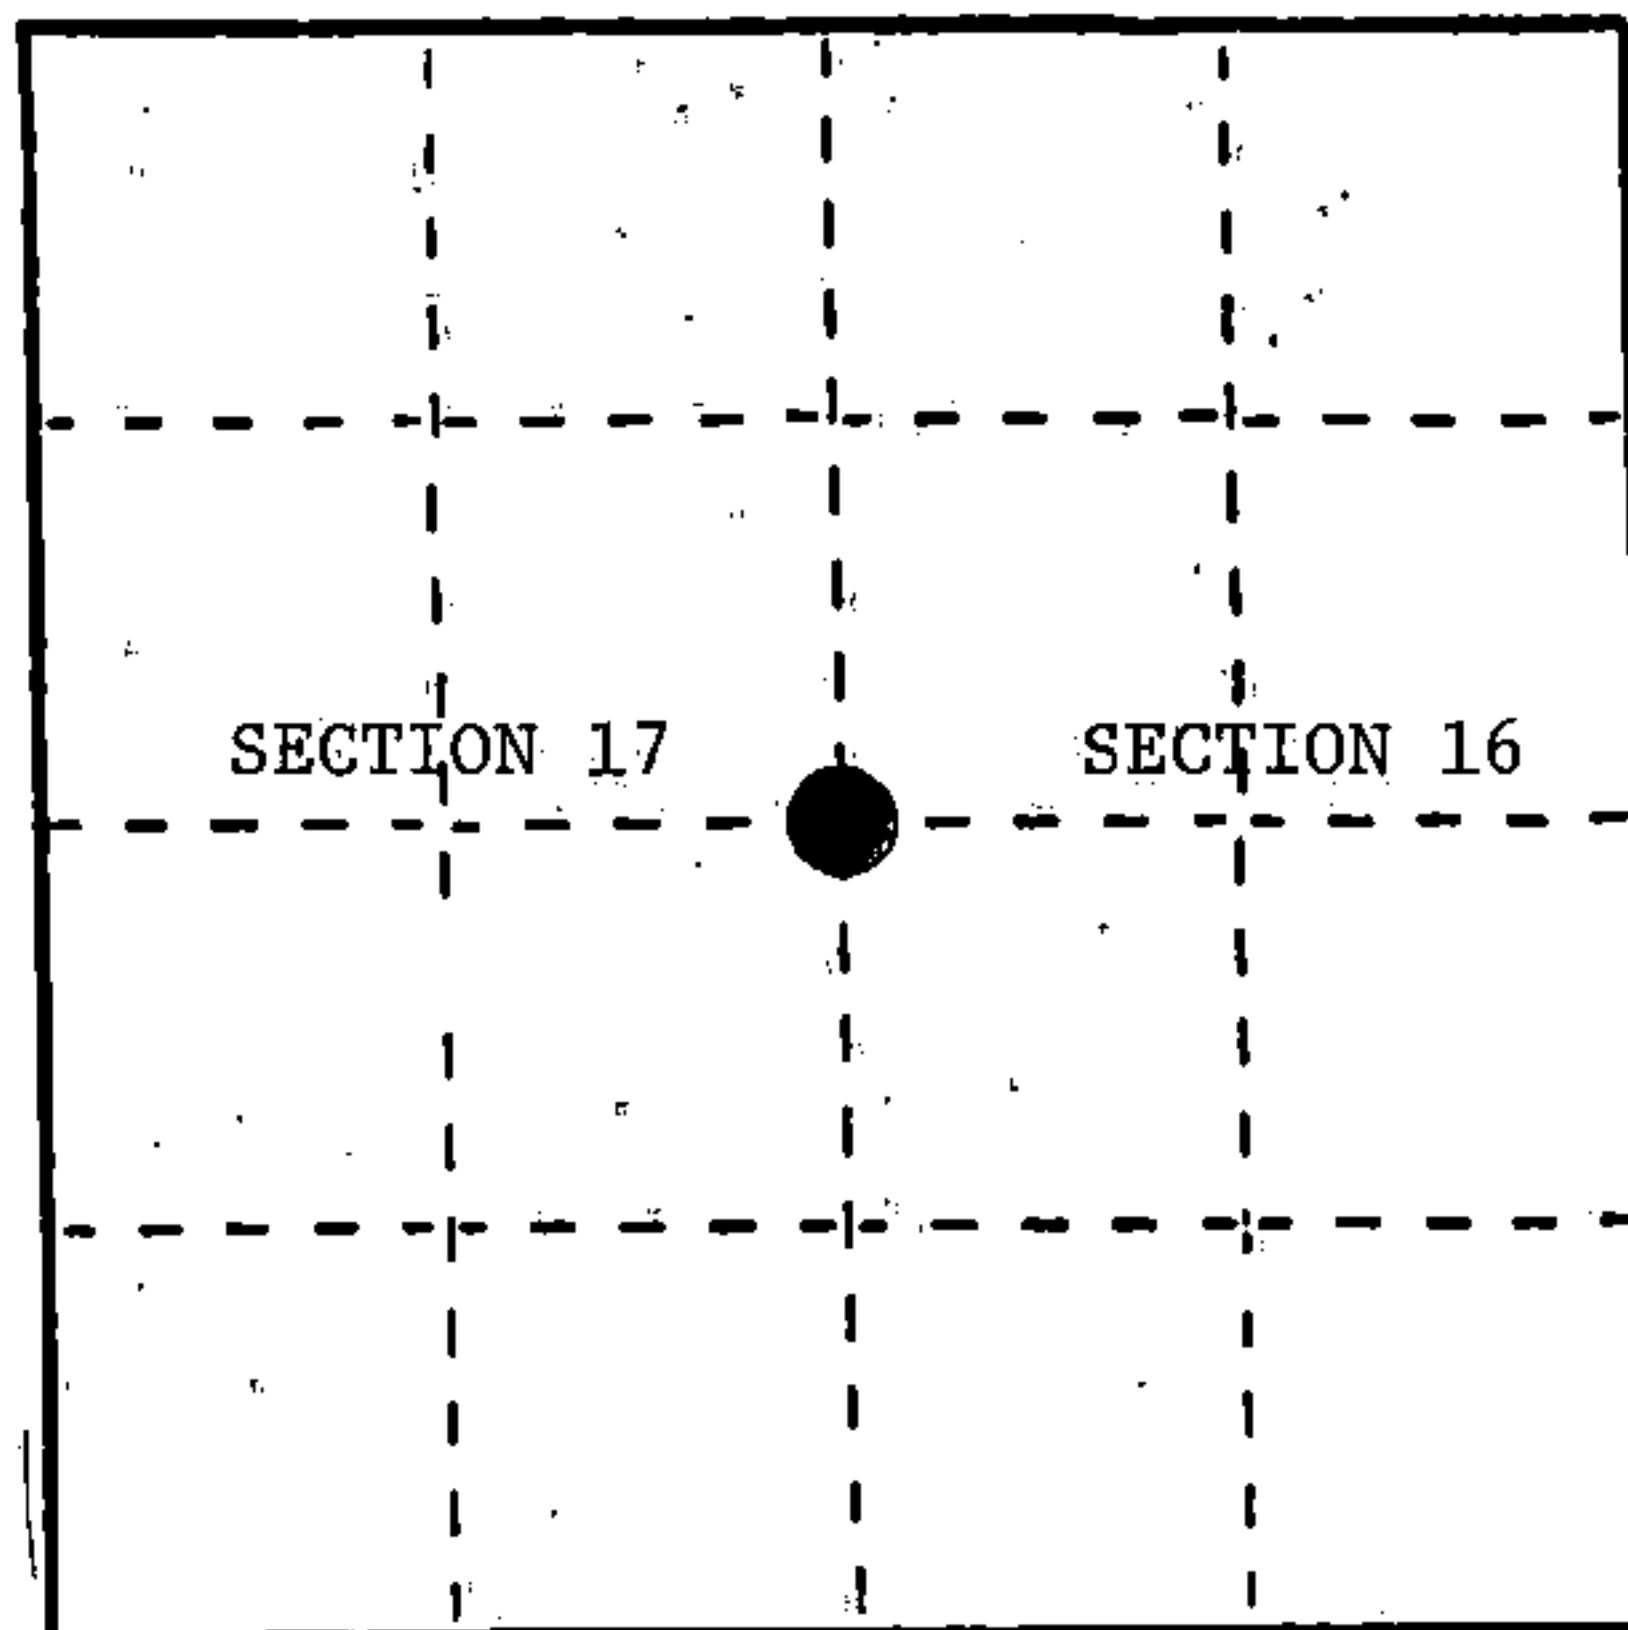

- (b) Describe any record evidence, monument evidence, occupational evidence, testimonial evidence or any other material evidence you considered, and whether the monument was found or placed.


In 1859, James McBride established this corner and set a wood post and BTs:  
8" Sugar, S22°E, 26 Links                      8" Sugar, N32°W, 9 Links

5/10/89 - No evidence remains of the original corner as I feel it falls in County Highway "T". We restore this corner on the centerline of County Highway "T" and on a line between the Section Corners north and south. A marked (painted blue) timber line runs northerly along our line.

- (c) In the plan view drawing below, provide reference ties to at least 4 witness monuments, or, if the location is within a municipality, to at least 2 witness monuments. (Witness monuments shall be made of concrete, natural stone, iron or other equally durable material.)  
Describe witness monuments.

- (d) Show a plan view drawing depicting the relevant monuments and reference ties which is sufficient in detail to enable accurate relocation of the corner monument if the corner monument is disturbed. Indicate north.

- 1) A railroad spike in surface of blacktop highway
- 2) 4" Sugar Maple, N48°E, 98.49'
- 3) 4" Yellow Birch, S46°E, 74.57'
- 4) 6" Sugar Maple, S20°W, 38.63'
- 5) 6" Basswood, N31°W, 51.25'
- 6) 2 1/2" x 36" Aluminum Monument, Witness Corner
- 7) Steel Sign Post, NE of W.C. .98'

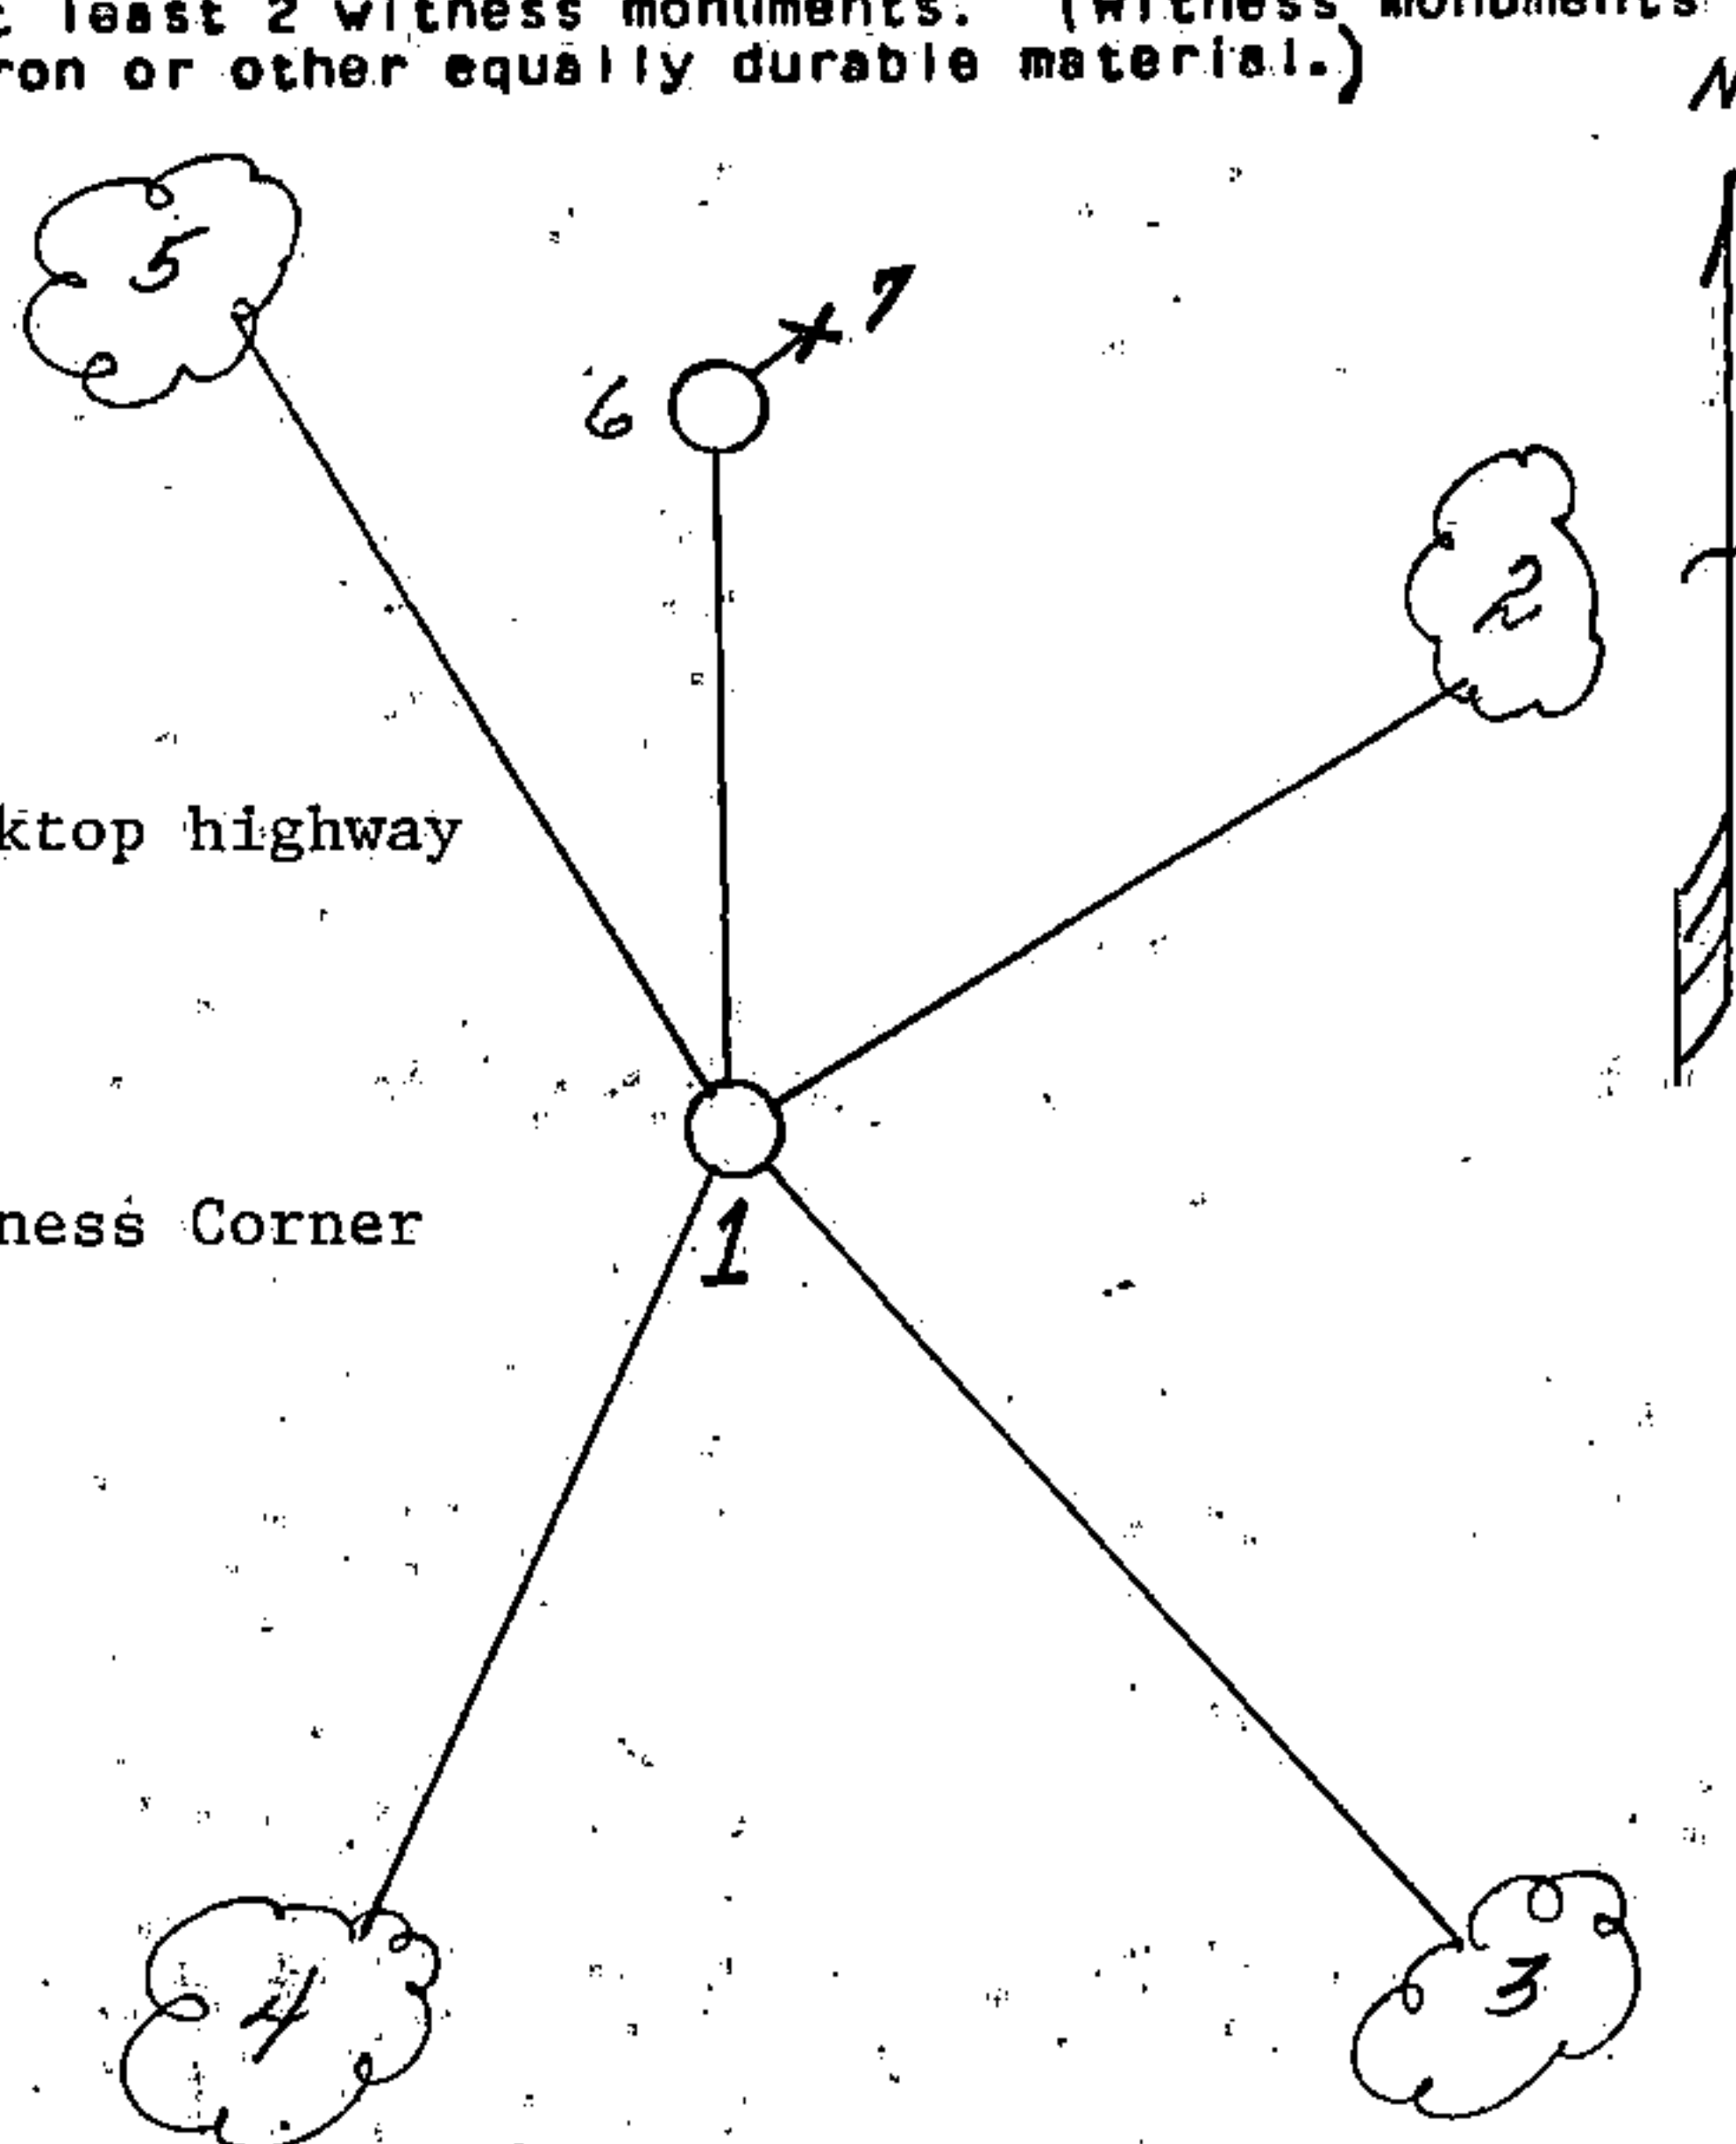

- (e) Describe any material discrepancy between the location of the corner as restored or reestablished and the location of that corner as previously restored or reestablished by distance and direction. Show the discrepancy on the plan view drawing under (d), above. Show the distances between the corner as previously restored or reestablished and (1) the corner as restored or reestablished, and (2) to at least 2 of the witness monuments shown on the drawing in (d), above.

None

- (f) Was the corner restored through acceptance of (1) an obliterated evidence location, or, (2) a found perpetuated location?

No

- (g&h) Was the corner reestablished through lost corner proportionate methods? If so, show the method, including the directions and distances to other public land survey corners used as evidence or used for proportioning in determining the corner location?

Affix Land Surveyor Seal



- (i) I, Milo E. Stefan  
(type or print name) certify that the corner location shown on this record was determined by me or under my direction and control and that this U.S. Public Land Survey Monument Record is correct and complete to the best of my knowledge and belief.

Milo E. Stefan  
Signature

6/24/89  
Date

Certificate ready for filing:

Dale B. Stange  
District Ranger