


U. S. PUBLIC LAND SURVEY MONUMENT RECORD.

INSTRUCTIONS: This record shall show the location of the corner and shall include all of the following nine elements (a through i).

(a) Identify the corner by reference to the U.S. public land survey system.

⊙ = Corner monument restored.

Section Corner to Sections 19, 20, 29 & 30, T35N, R15E, 4th P.M.

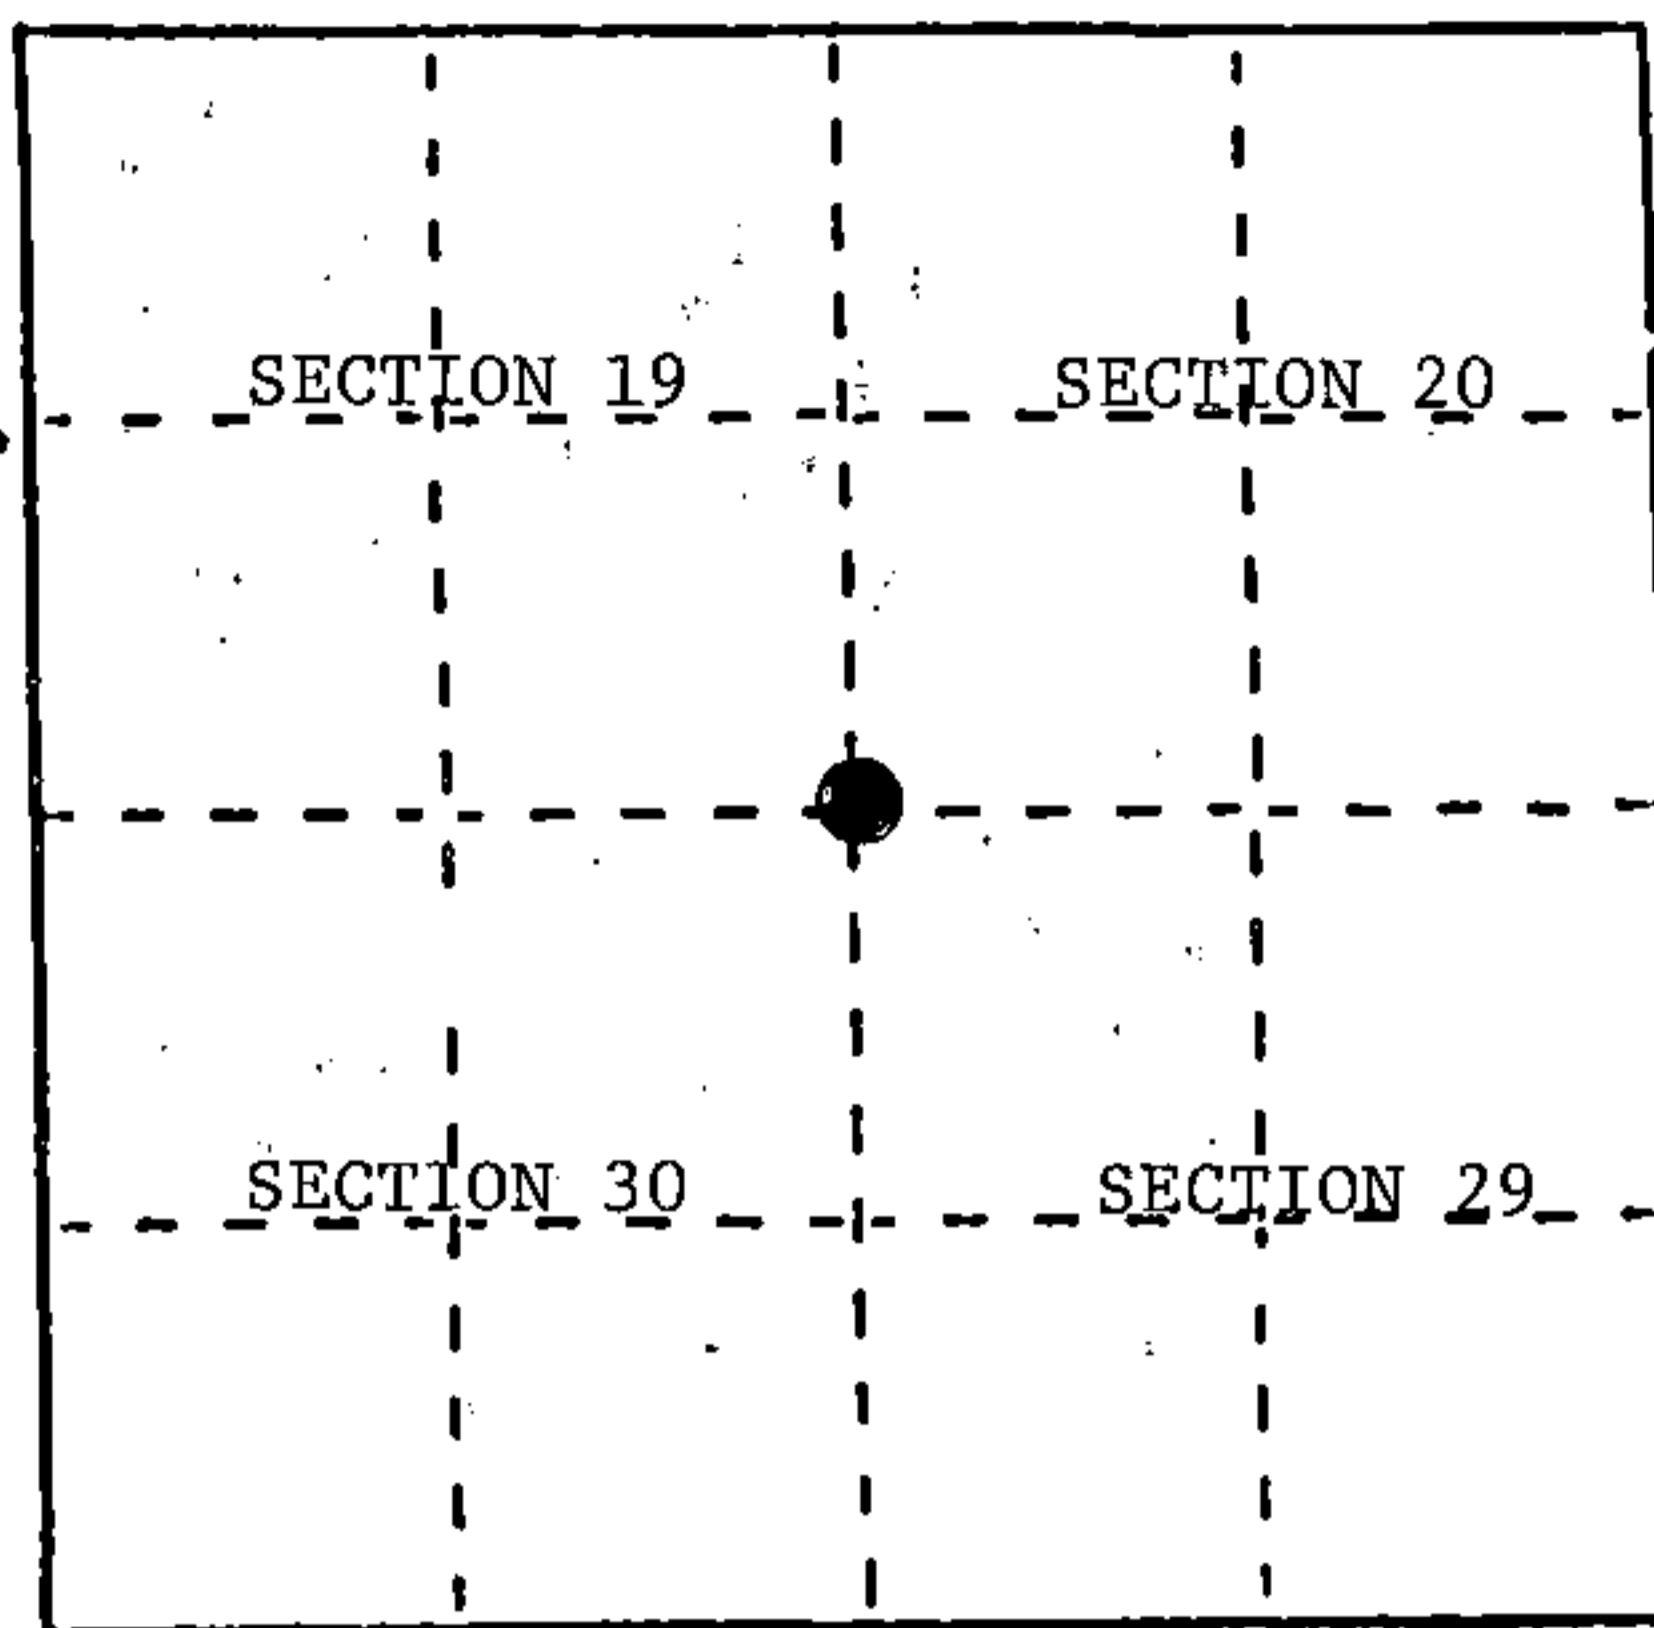

REGISTER'S OFFICE  
Forest County, Wis.  
Received for record this 16<sup>th</sup> day  
of Sept. A.D. 1989 at  
10:25 o'clock A. M. and recorded  
in Vol. CORNER RESTORATIONS  
page R-5  
*Paul Aschenbrenner*  
Register of Deeds

(b) Describe any record evidence, monument evidence, occupational evidence, testimonial evidence or any other material evidence you considered, and whether the monument was found or placed.

In 1857 James McBride established this corner and set a wood post with BTs:  
10" Hemlock, N82°E, 40 Links                      20" Basswood, S68°E, 28 Links  
16" Elm, S4°W, 55 Links                              10" Sugar, N57°W, 85 Links

6/17/09 - N. Smith found original bearing tree and made a new one, a 12" Birch, N37 1/4°W, 81 3/4 Links.

Date Unknown - Owen Smith made a bearing tree, a 24" Birch, N 1/2°E, 78 links.


11/19/81 - Milo Stefan and Alan Harrison of the Forest Service found large birch stump at N 1/2°E, 53.9 feet. We restored the corner. As the corner falls in the middle of an old road, we established two reference monuments north and south of true corner position. We also made four new bearing trees to the corner and placed a steel sign post.

6/8/89 - Forest Service crew; Young, Huettle and Downs set a 1 1/4" iron pipe in road for corner.

(c) In the plan view drawing below, provide reference ties to at least 4 witness monuments, or, if the location is within a municipality, to at least 2 witness monuments. (Witness monuments shall be made of concrete, natural stone, iron or other equally durable material.) Describe witness monuments.

(d) Show a plan view drawing depicting the relevant monuments and reference ties which is sufficient in detail to enable accurate relocation of the corner monument if the corner monument is disturbed. Indicate north.

- 1) 1 1/4" iron pipe in road below surface
- 2) Reference monument #1, north, 32.01'
- 3) Reference monument #2, south, 24.10'
- 4) 7" Sugar Maple, N59°E, 71.44'
- 5) 5" Yellow Birch, S31°E, 22.23'
- 6) 10" Black Ash, S12°W, 52.19'
- 7) 22" Hemlock, N39°W, 45.91'
- 8) Steel sign post, North of R.M. #1, 1.50'

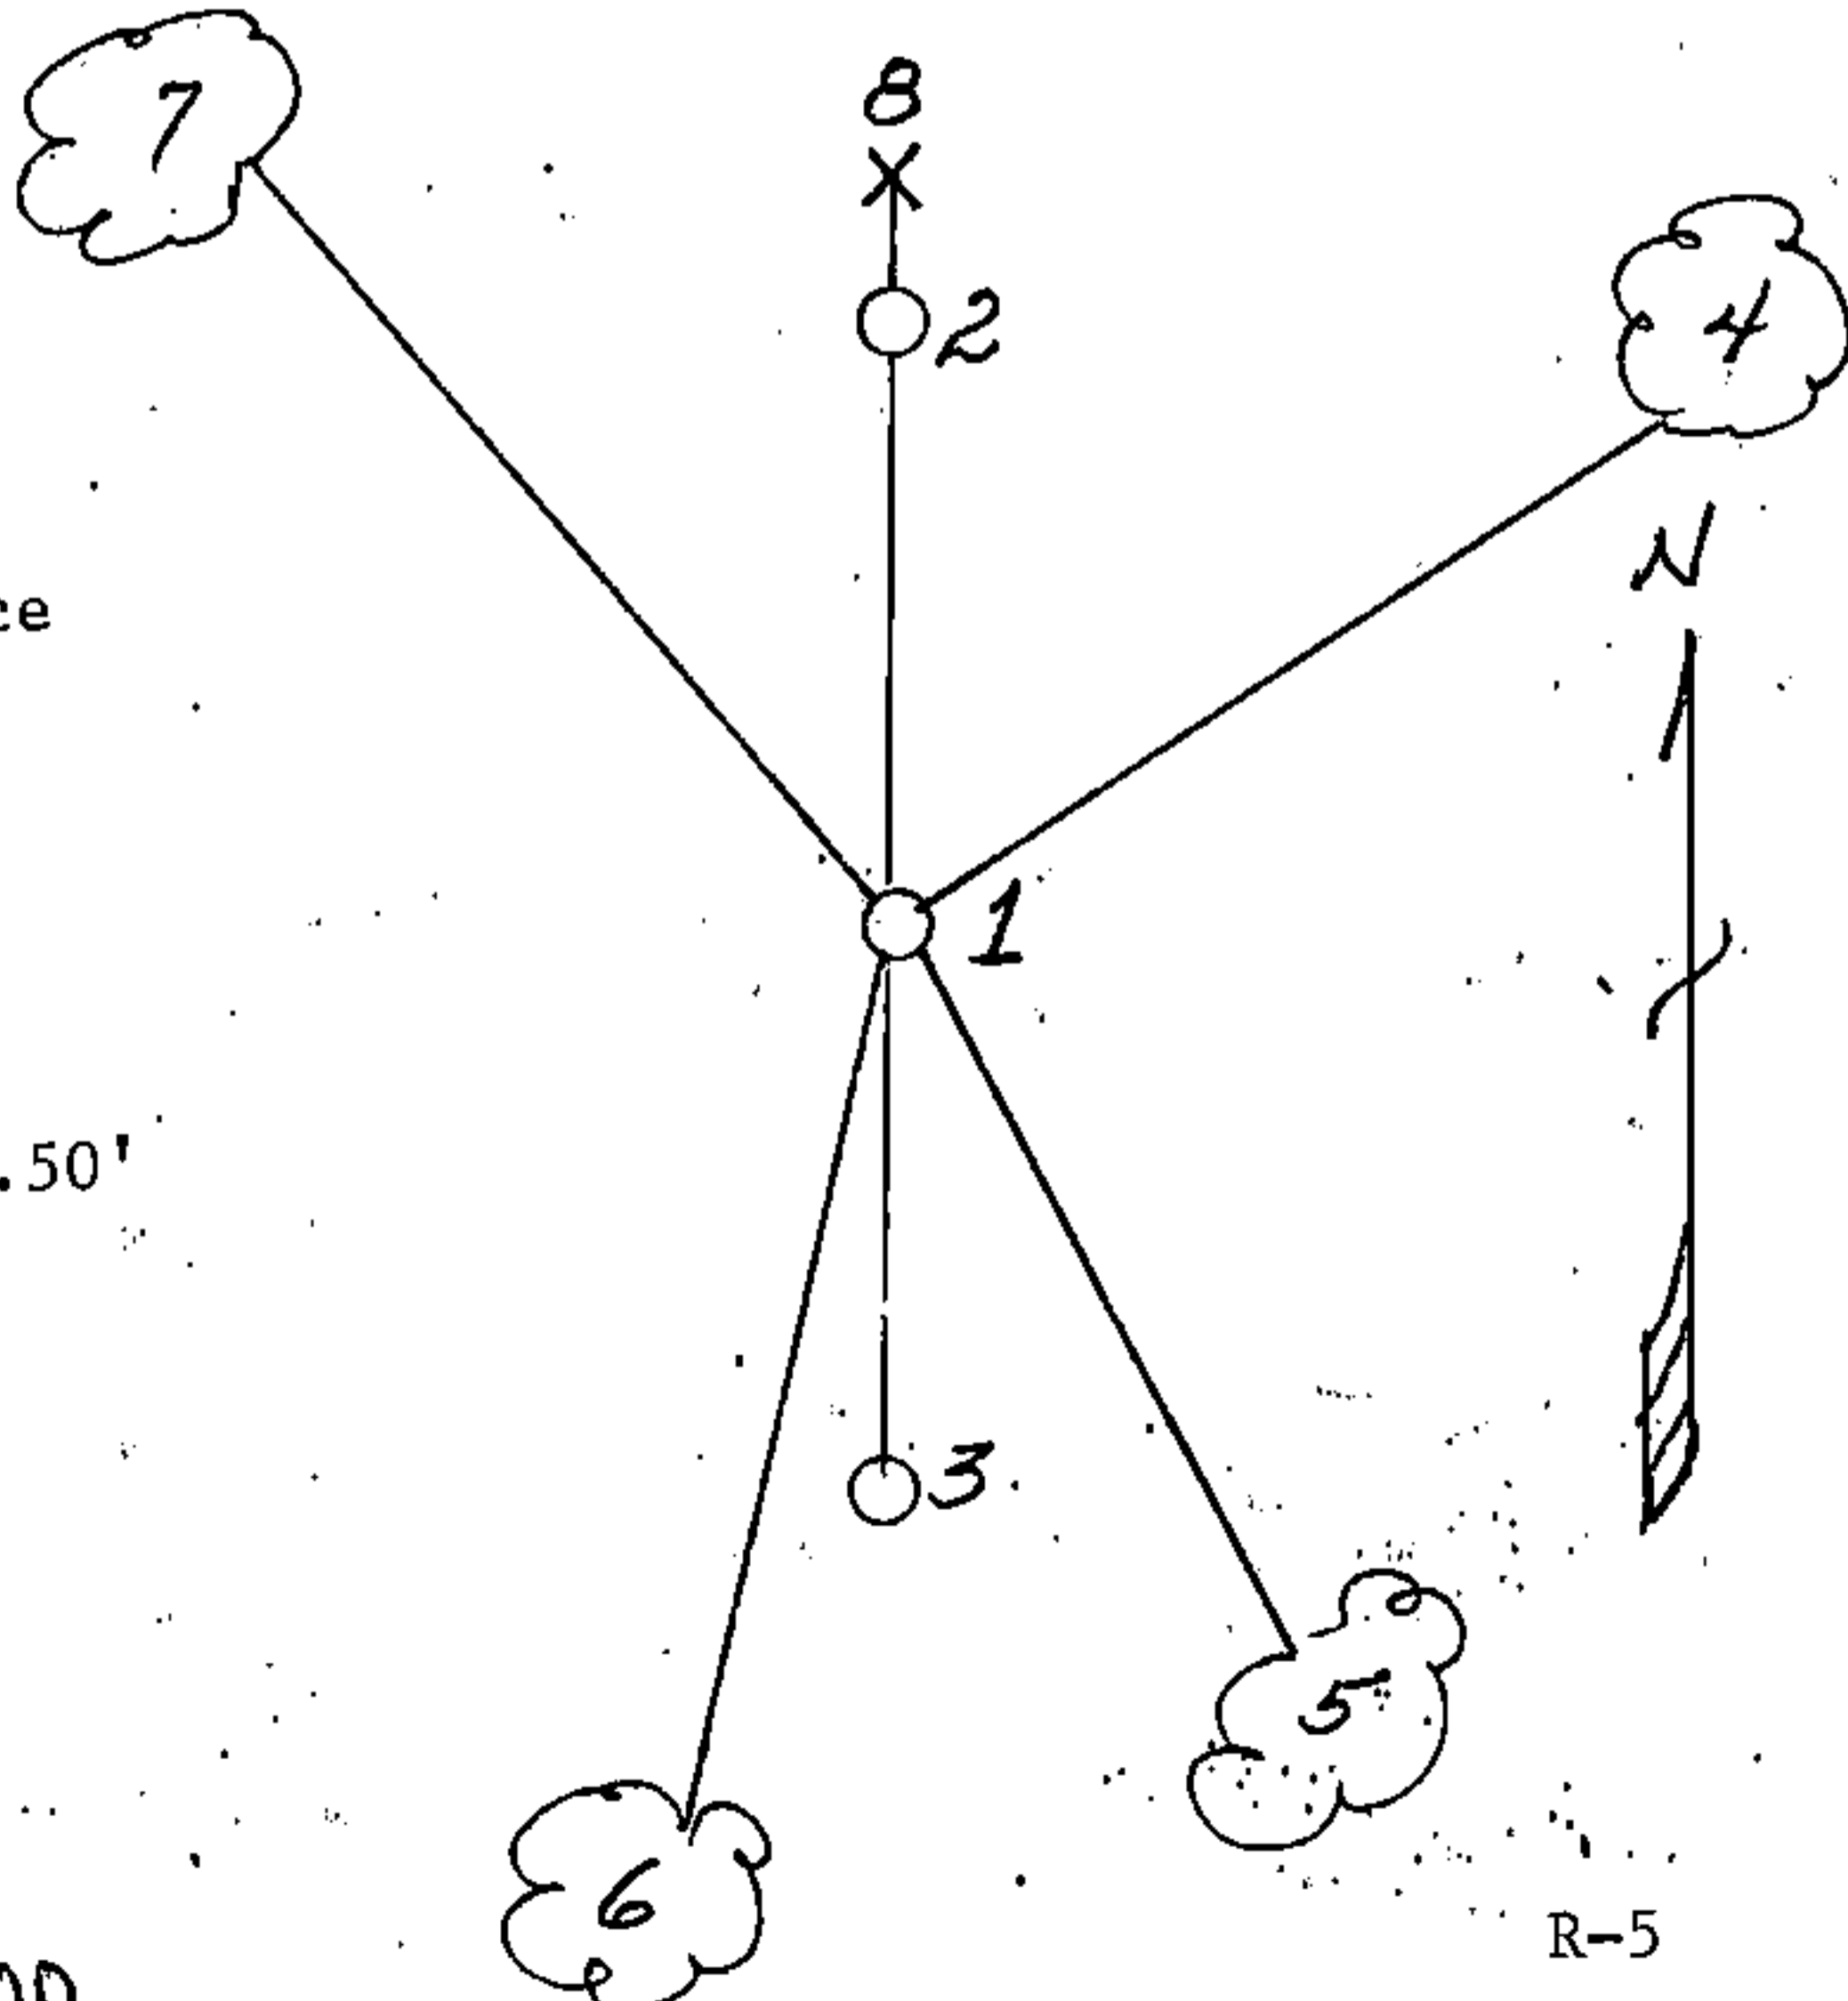

(e) Describe any material discrepancy between the location of the corner as restored or reestablished and the location of that corner as previously restored or reestablished by distance and direction. Show the discrepancy on the plan view drawing under (d), above. Show the distances between the corner as previously restored or reestablished and (1) the corner as restored or reestablished, and (2) to at least 2 of the witness monuments shown on the drawing in (d), above.

None

(f) Was the corner restored through acceptance of (1) an obliterated evidence location, or, (2) a found perpetuated location?

an obliterated location

(g) Was the corner reestablished through lost corner proportionate methods? If so, show the method, including the directions and distances to other public land survey corners used as evidence or used for proportioning in determining the corner location?

Affix Land Surveyor Seal



(1) I, Milo E. Stefan

(type or print name) certify that the corner location shown on this record was determined by me or under my direction and control and that this U.S. Public Land Survey Monument Record is correct and complete to the best of my knowledge and belief.

Milo E. Stefan  
Signature

July 8, 1989  
Date

CERTIFICATE READY FOR FILING: Dale B. Staeger

District Ranger