


U. S. PUBLIC LAND SURVEY MONUMENT RECORD

INSTRUCTIONS:

This record shall show the location of the corner and shall include all of the following nine elements (a through i).

- (a) Identify the corner by reference to the U.S. public land survey system.
- = Corner monument restored.

Corner common to Sections 20, 21, 28 & 29, T35N, R15E, 4th P.M., Forest County, WI.

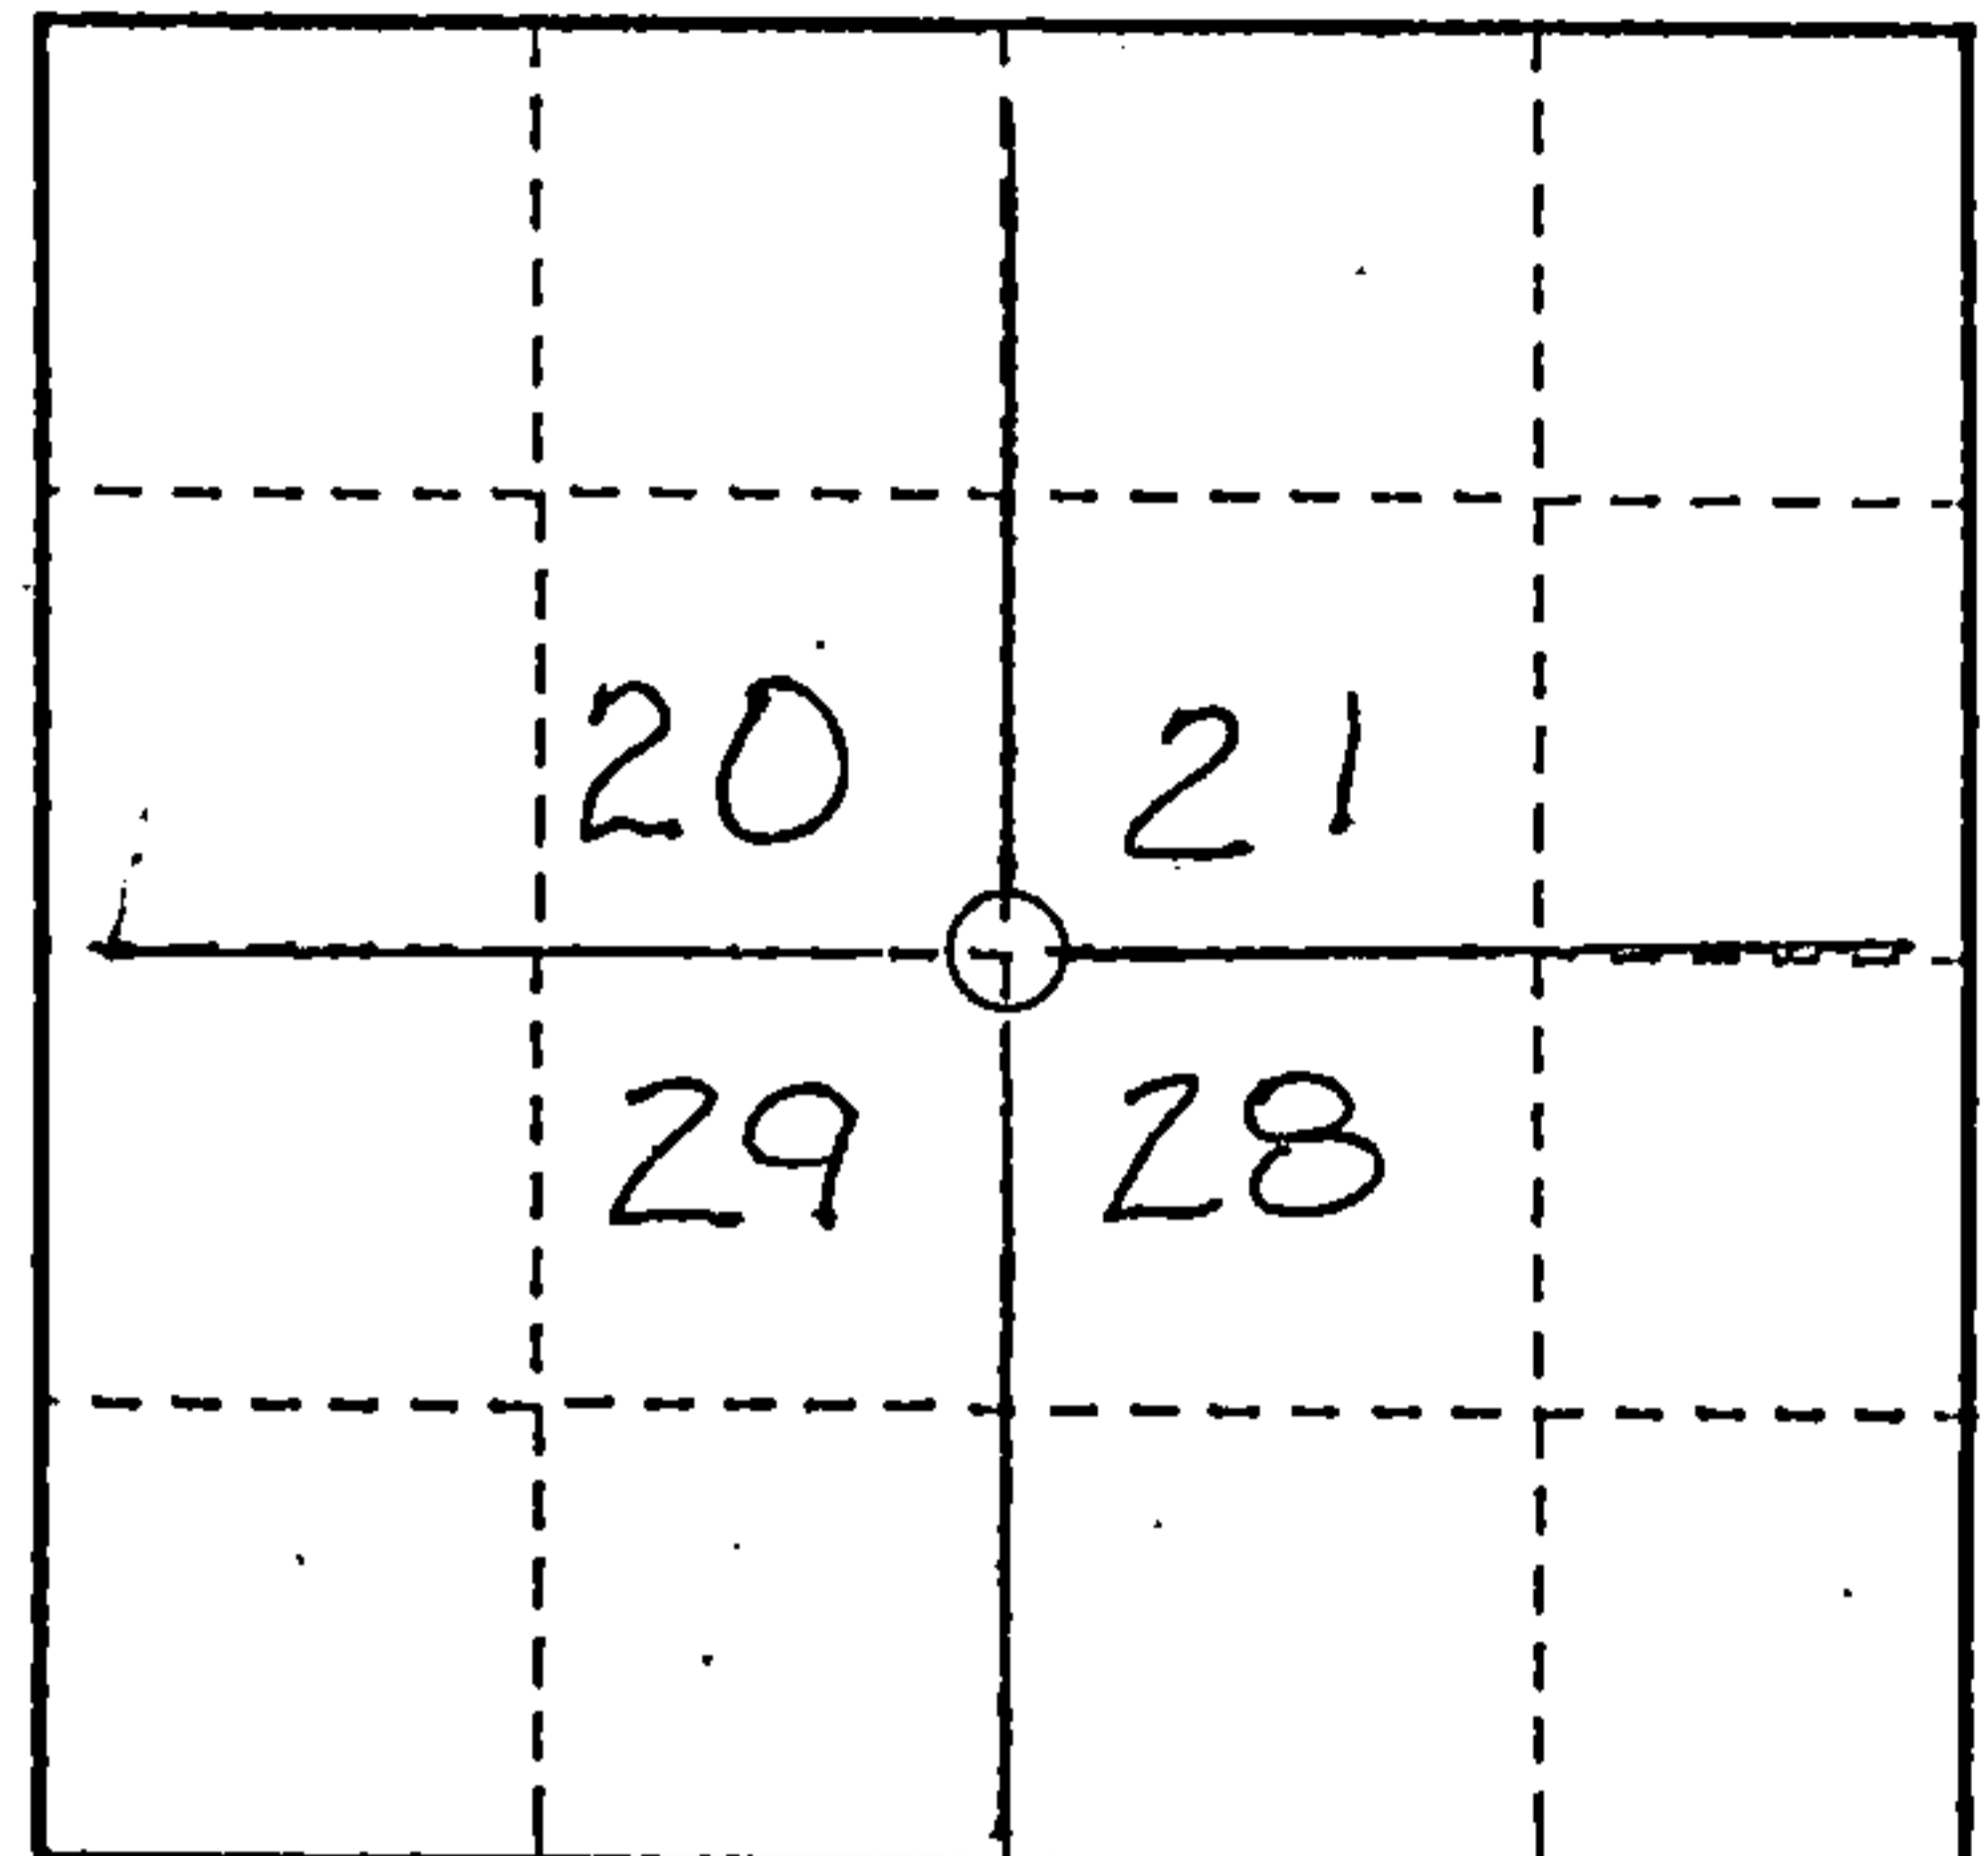

- (b) Describe any record evidence, monument evidence, occupational evidence, testimonial evidence or any other material evidence you considered, and whether the monument was found or placed.

Original survey in 1859 by James McBride, Deputy Surveyor.


Set wood post at 80 chains from which he established:

- Hemlock, 36" - N36°W - 41 links (27.06 feet)
- Hemlock, 20" - N31°E - 16 links (10.56 feet)
- Hemlock, 12" - S16°E - 61 links (40.26 feet)
- Hemlock, 14" - S85°W - 40 links (26.40 feet)

- In 1981, Milo Stefan, RLS 1558, found a fence corner intersection running East and North from which he found stump holes at record bearing and distance from three of the original bearing trees. He set a 2" diameter x 36" long aluminum monument with a stamped cap at the fence corner.
- In 1993, I found the 2" x 36" aluminum monument set by Stefan in good condition and established references as noted below.

- (c) In the plan view drawing below, provide reference ties to at least 4 witness monuments, or, if the location is within a municipality, to at least 2 witness monuments. (witness monuments shall be made of concrete, natural stone, iron or other equally durable material.)

- (d) Show a plan view drawing depicting the relevant monuments and reference ties which is sufficient in detail to enable accurate relocation of the corner monument if the corner monument is disturbed. Indicate north.

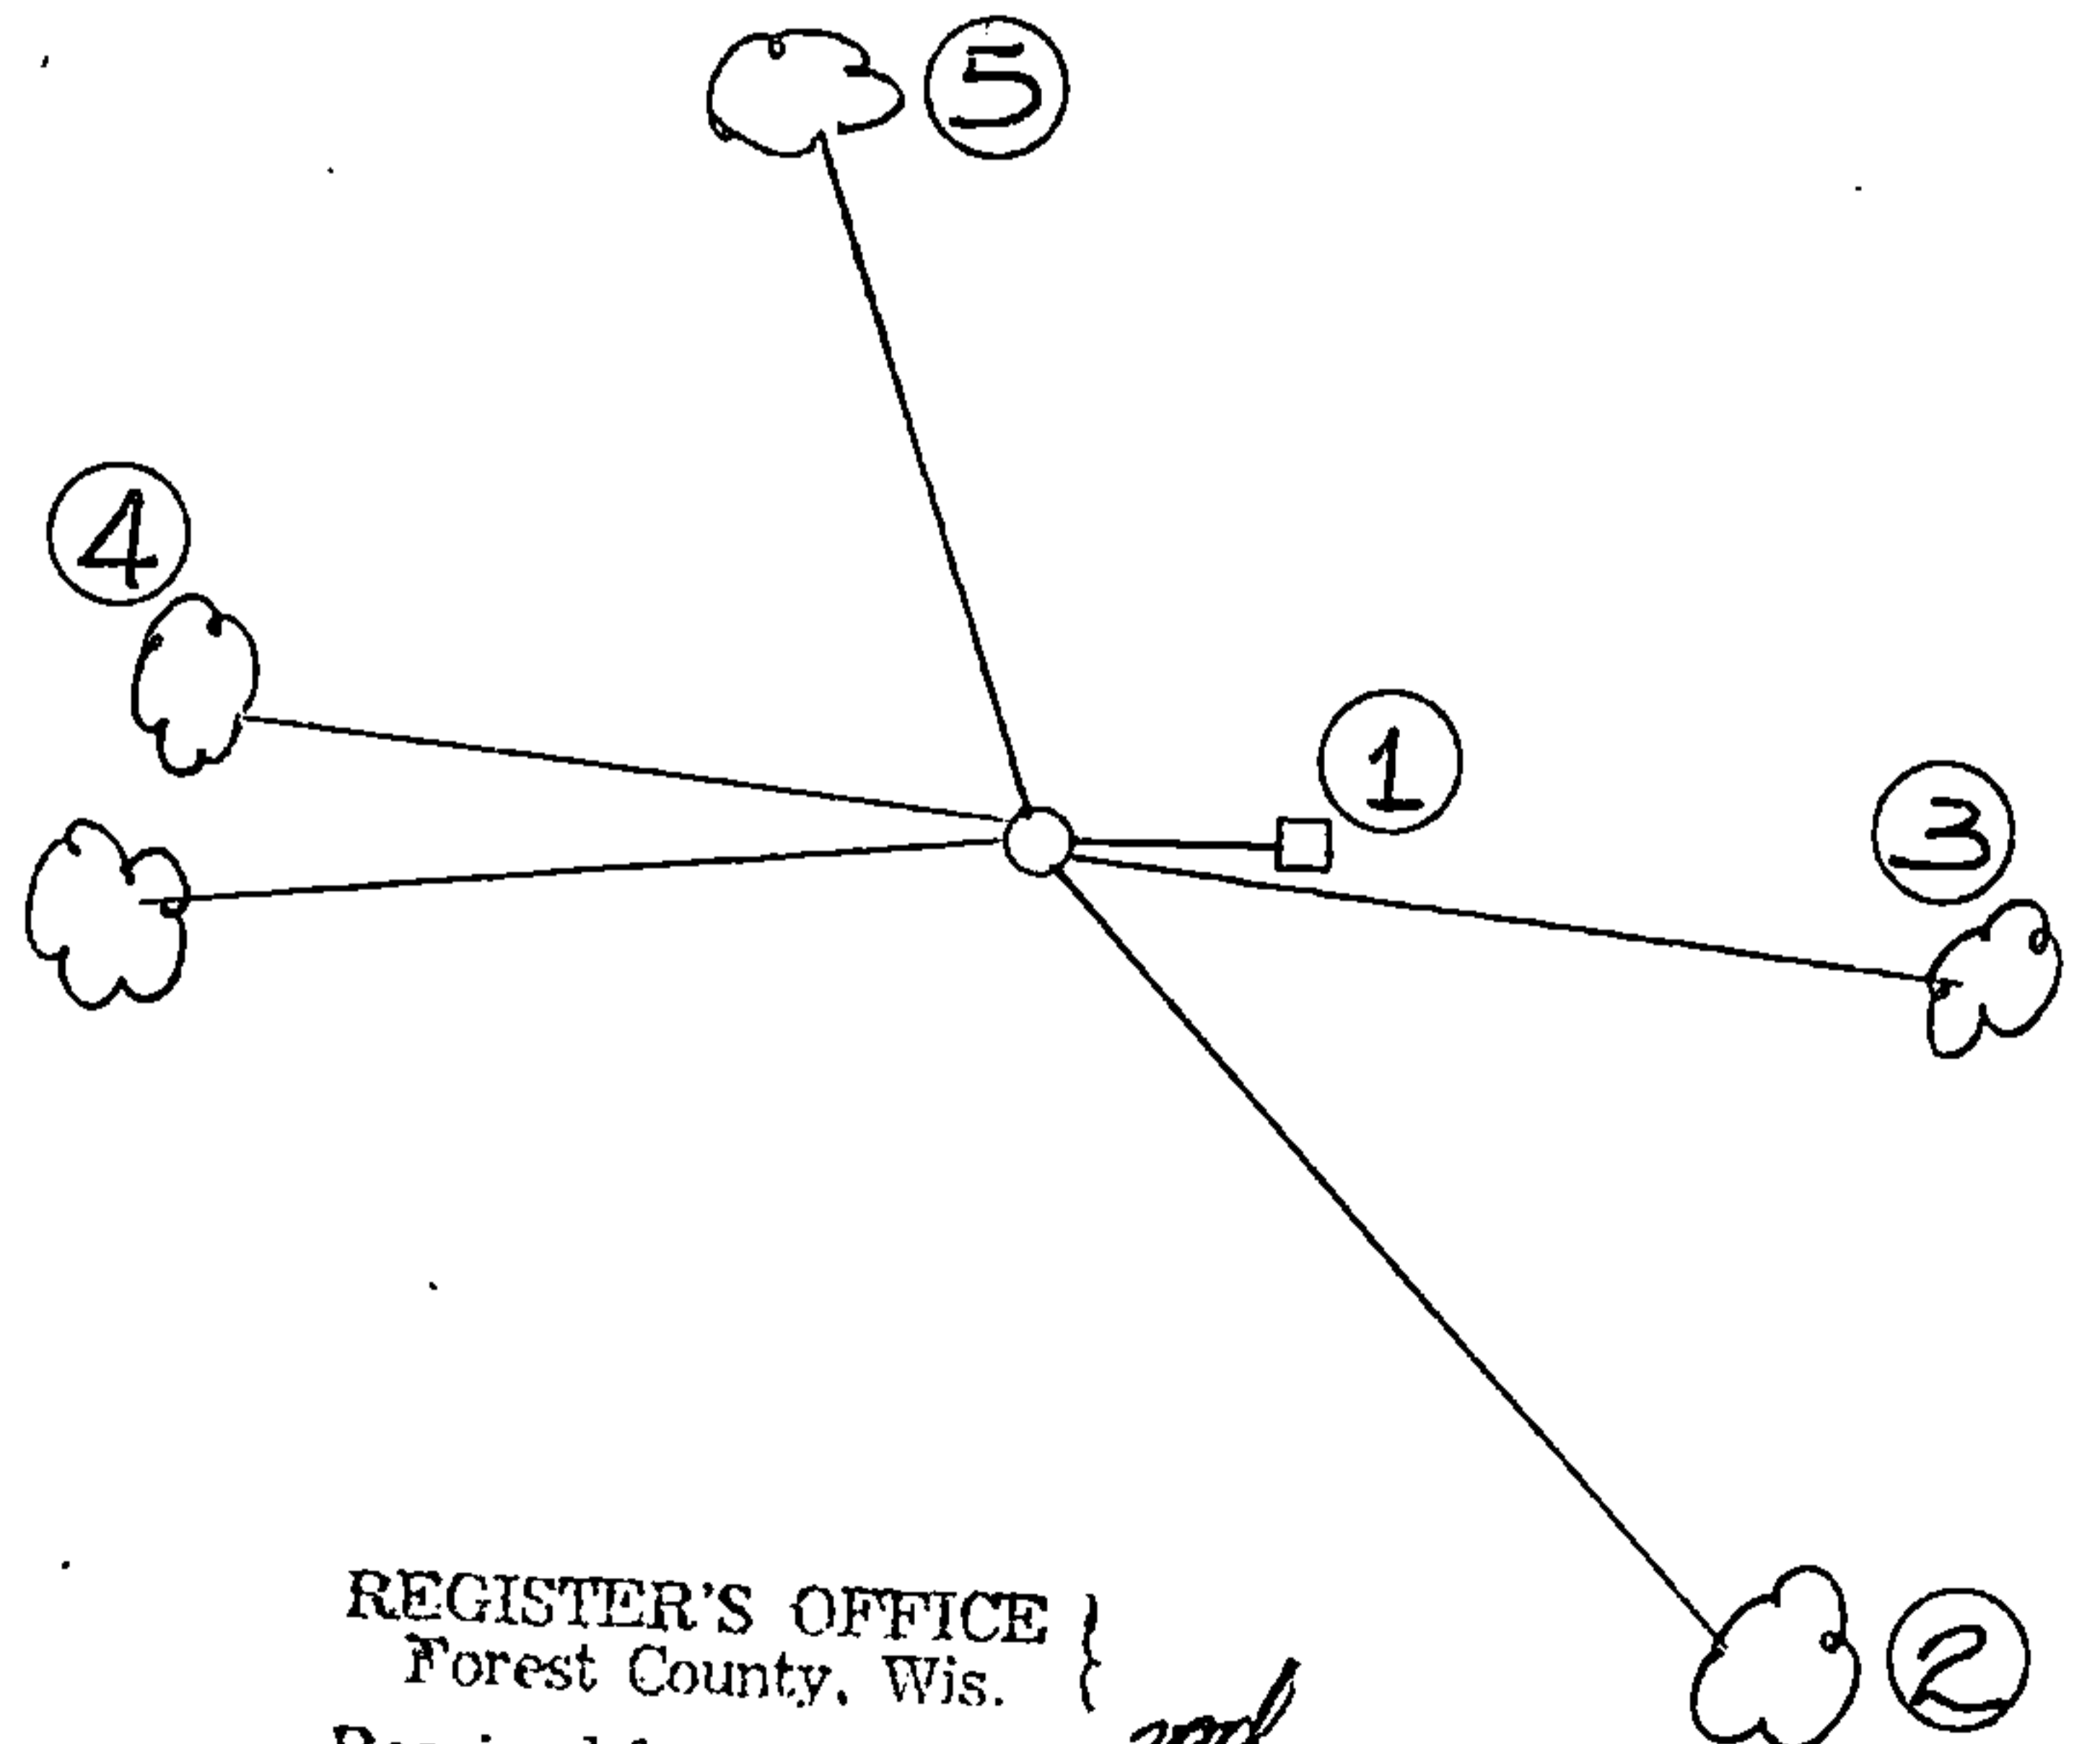

Found monument noted above.

- 1- Steel Sign Post - East - 1.14 feet
- 2- Sugar, 14" - S45°E - 54.14 feet
- 3- Basswood, 11" - S85°E - 32.22 feet
- 4- Sugar, 14" - N84°W - 29.86 feet
- 5- Sugar, 16" - N23°W - 25.70 feet

REGISTER'S OFFICE }  
 Forest County, Wis. }  
 Received for record this 2nd day  
 of June A.D. 1993 at  
1:00 o'clock P. M. and recorded  
 in Vol. Corner Restoration  
 page R-9  
*Paul C. H. Deputy*  
 Register of Deeds

